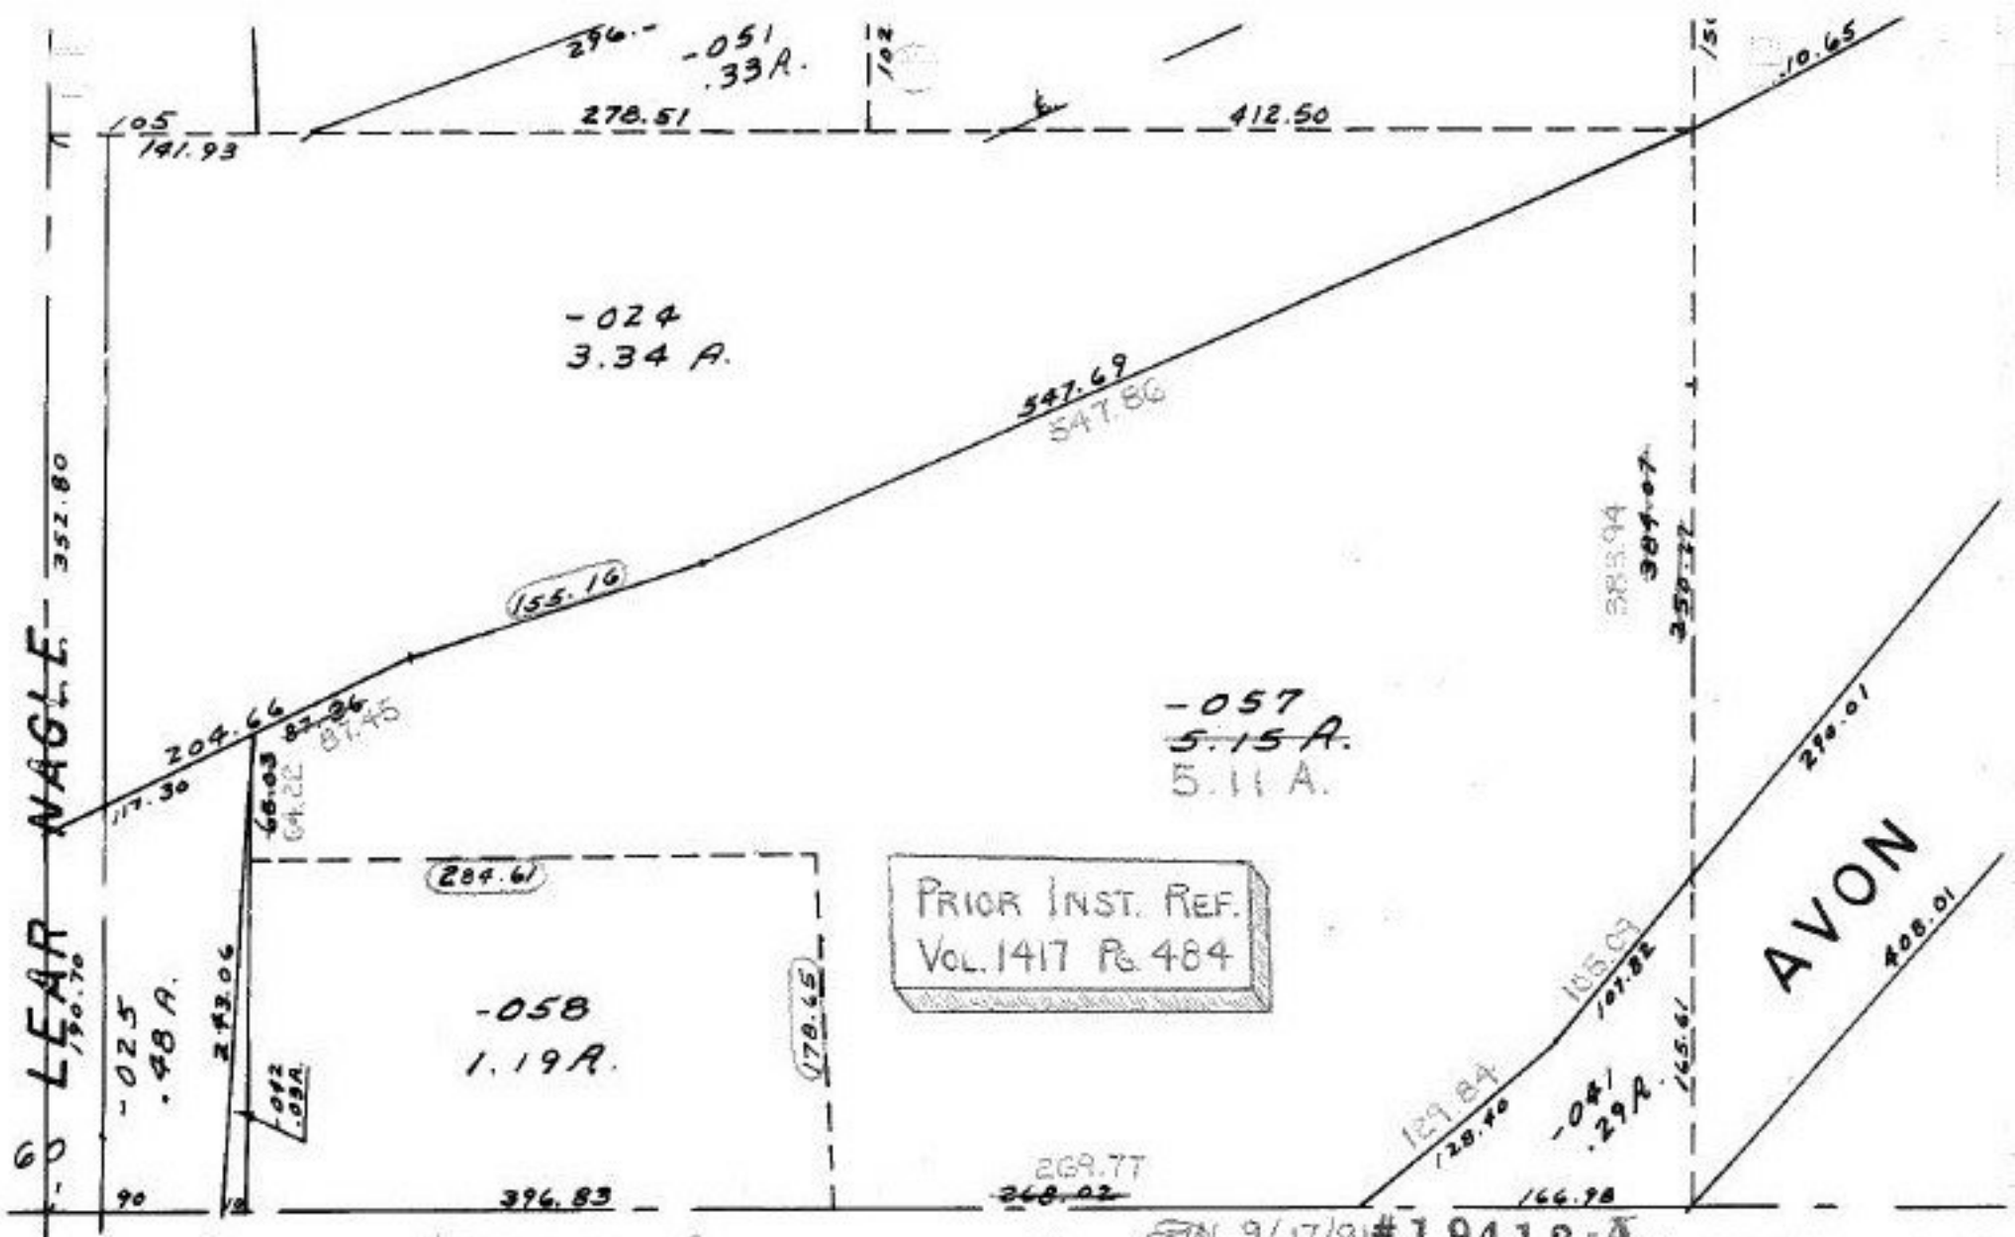

ACREAGE CORRECTION PER
SURVEY BY: HENRY G. REITZ
CLOSURE: 1:227,272

APPROVED
LORAIN CO.
MAP DEPT.
DATE 6/28/91
PAGE 4-00-028-E
BY T. HOLLIS
VOID AFTER 19412-A

ACREAGE
CORRECTION