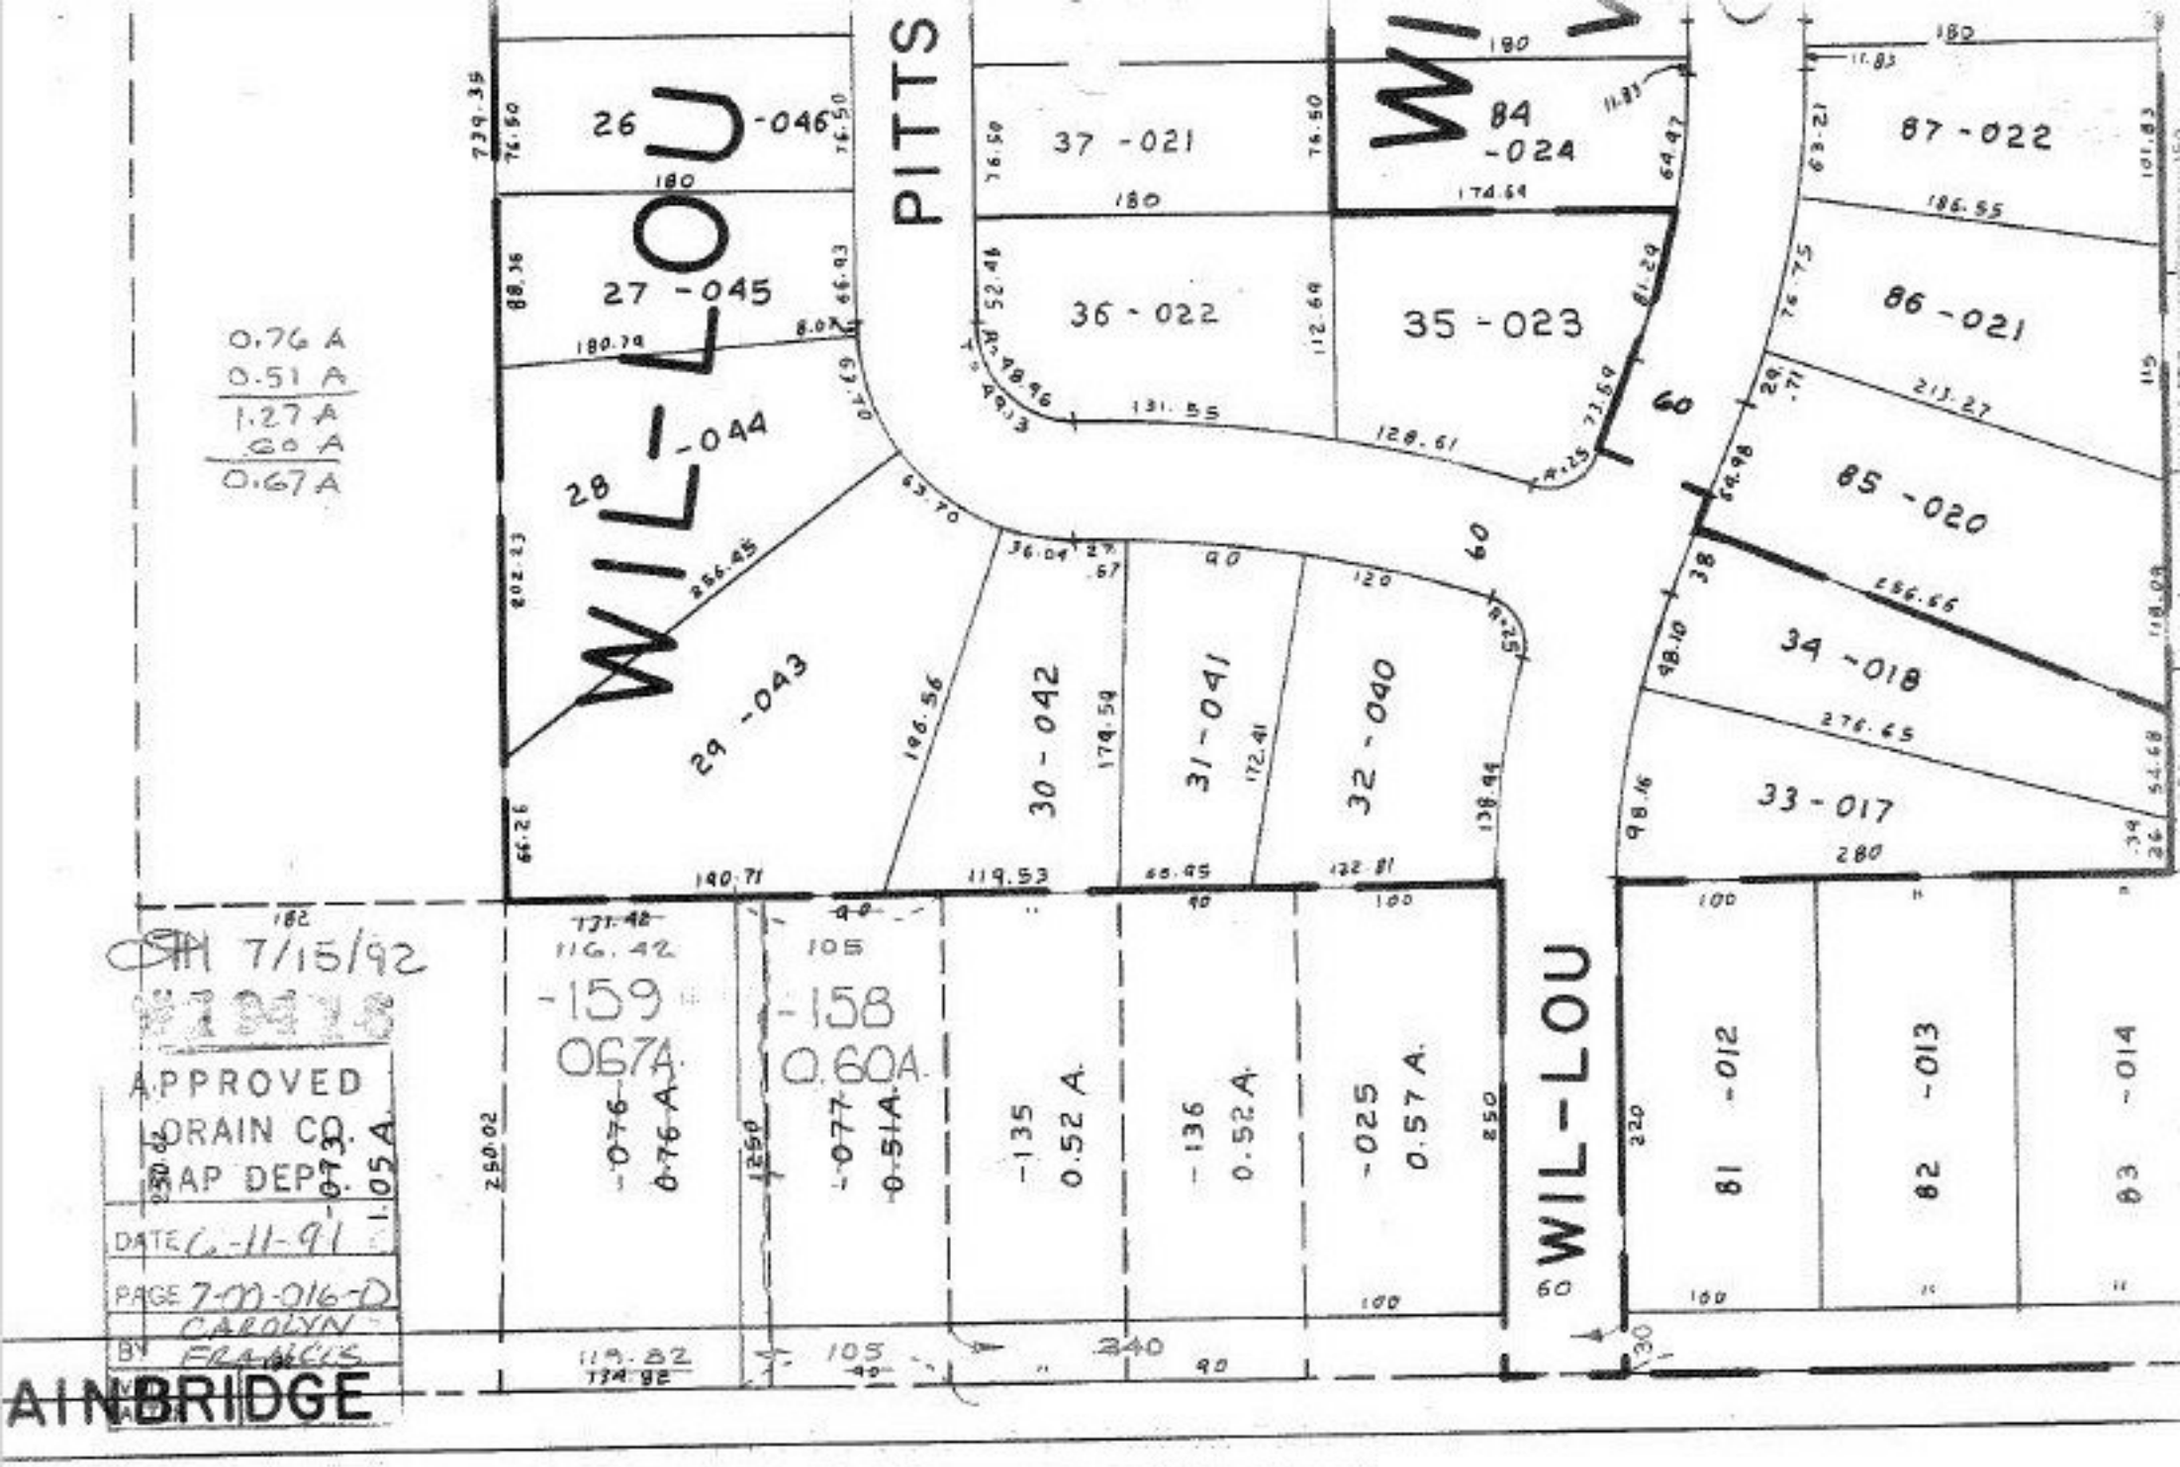

07-00-016-104- PRIOR INST. 969/409 O.R. 353/288
SURVEYED BY: MARTINI HAPONEK & ASSOC., 1983
C=1: INF.

SEE 7-00-015-B