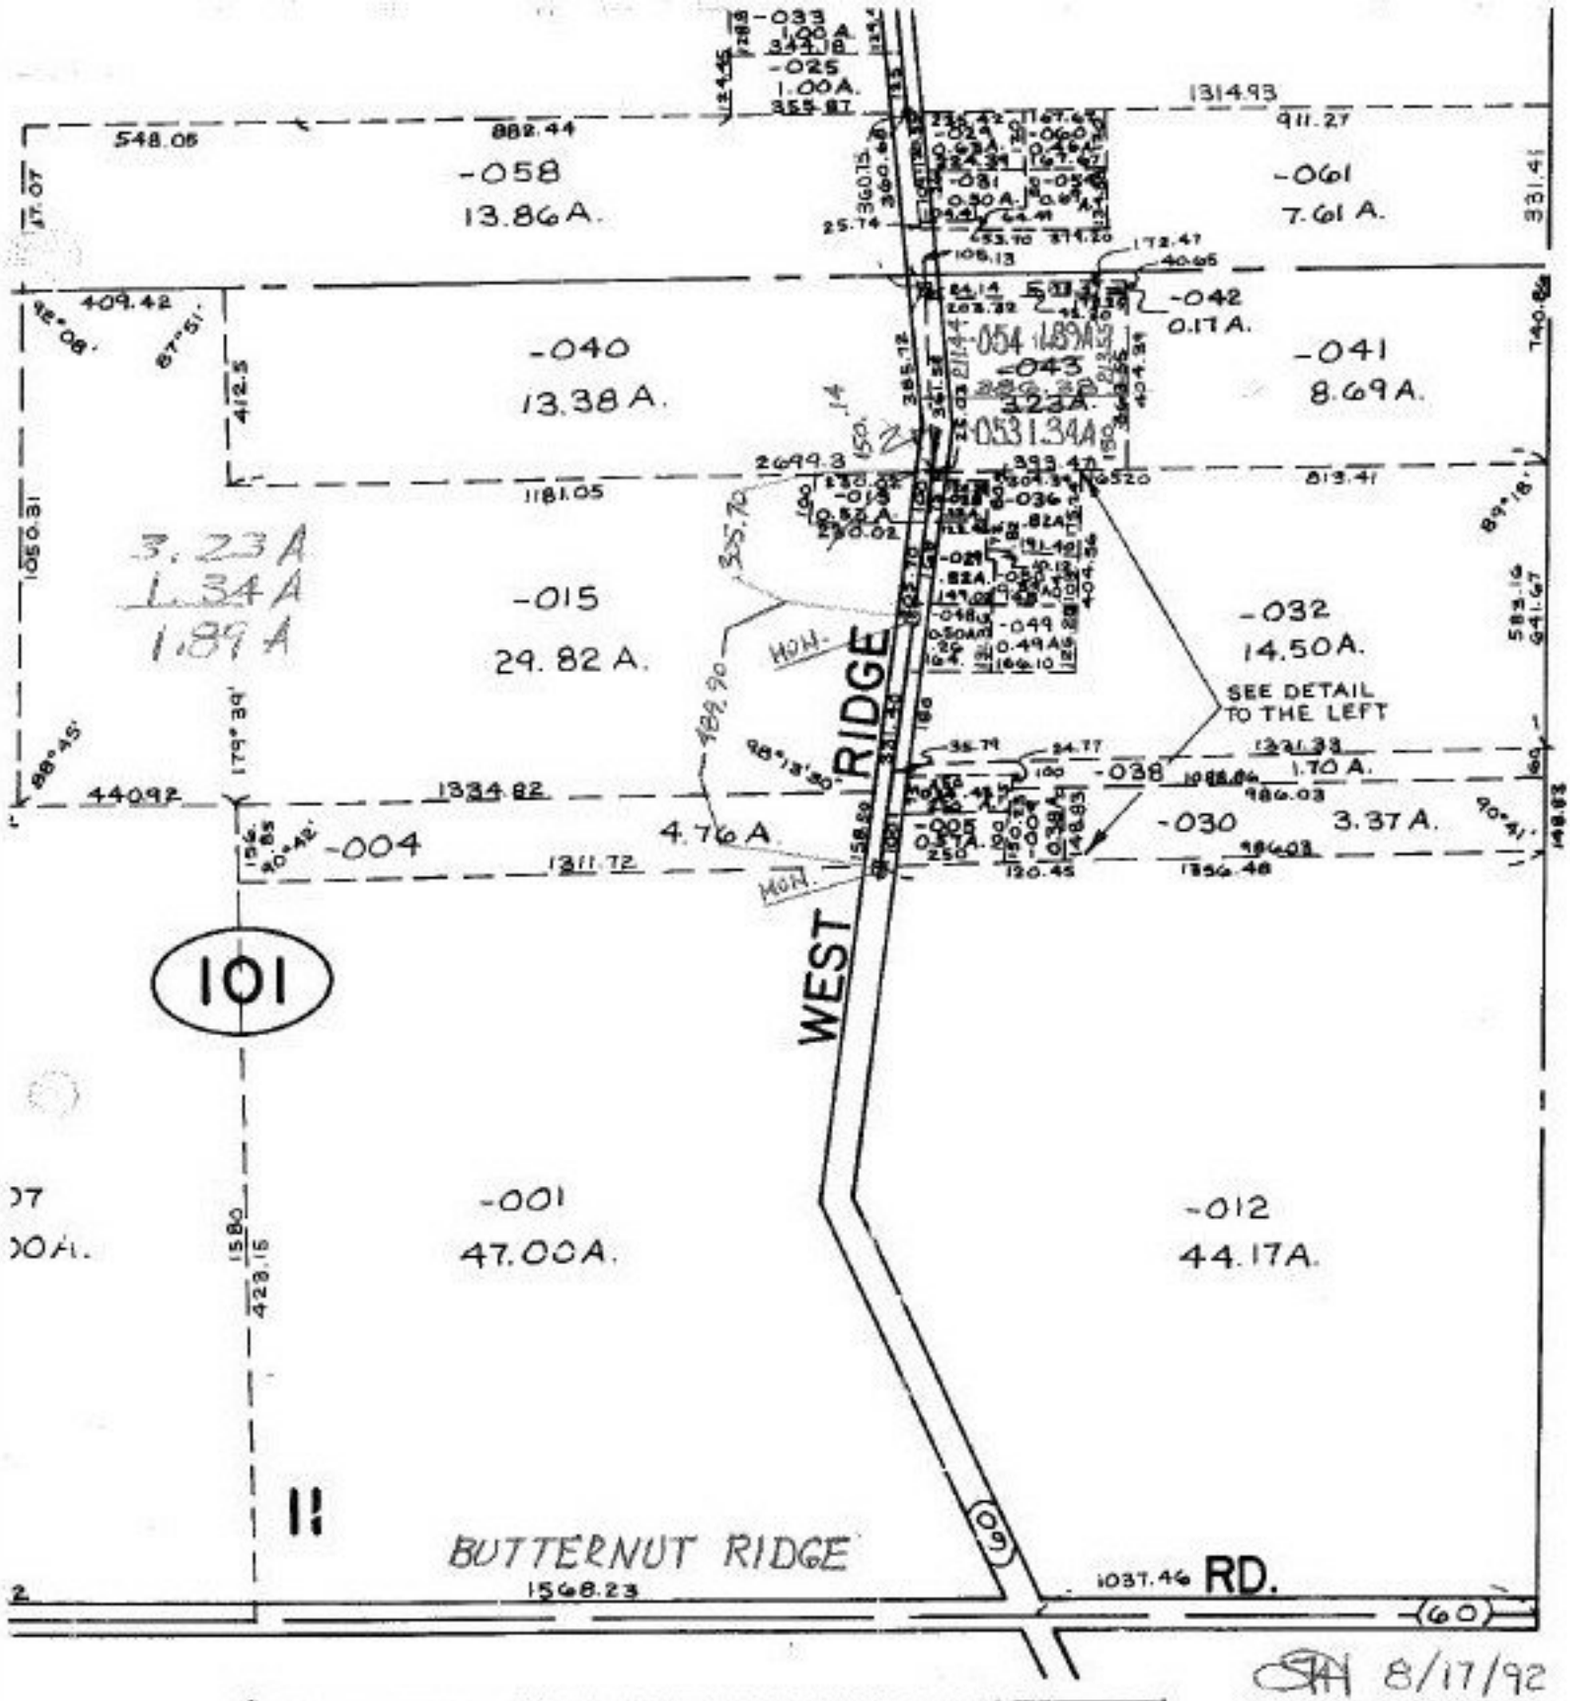

10-00-011-101- PRIOR INST. 1018/346
SURVEYED BY: GARY E. PENFOUND REG. SURVEYOR
C=1: 17543

8/17/92

#19431

APPROVED
LORAIN CO.
MAP DEPT.
DATE 6-18-91
PAGE 10-A
BY CAROLYN FRANCIS
VOID METER # 19431