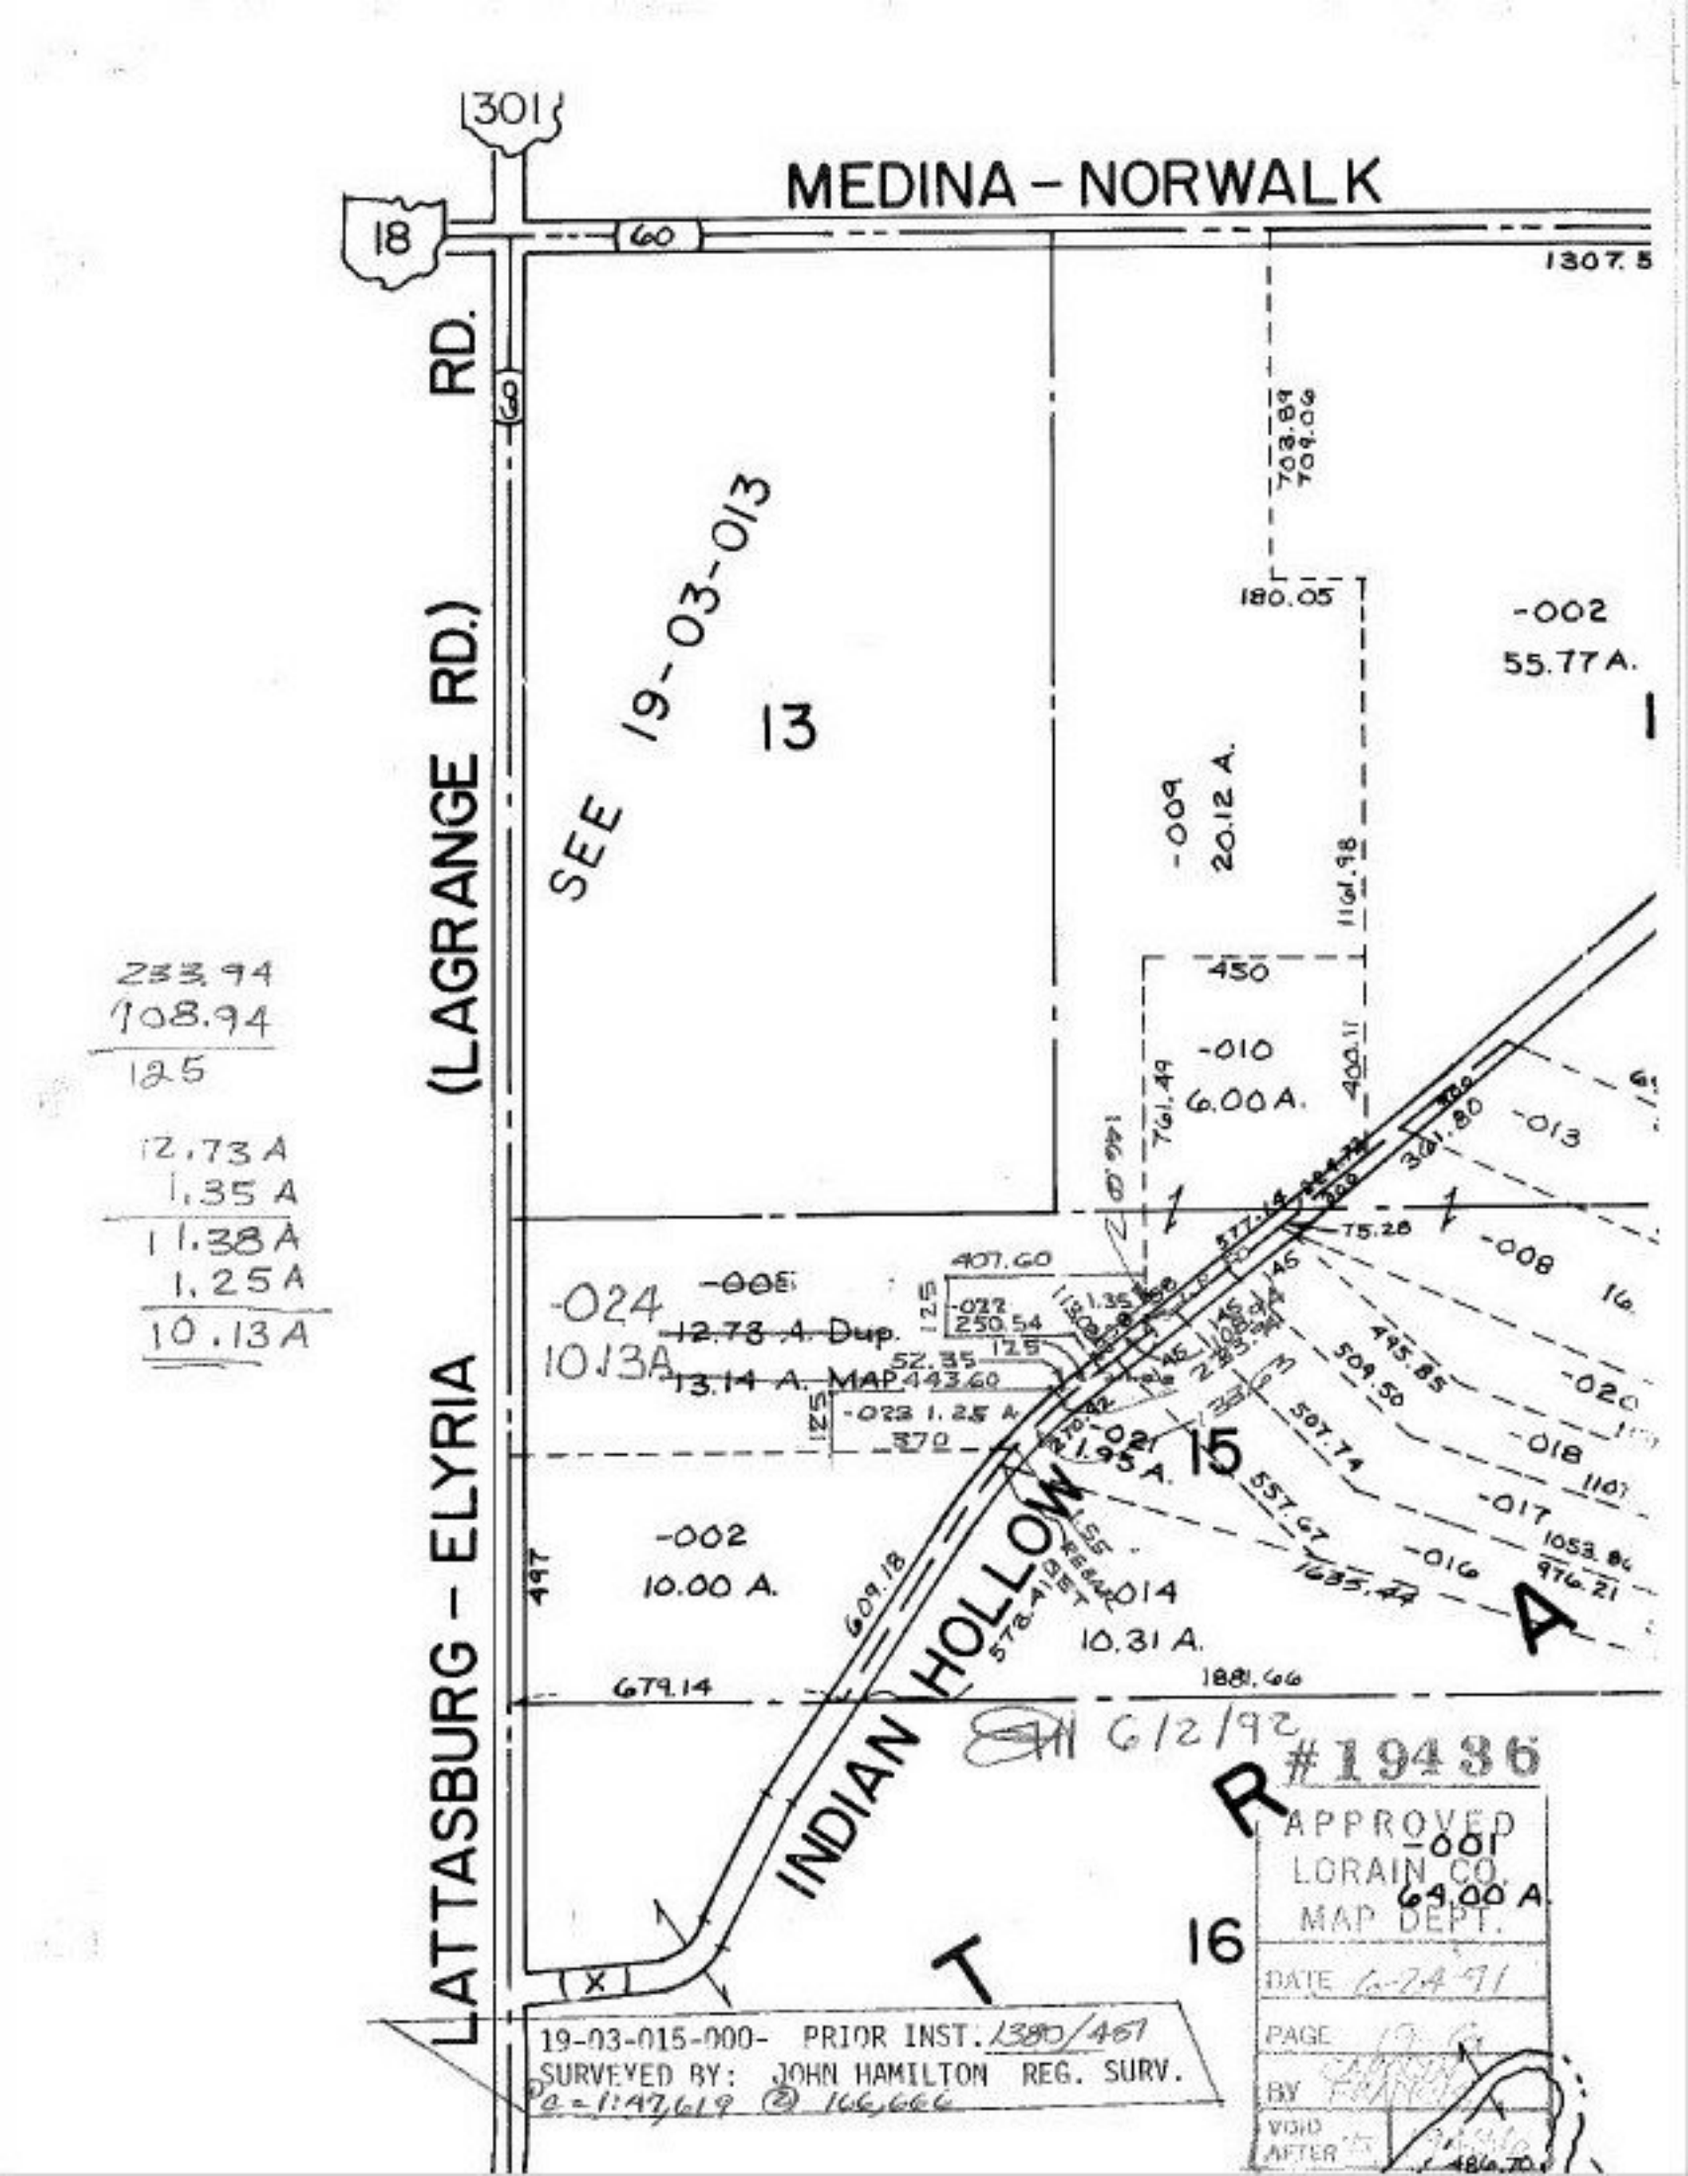
301
MEDINA - NORWALK
18
60
1307.5
RD.
(LAGRANGE RD.)
LATTASBURG - ELYRIA
SEE 19-03-013
13
703.89
709.06
180.05
-002
55.77 A.
1
-009
20.12 A.
1161.98
450
-010
6.00 A.
761.49
400.11
301.80
-013
-008
-020
-018
-017
-016
-021
21.95 A.
15
-024
12.78 A. Dup.
10.13A
13.14 A. MAP
-023 1.25 A.
-005
407.60
125
-022
250.54
52.35
443.60
495.85
509.50
507.74
557.67
1635.44
1053.84
976.21
-002
10.00 A.
497
609.18
578.41
014
10.31 A.
679.14
1881.66
INDIAN HOLLOW
A
T
16
R
6/12/92
#19436
-001
64.00 A
APPROVED
LORAIN CO.
MAP DEPT.
DATE 6-24-92
PAGE
BY
VOID AFTER
19-03-015-000- PRIOR INST. 1380/467
SURVEYED BY: JOHN HAMILTON REG. SURV.
e = 1:47,619 @ 166,666
253.94
108.94
125
12.73 A
1.35 A
11.38 A
1.25 A
10.13 A