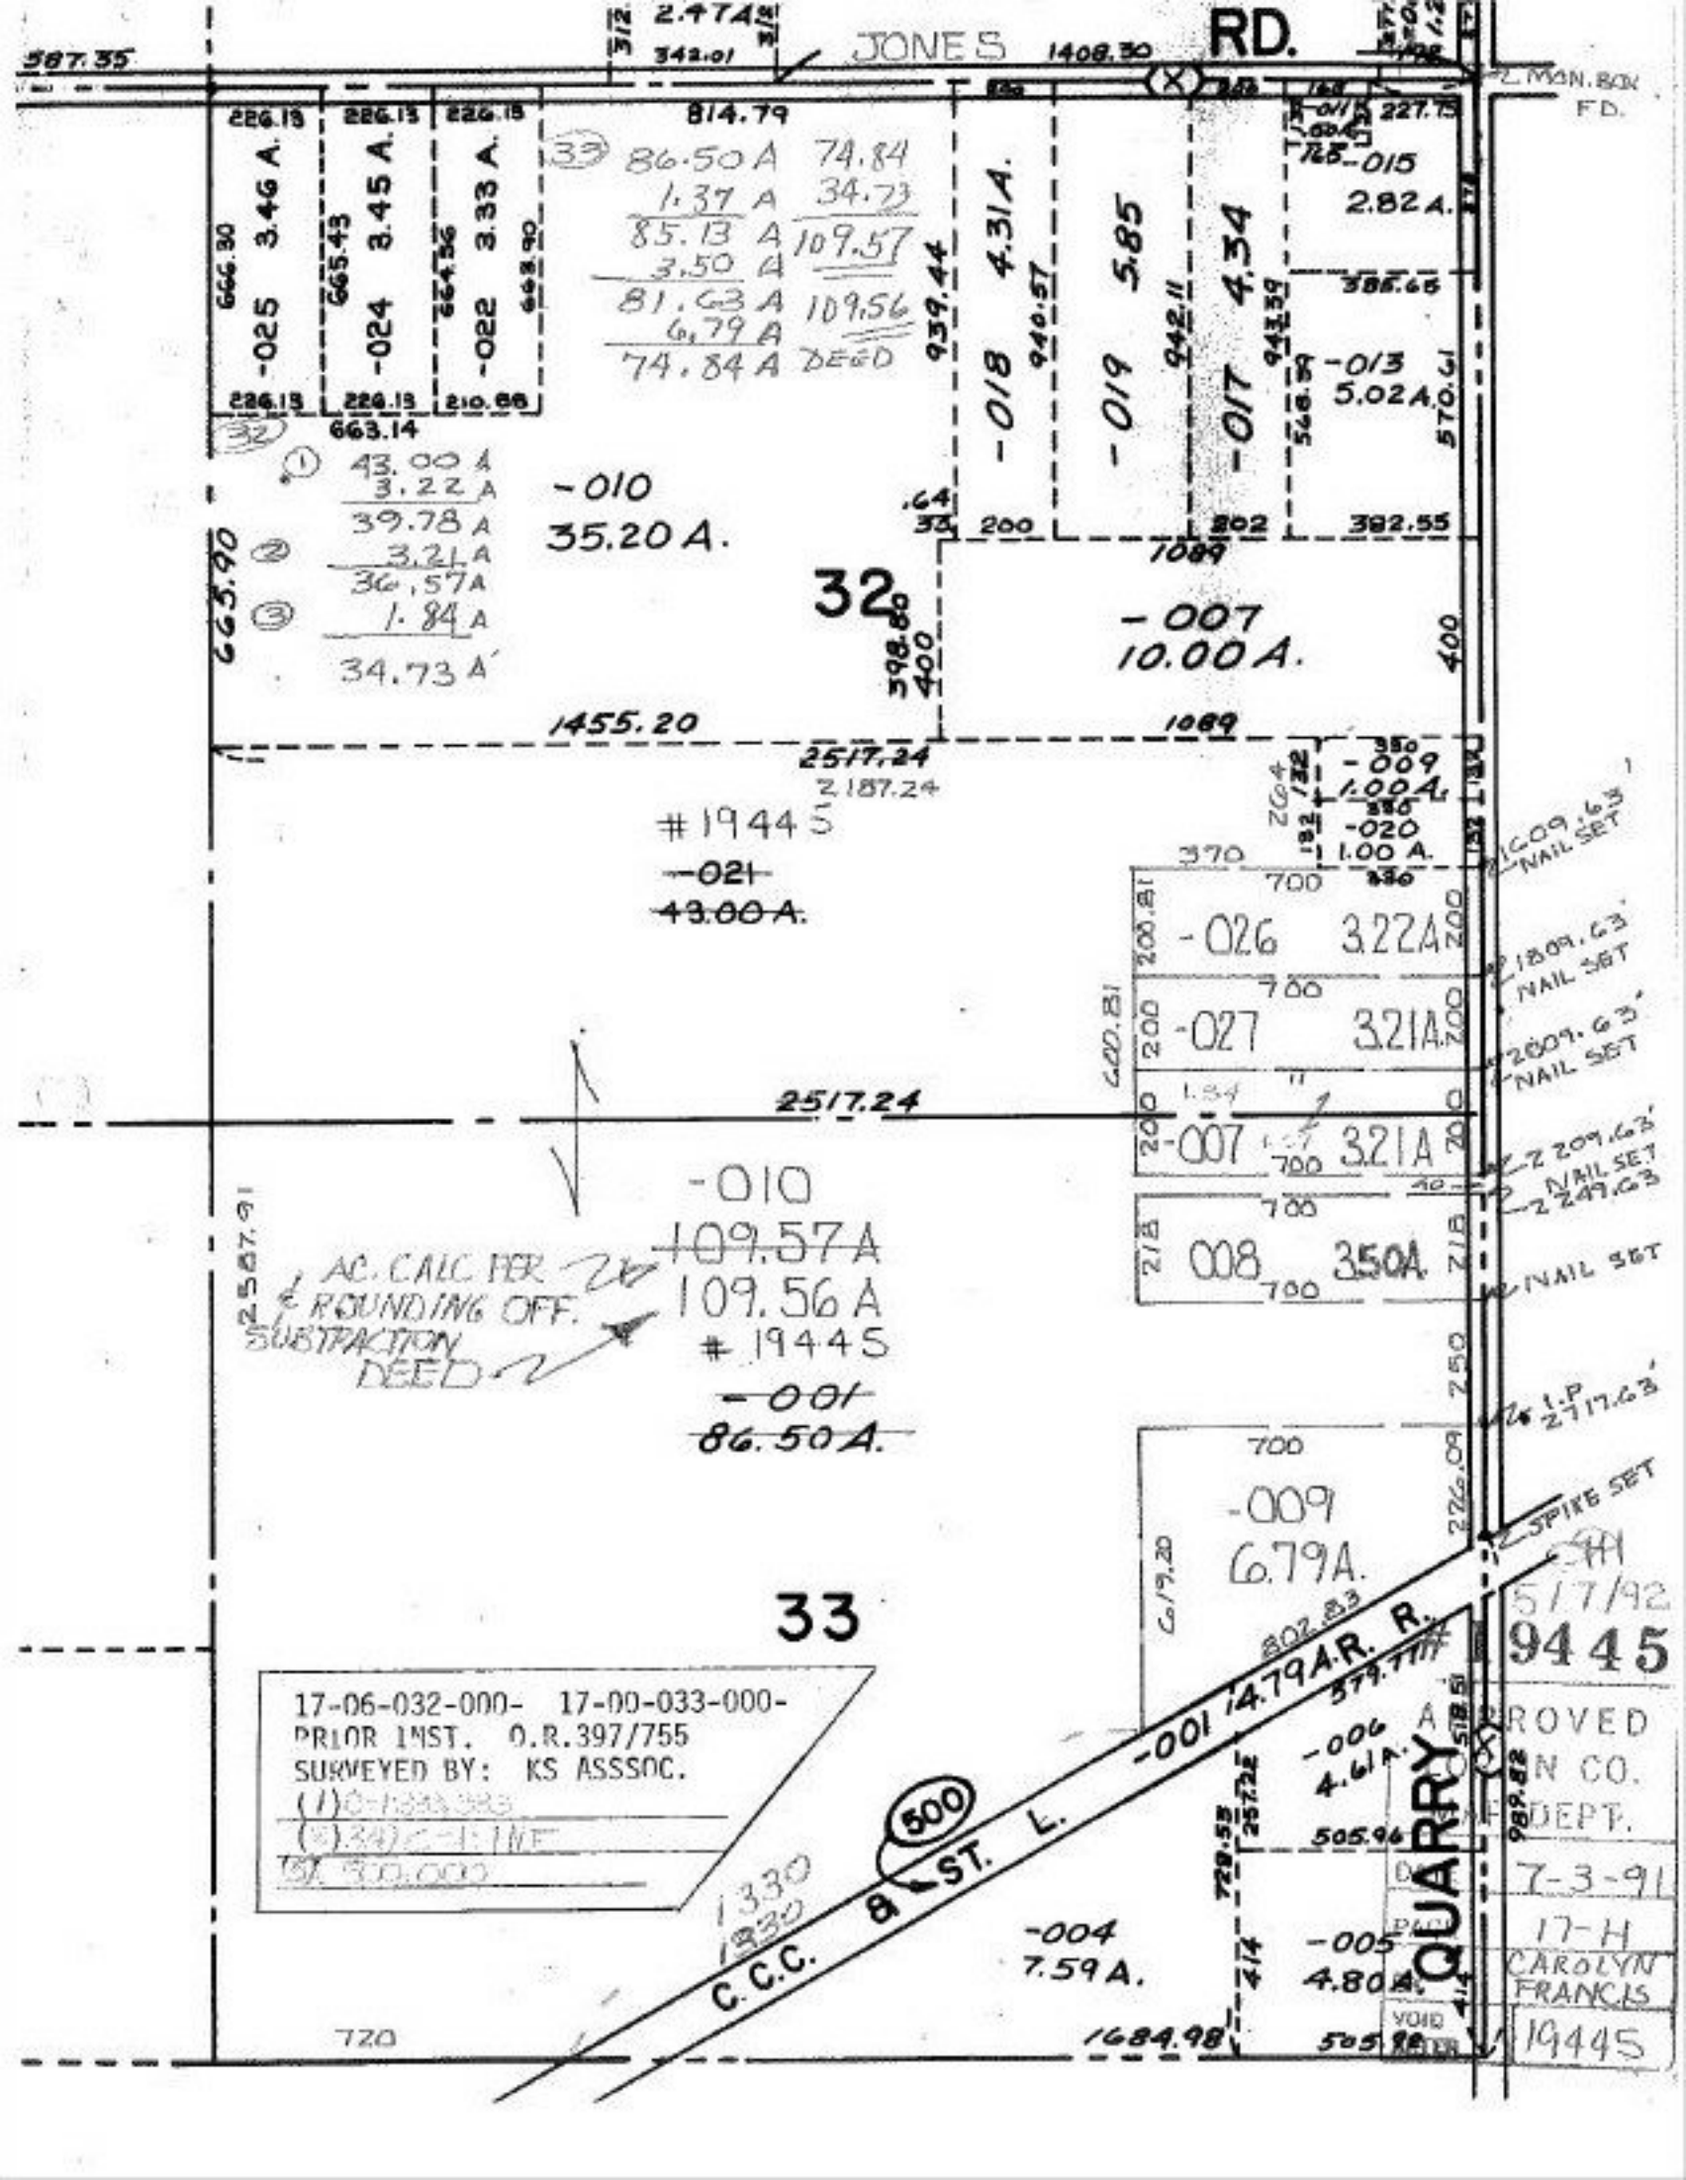
JONES RD.
587.35
342.01
1408.30
814.79
226.15
226.13
226.15
-025 3.46 A.
-024 8.45 A.
-022 3.33 A.
663.14
210.66
33
86.50 A 74.84
1.37 A 34.73
85.13 A 109.57
3.50 A
81.63 A 109.56
6.79 A
74.84 A DEED
939.44
940.57
942.11
943.59
-018 4.314.
-019 5.85
-017 4.34
227.15
-015 2.82 A.
386.66
-013 5.02 A.
570.61
382.55
32
1 43.00 A
3.22 A
39.78 A
2 3.21 A
36.57 A
3 1.84 A
34.73 A
-010
35.20 A.
665.90
398.80
400
1089
-007
10.00 A.
1455.20
2517.24
2187.24
#1945
-021
43.00 A.
-009
1.00 A.
-020
1.00 A.
700
-026 3.22A
-027 3.21A
-007 3.21A
008 3.50A
-010
109.57A
109.56 A
#1945
-001
86.50 A.
AC. CALC PER
& ROUNDING OFF.
SUBTRACTION
DEED
2567.91
-009
6.79A.
619.20
802.83
33
17-06-032-000- 17-00-033-000-
PRIOR INST. O.R.397/755
SURVEYED BY: KS ASSOC.
(1) C-1 333,333
(2) 34 C-1 INF
(3) 900,000
1330
1330
C.C.C. & ST. L.
-001 14.79A R.R.
-004
7.59A.
-005
4.80A.
-006
4.61A.
QUARRY
720
1684.98
505.96
5/7/92
9445
APPROVED
N CO.
DEPT.
7-3-91
17-H
CAROLYN
FRANCIS
19445
VOID
1 NAIL SET
2 NAIL SET
SPIKE SET
2 I.P
2717.63'
2 209.63'
2 249.63
2009.63'
1809.63'
1 CO9.63'
NAIL SET