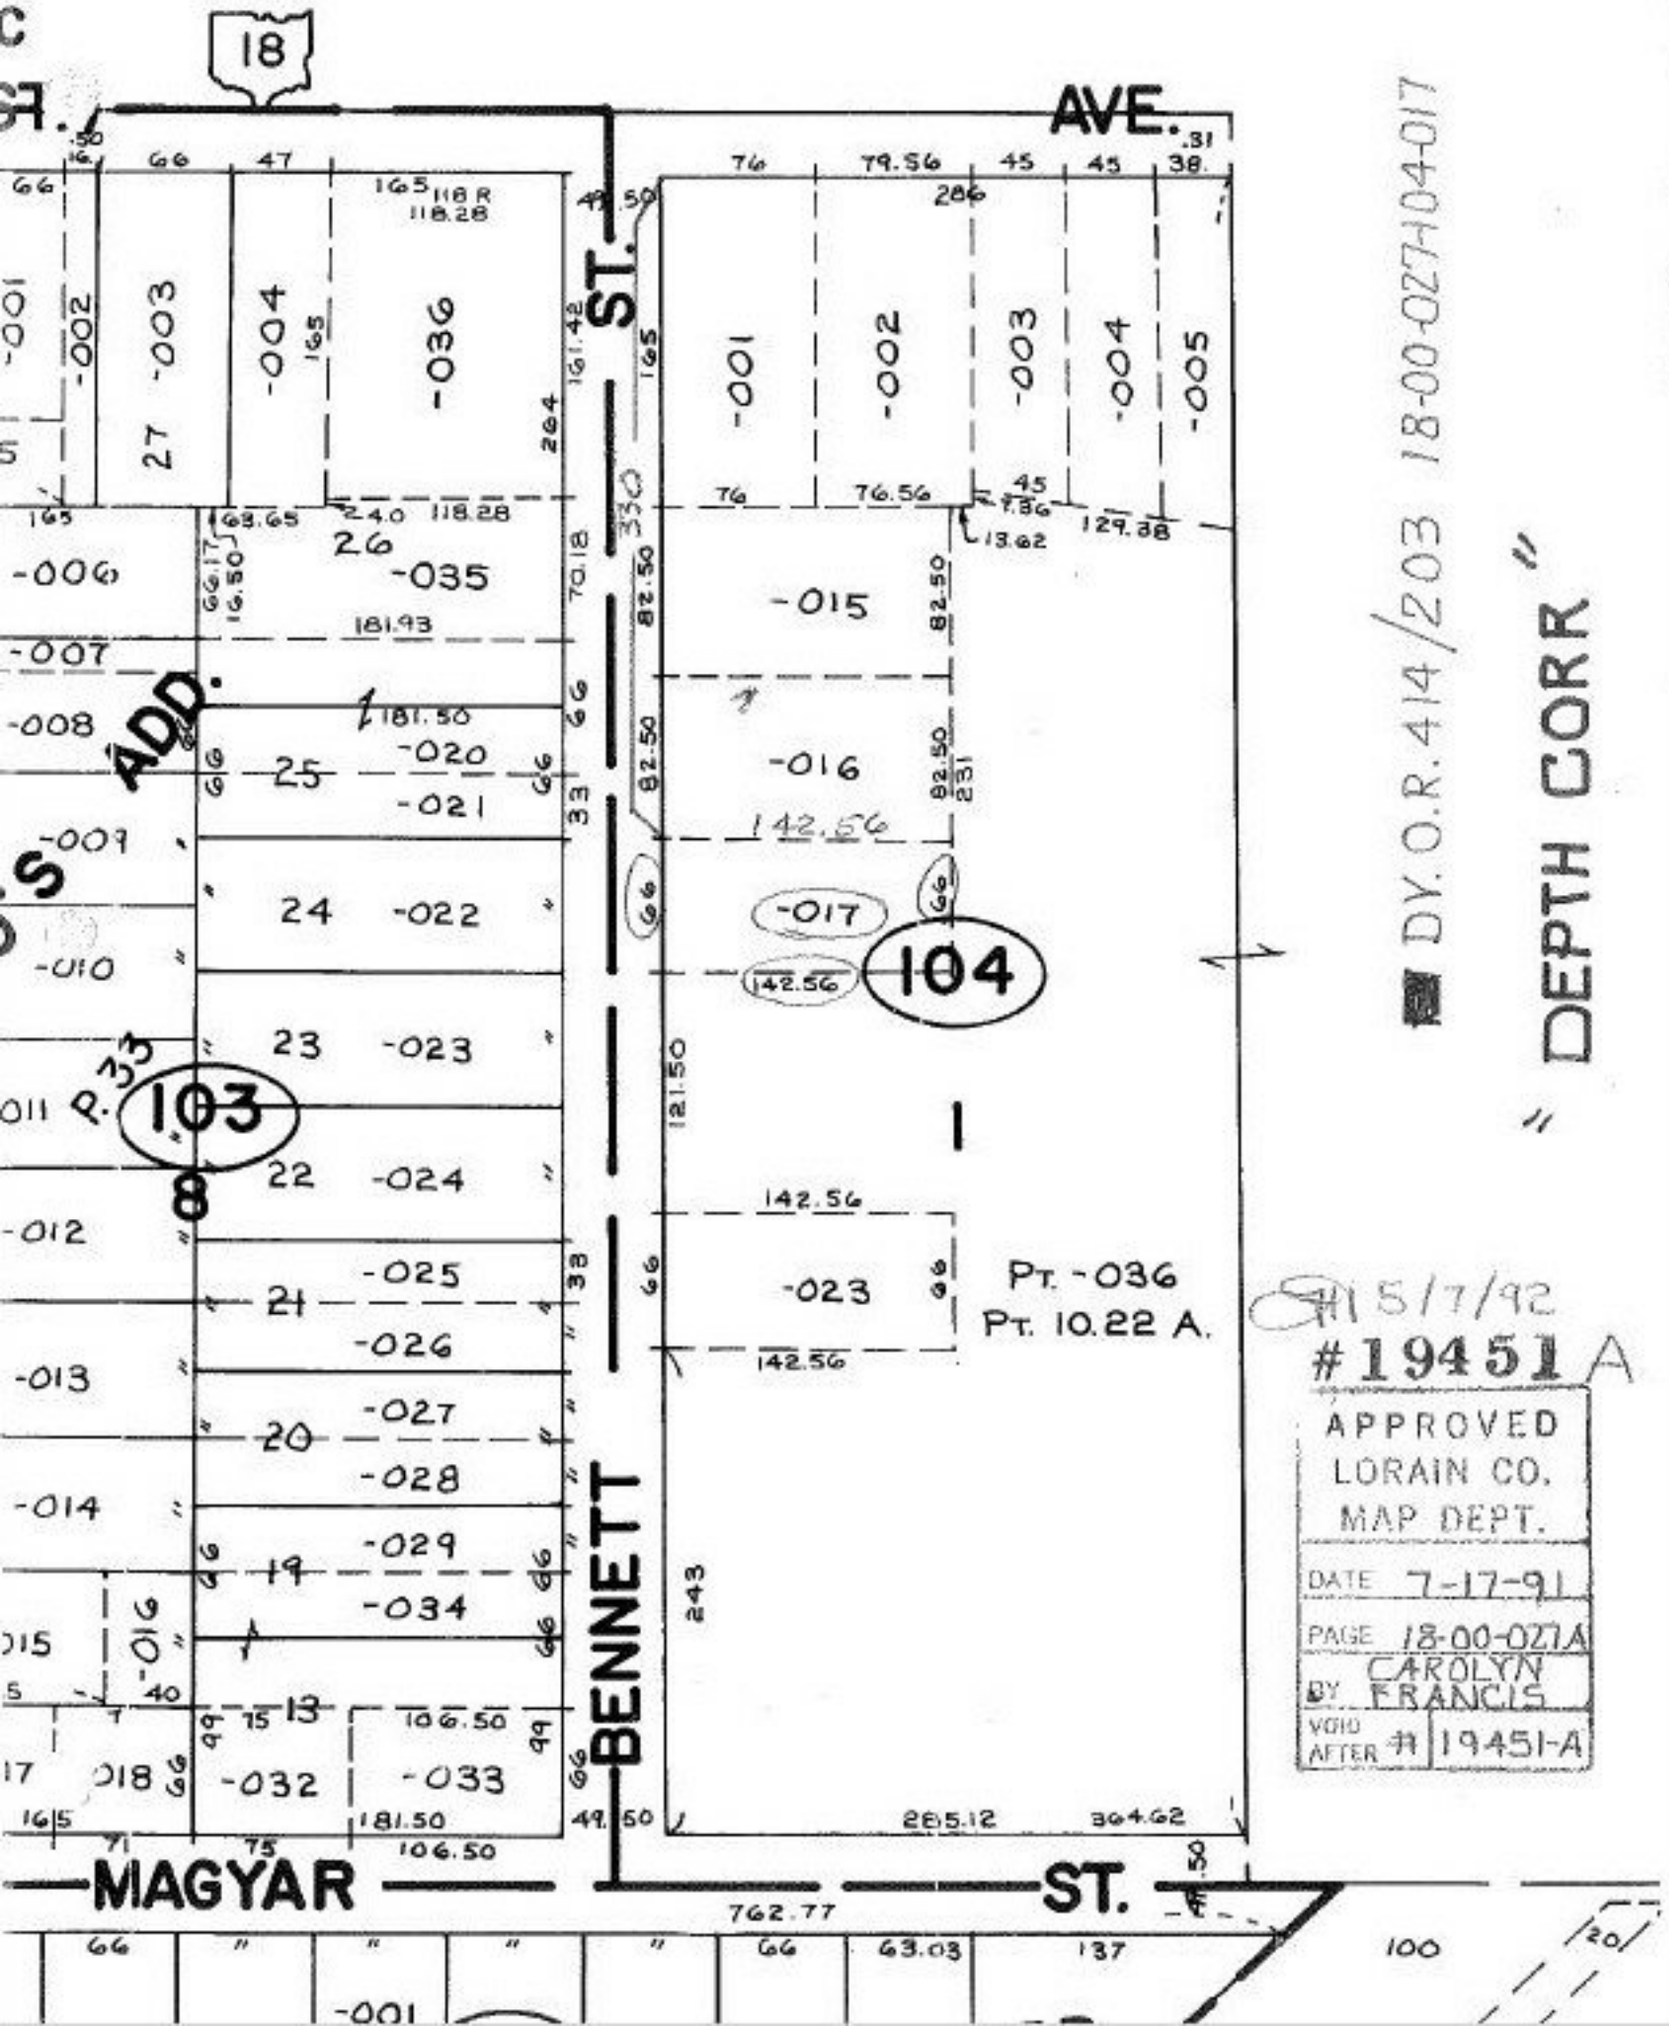
18
AVE.
ST.
BENNETT
MAGYAR
ST.
ADD.
DEPTH CORR
DY. O.R. 414/203 18-00-027-04-017
-001
-002
-003
-004
-005
-006
-007
-008
-009
-010
-011
-012
-013
-014
-015
-016
-017
-020
-021
-022
-023
-024
-025
-026
-027
-028
-029
-032
-033
-034
-035
-036
104
103
Pt. -036
Pt. 10.22 A.
5/7/92
#19451 A
APPROVED
LORAIN CO.
MAP DEPT.
DATE 7-17-91
PAGE 18-00-027A
BY CAROLYN FRANCIS
VOID AFTER #1 19451-A