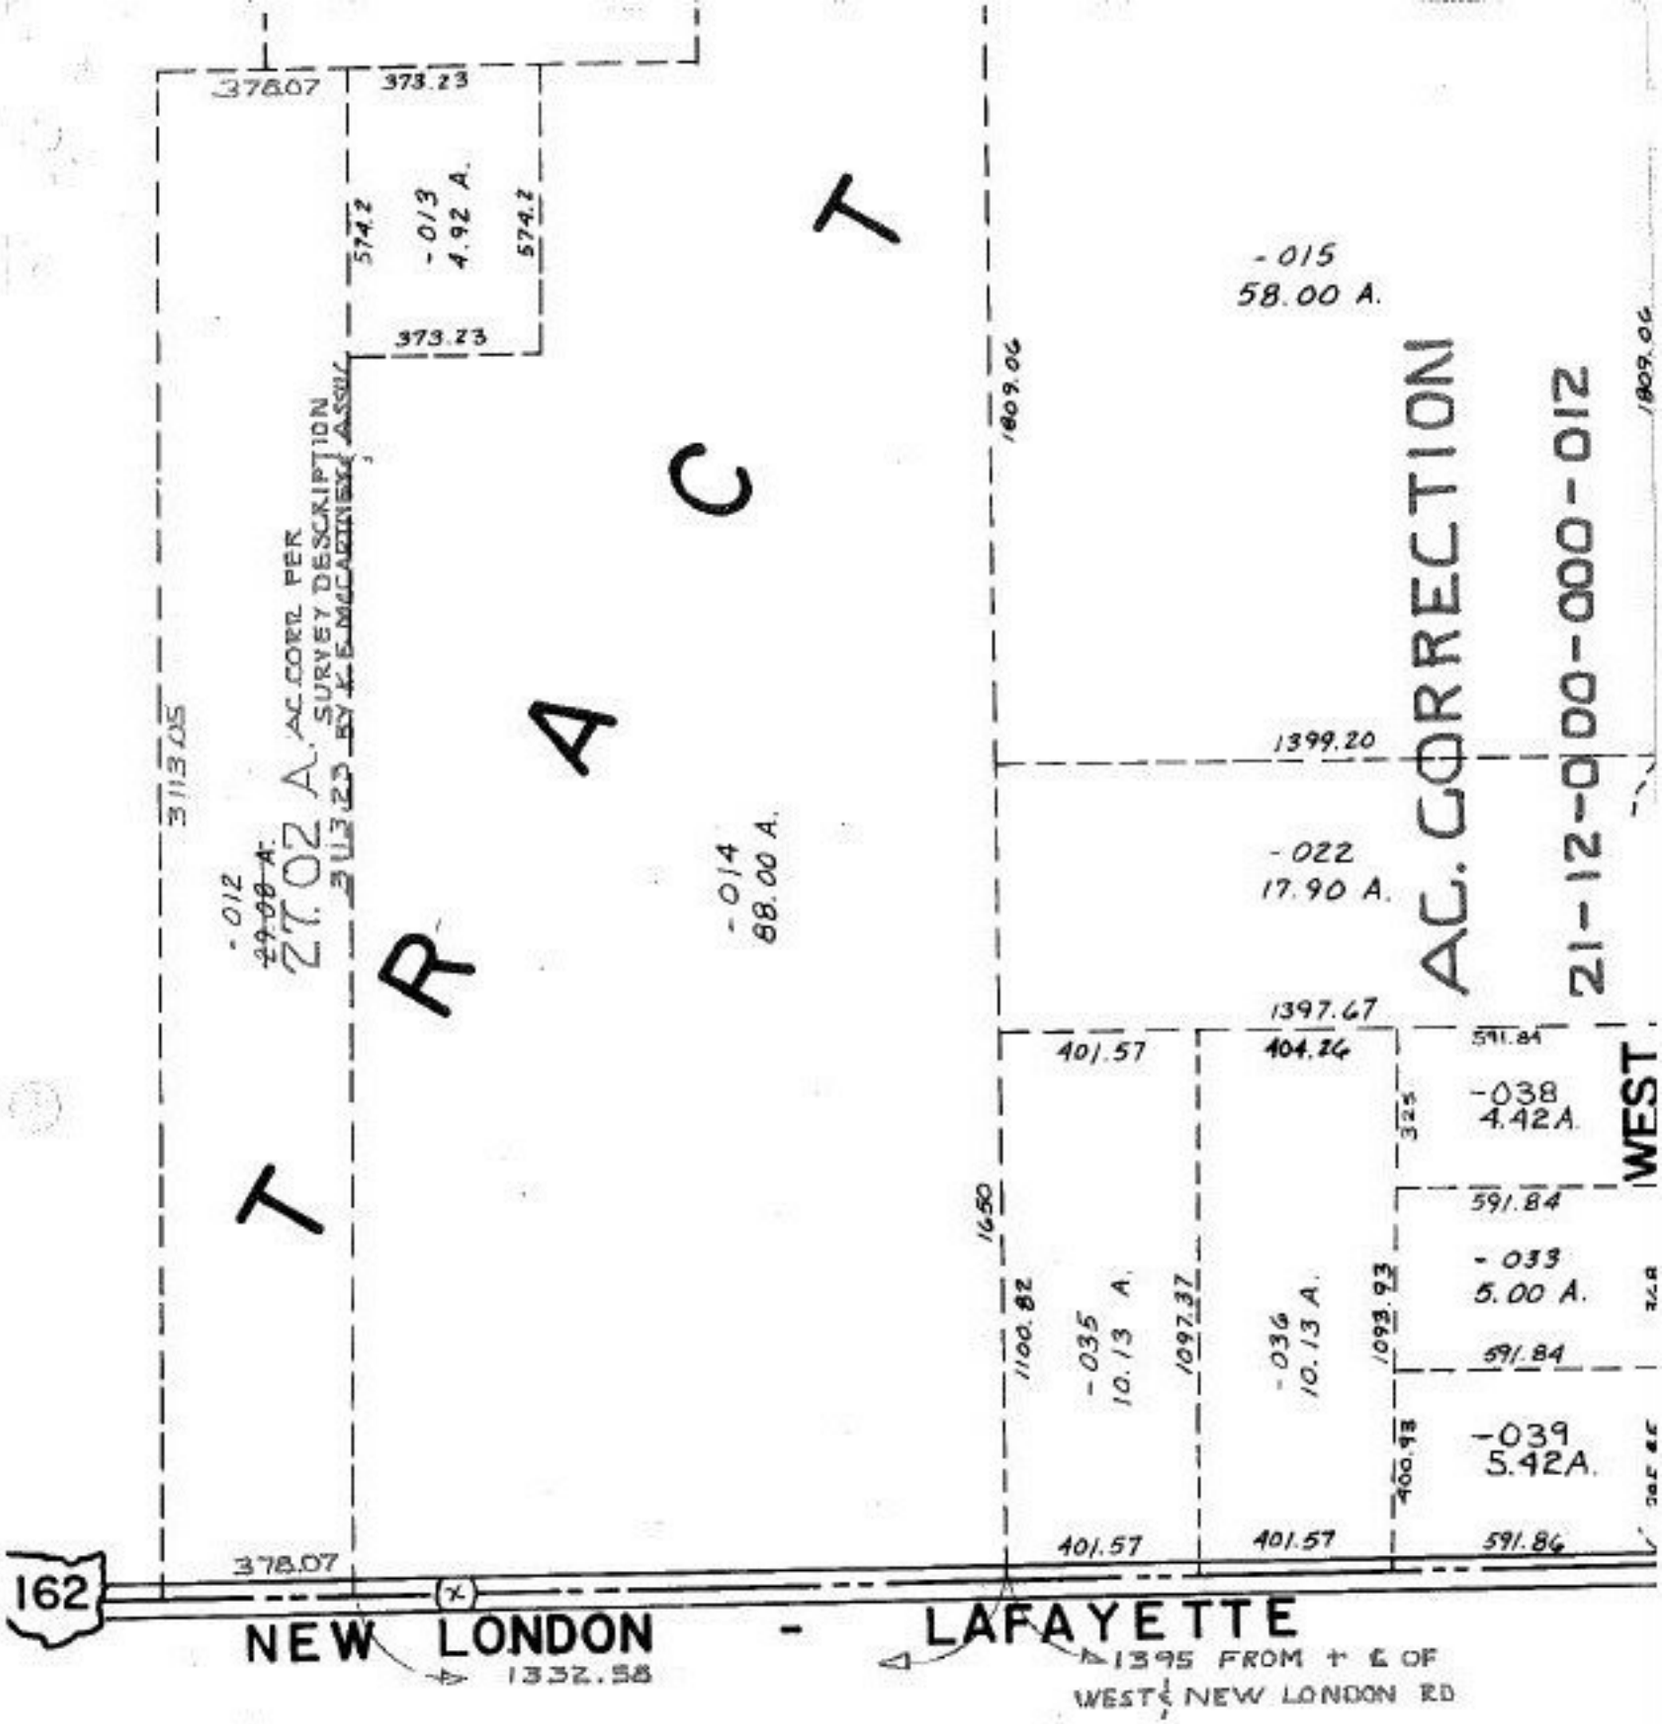

21-12-000-000-012

6/12/92

#19452-A

APPROVED
LORAIN CO.
MAP DEPT.
DATE 7-24-91
PAGE 21-D
BY CAROLYN FRANCIS
VOID AFTER # 19452A