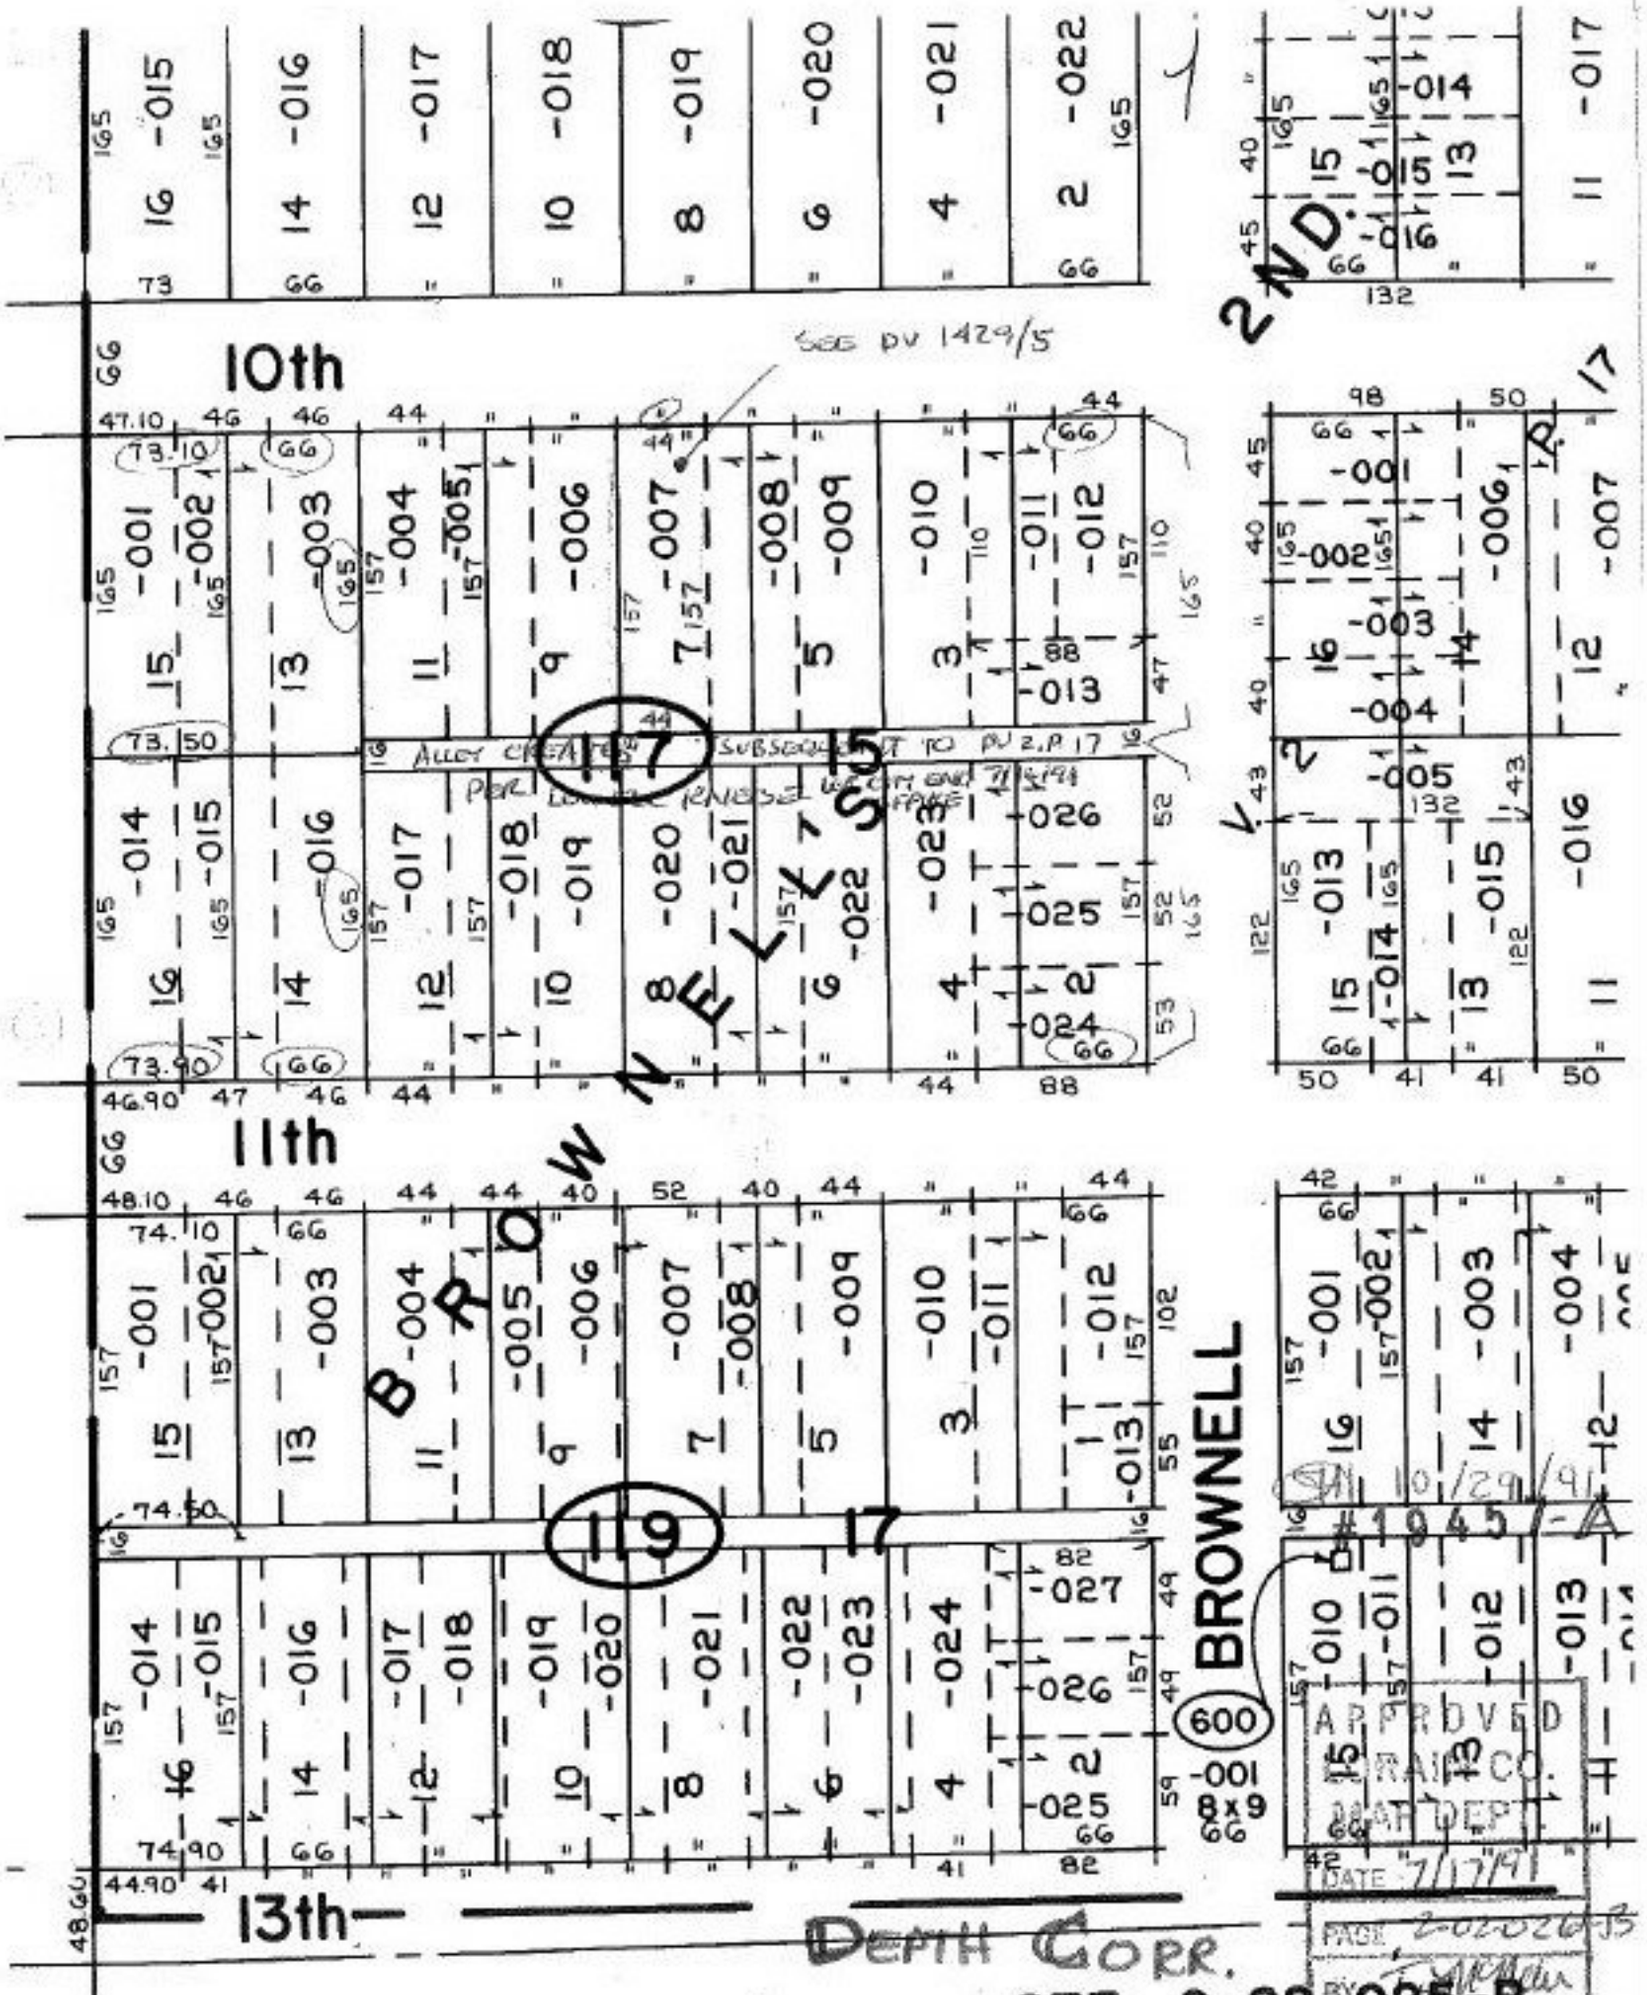
10th
11th
13th
BROWNELL
BROWNELL'S
2ND.
SEE PV 1429/5
ALLEY CREATED SUBSEQUENT TO PV 2, P 17
PER LOWER KNESE
117
119
17
600
-001
8x9
DEPTH CORR.
SEE 2-02-025-B
APPROVED
DRAIN CO.
MAP DEPT.
DATE 7/17/91
PAGE 2-02-026-B
BY
VOID AFTER 19457-A
SH 10/29/91
#19457-A