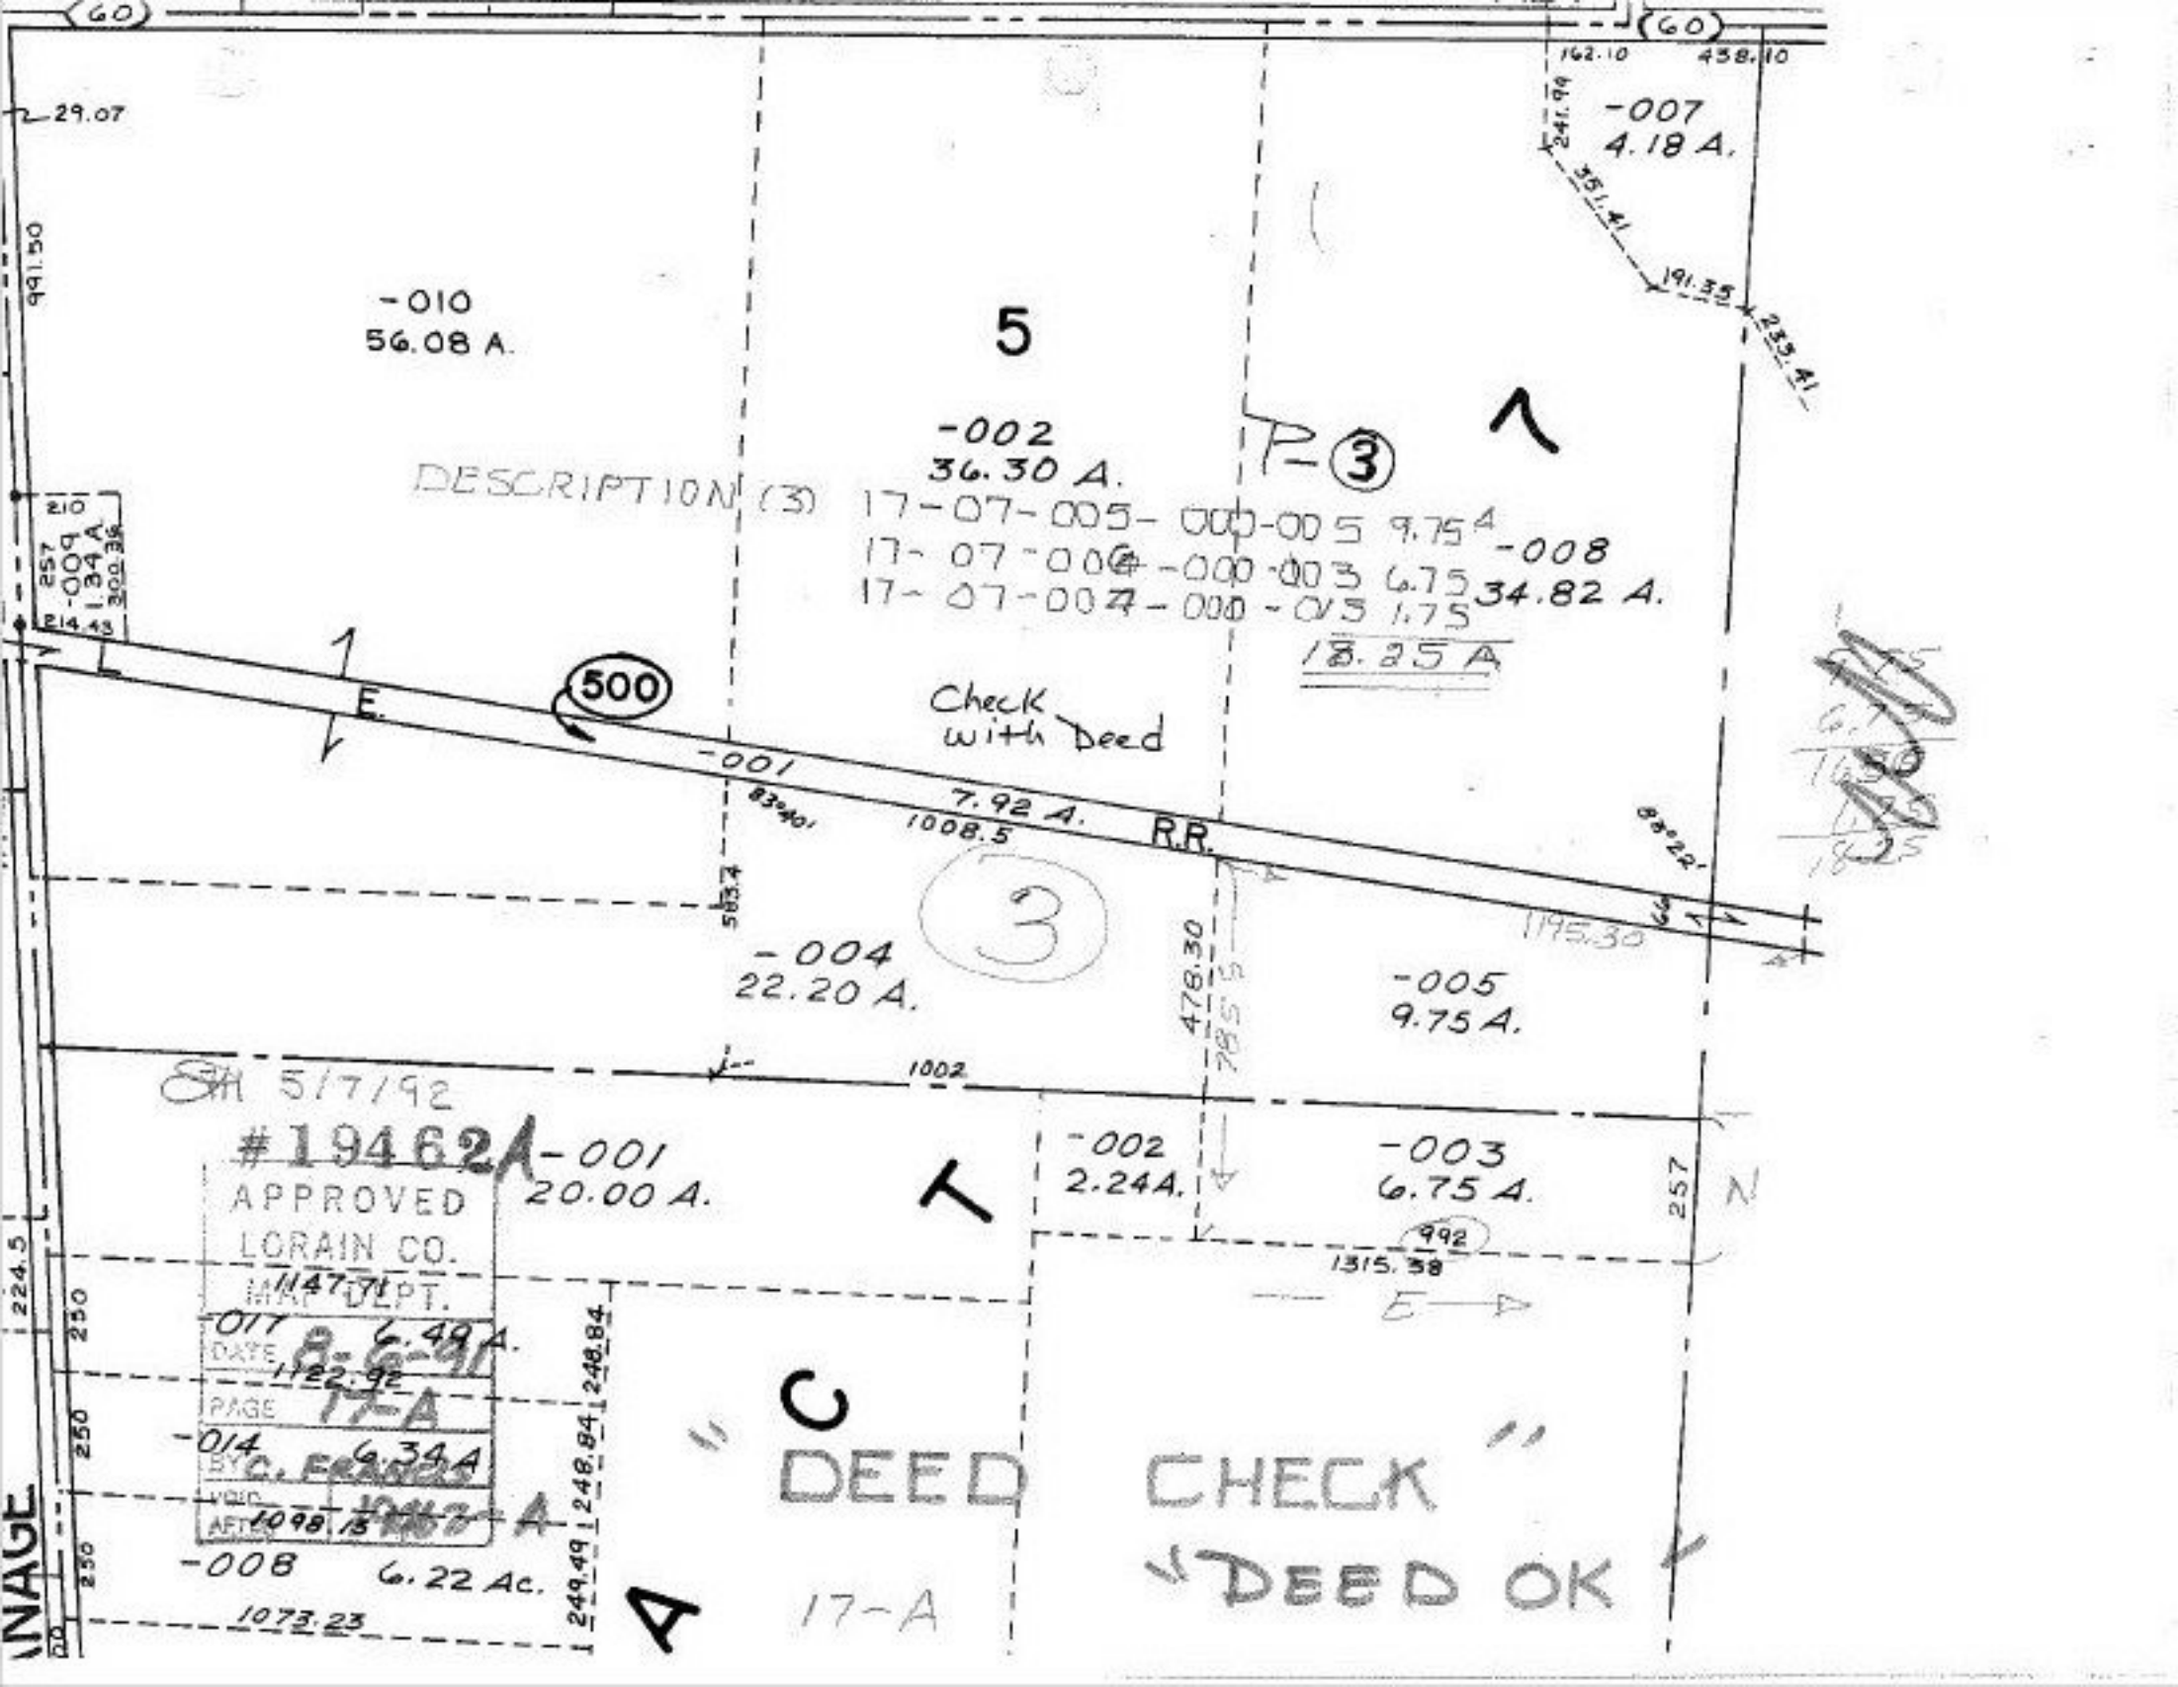

(60)
(60)
29.07
991.50
162.10
438.10
241.99
-007
4.18 A.
351.41
191.35
233.41
-010
56.08 A.
5
-002
36.30 A.
P-3
DESCRIPTION (3) 17-07-005-000-005 9.75 A
17-07-006-000-003 6.75
17-07-007-000-013 1.75
18.25 A
-008
34.82 A.
210
257
-009
1.34 A
300.36
214.43
500
E.
Check with Deed
-001
7.92 A.
83°40'
1008.5
R.R.
83°22'
583.4
3
1195.30
-004
22.20 A.
478.30
785.5
-005
9.75 A.
1002
5/7/92
#19462A
-001
20.00 A.
-002
2.24A.
-003
6.75 A.
257
N
992
1315.38
E
APPROVED
LORAIN CO.
MAP DEPT.
1147.71
-017
6.49 A.
DATE 8-6-91
1122.92
PAGE 17-A
-014
6.34 A
BY C. FRANCIS
VOID
AFTER 1098.13
-008
6.22 Ac.
1073.23
248.84
248.84
249.49
224.5
250
250
250
NAGE
C
A
"DEED CHECK"
"DEED OK"
17-A