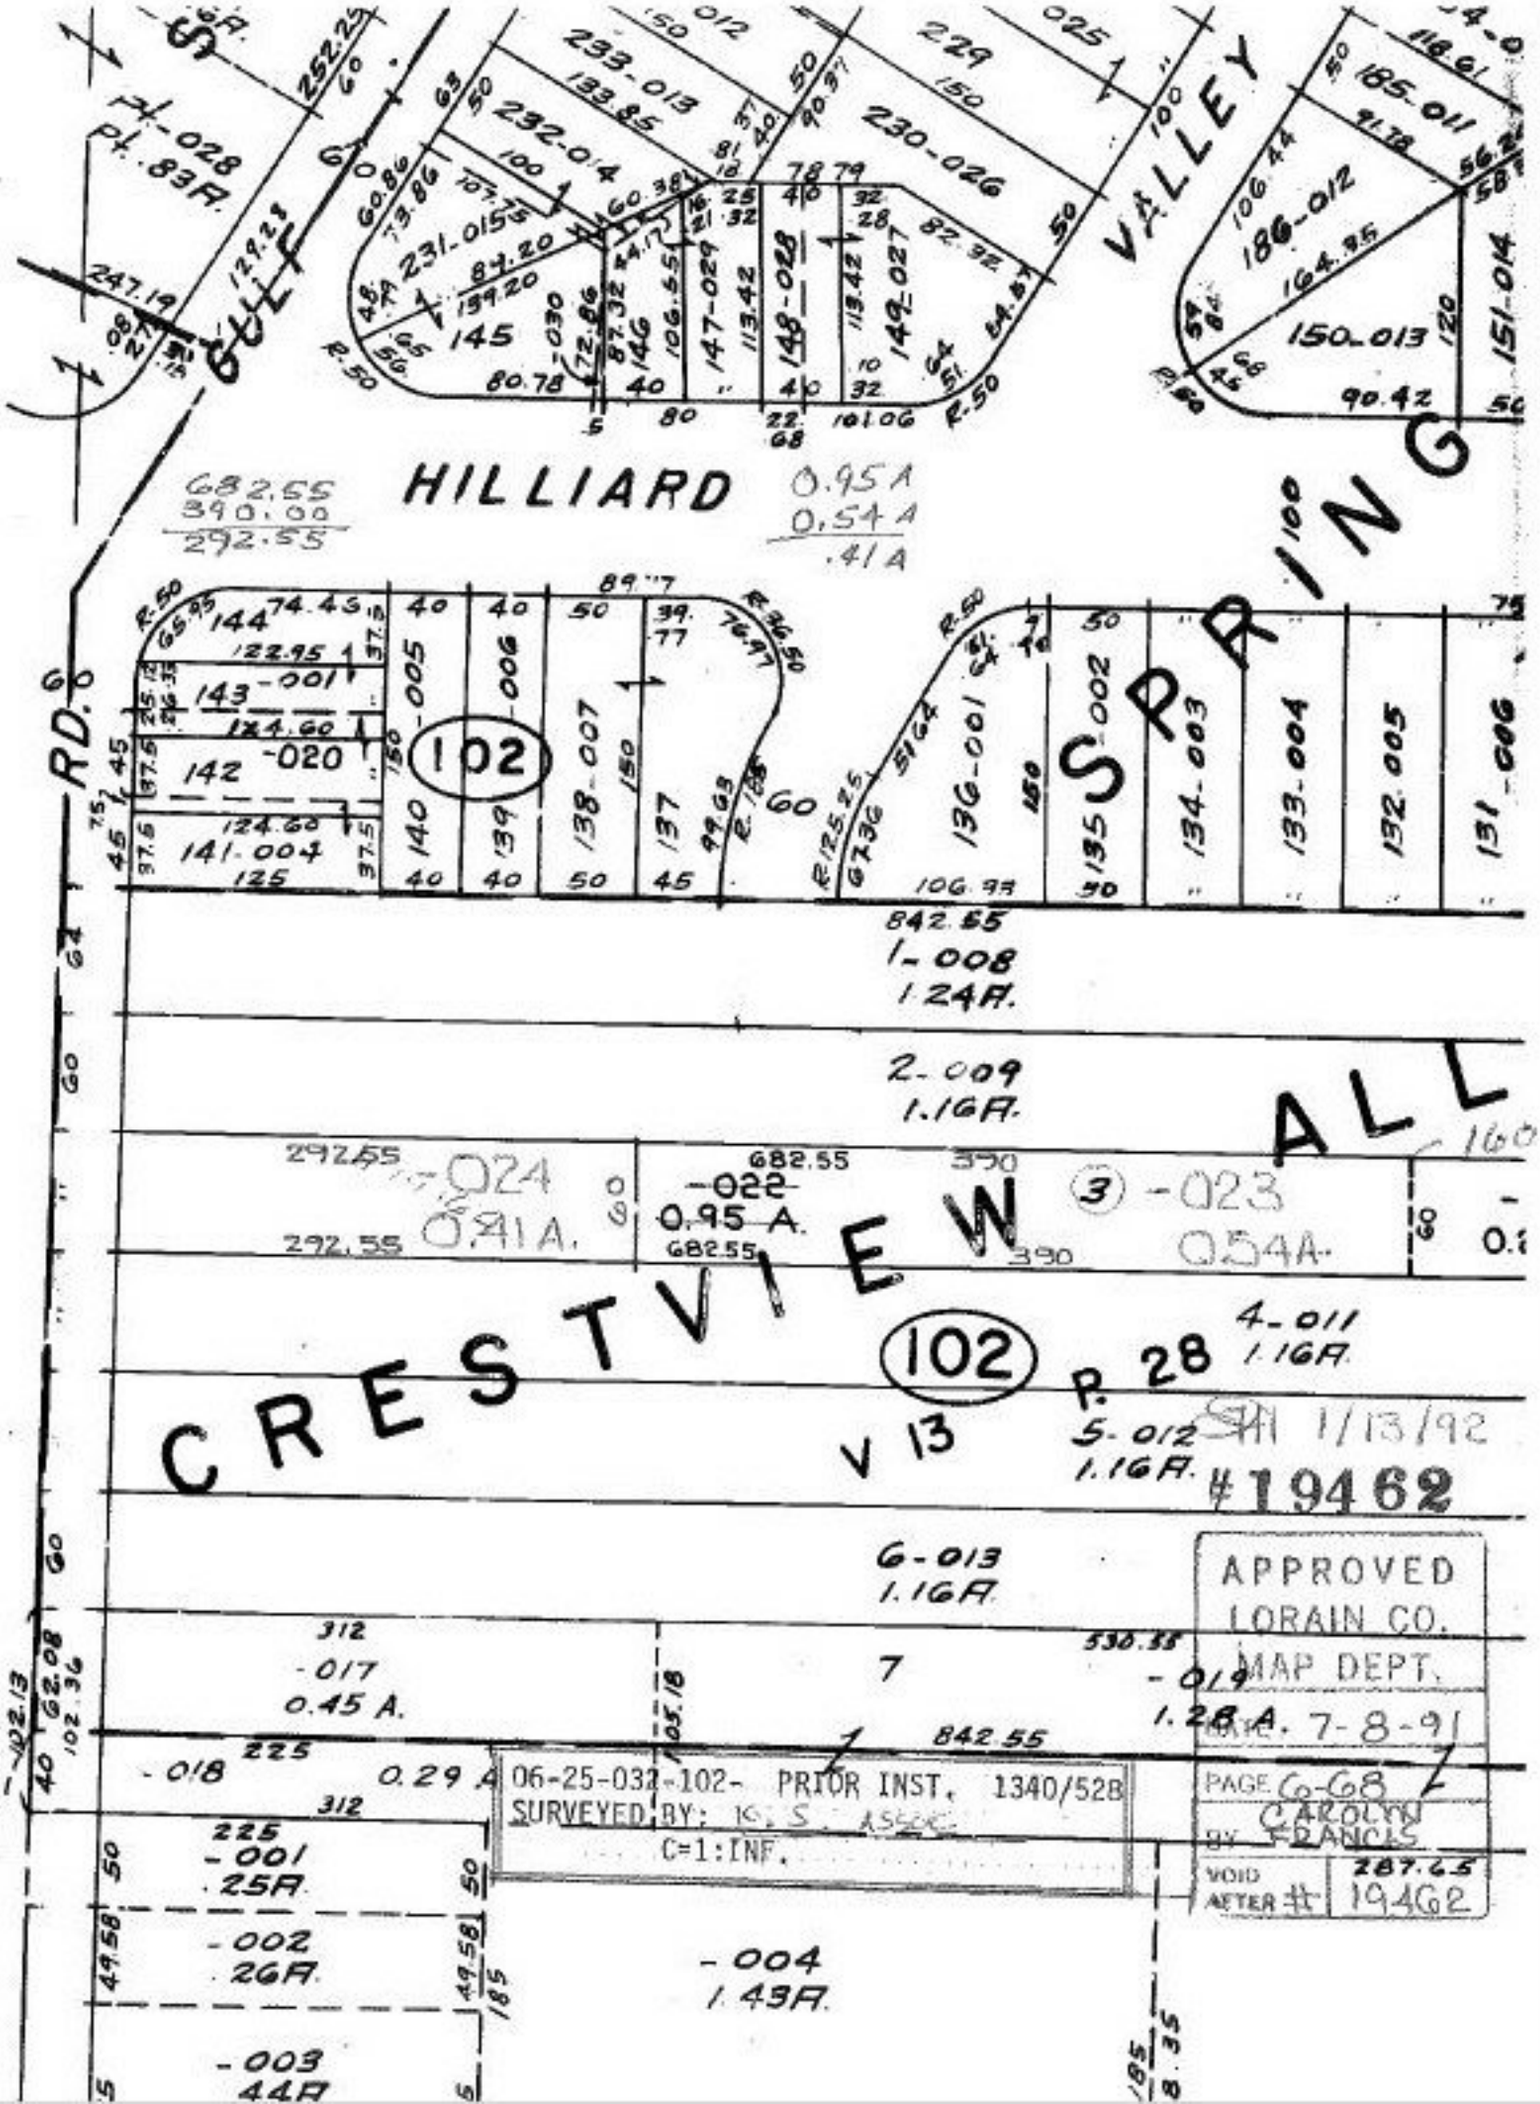
HILLIARD
CRESTVIEW
SPRING
VALLEY
GULF
RD. 6
102
682.55
390.00
292.55
0.95 A
0.54 A
.41 A
842.55
1.24A.
2.009
1.16A.
292.55
682.55
390
-024
0.41A.
-022
0.95 A.
-023
0.54A.
4-011
1.16A.
5-012
1.16A.
6-013
1.16A.
-017
0.45 A.
-018
0.29 A.
-019
1.28 A.
-001
.25A.
-002
.26A.
-004
1.43A.
-003
.44A
1/13/92
#19462
APPROVED
LORAIN CO.
MAP DEPT.
DATE 7-8-91
PAGE 6-68
BY CAROLYN FRANCIS
VOID AFTER # 19462
287.65
06-25-032-102- PRIOR INST. 1340/528
SURVEYED BY: 10 S ASSOC.
C=1:INF.