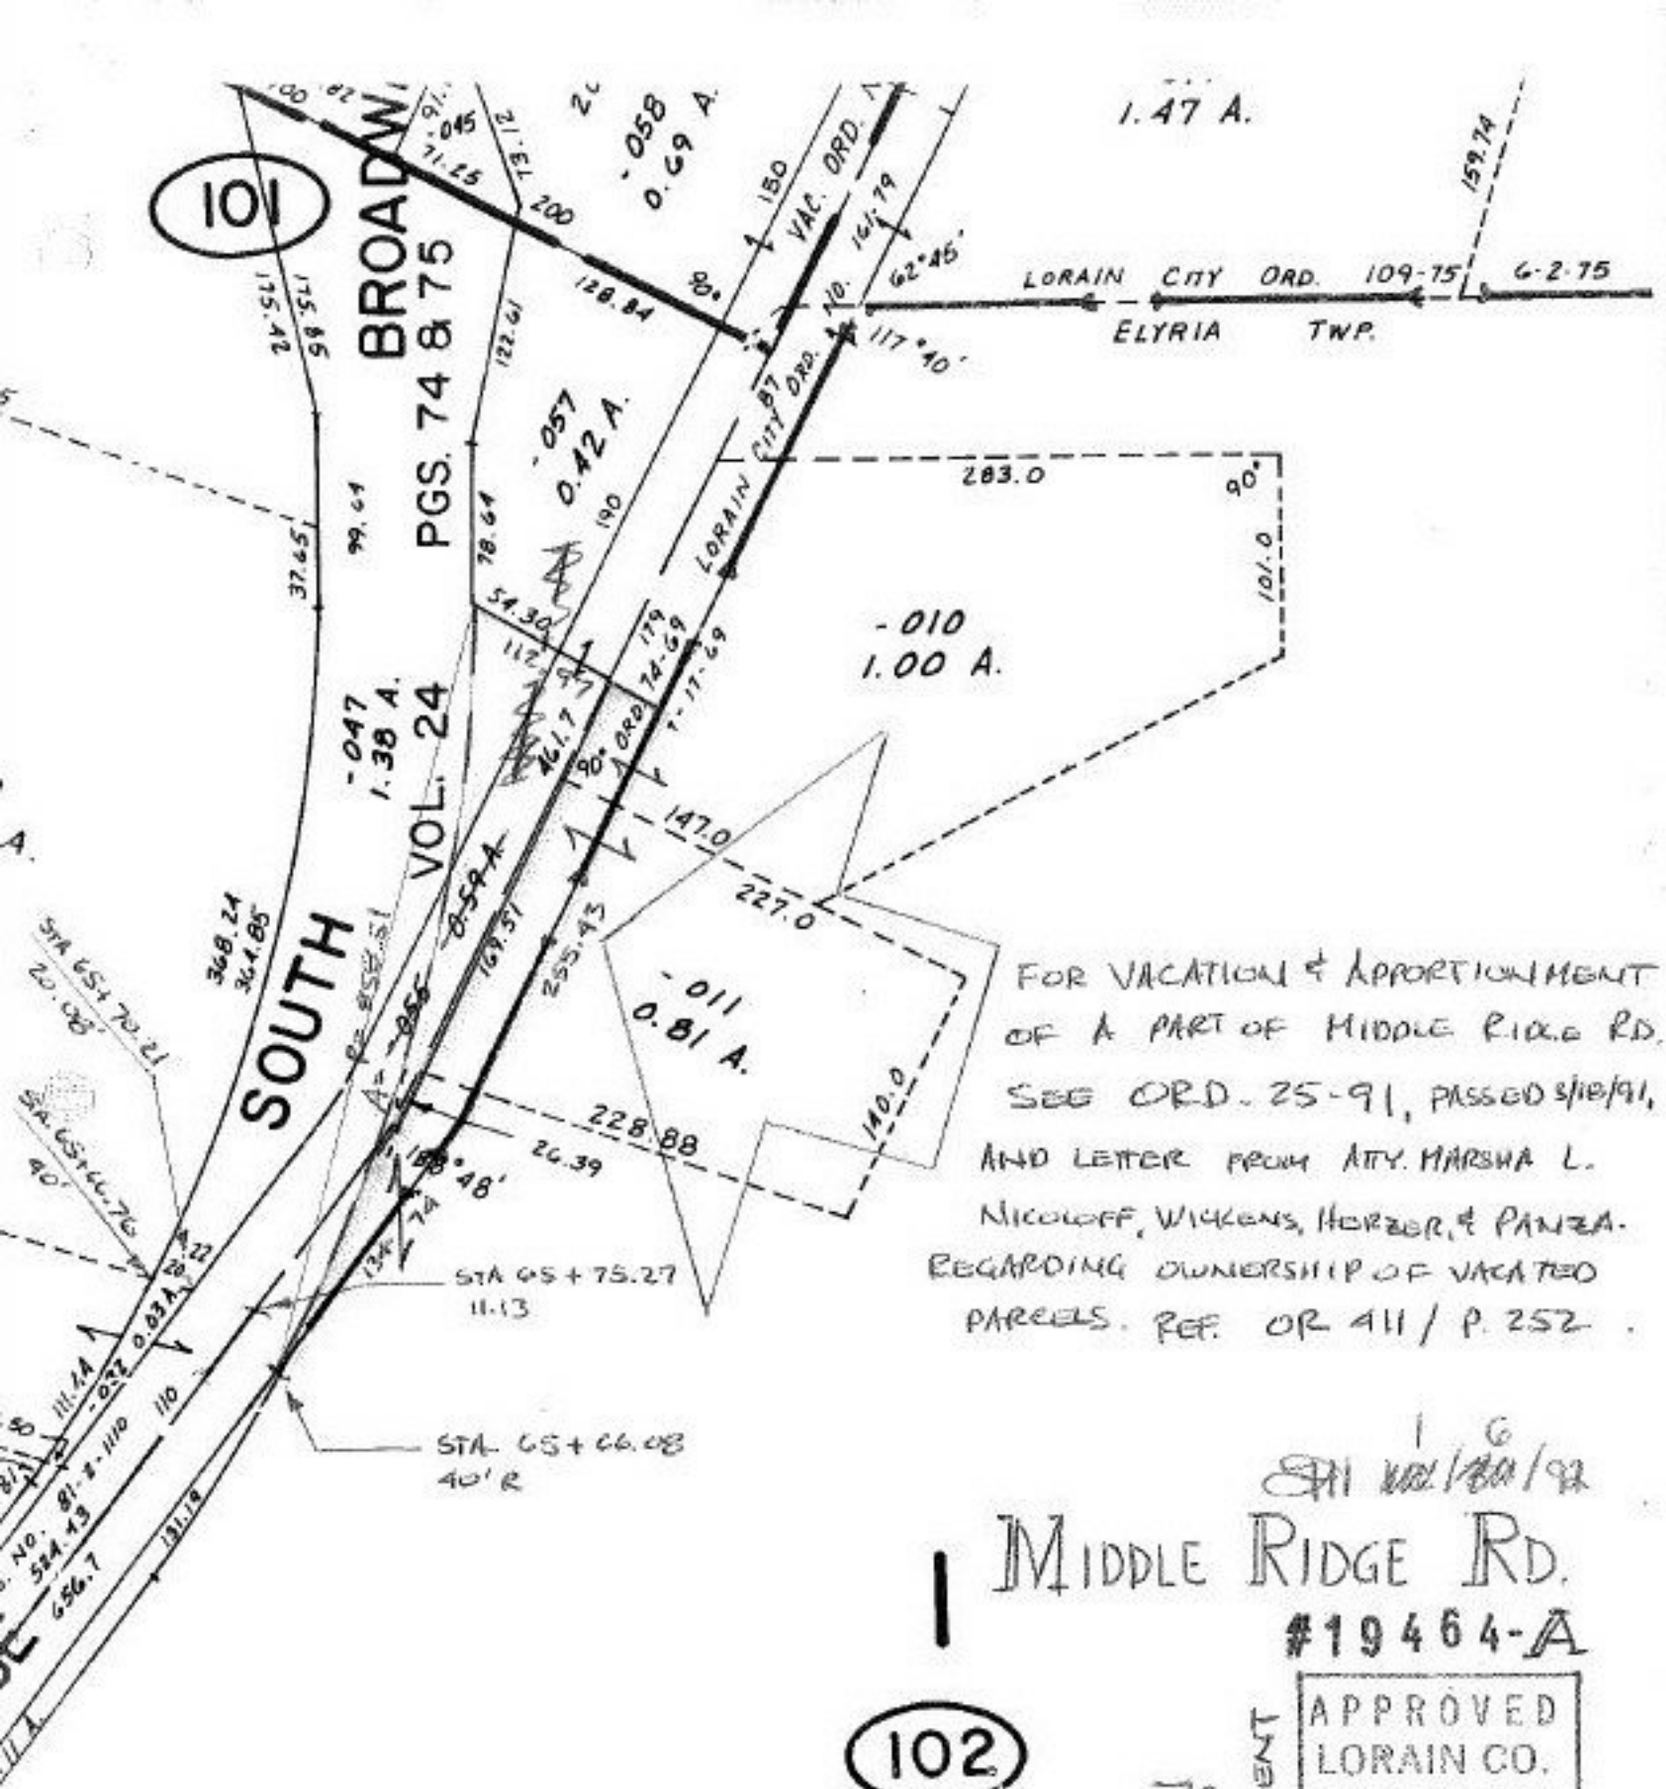

FOR VACATION & APPORTIONMENT OF A PART OF MIDDLE RIDGE RD. SEE ORD. 25-91, PASSED 3/18/91, AND LETTER FROM ATTY. MARSHA L. NICOLOFF, WICKENS, HERZER, & PANZA. REGARDING OWNERSHIP OF VACATED PARCELS. REF. OR 411 / P. 252.

1 6

SH 1/6/92

MIDDLE RIDGE RD.

#19464-A

VACATION AND APPORTIONMENT

APPROVED LORAIN CO. MAP DEPT.	
DATE 8-19-91	
PAGE 6-1	
BY T. McNair	
VOID AFTER	19464-A

6-1