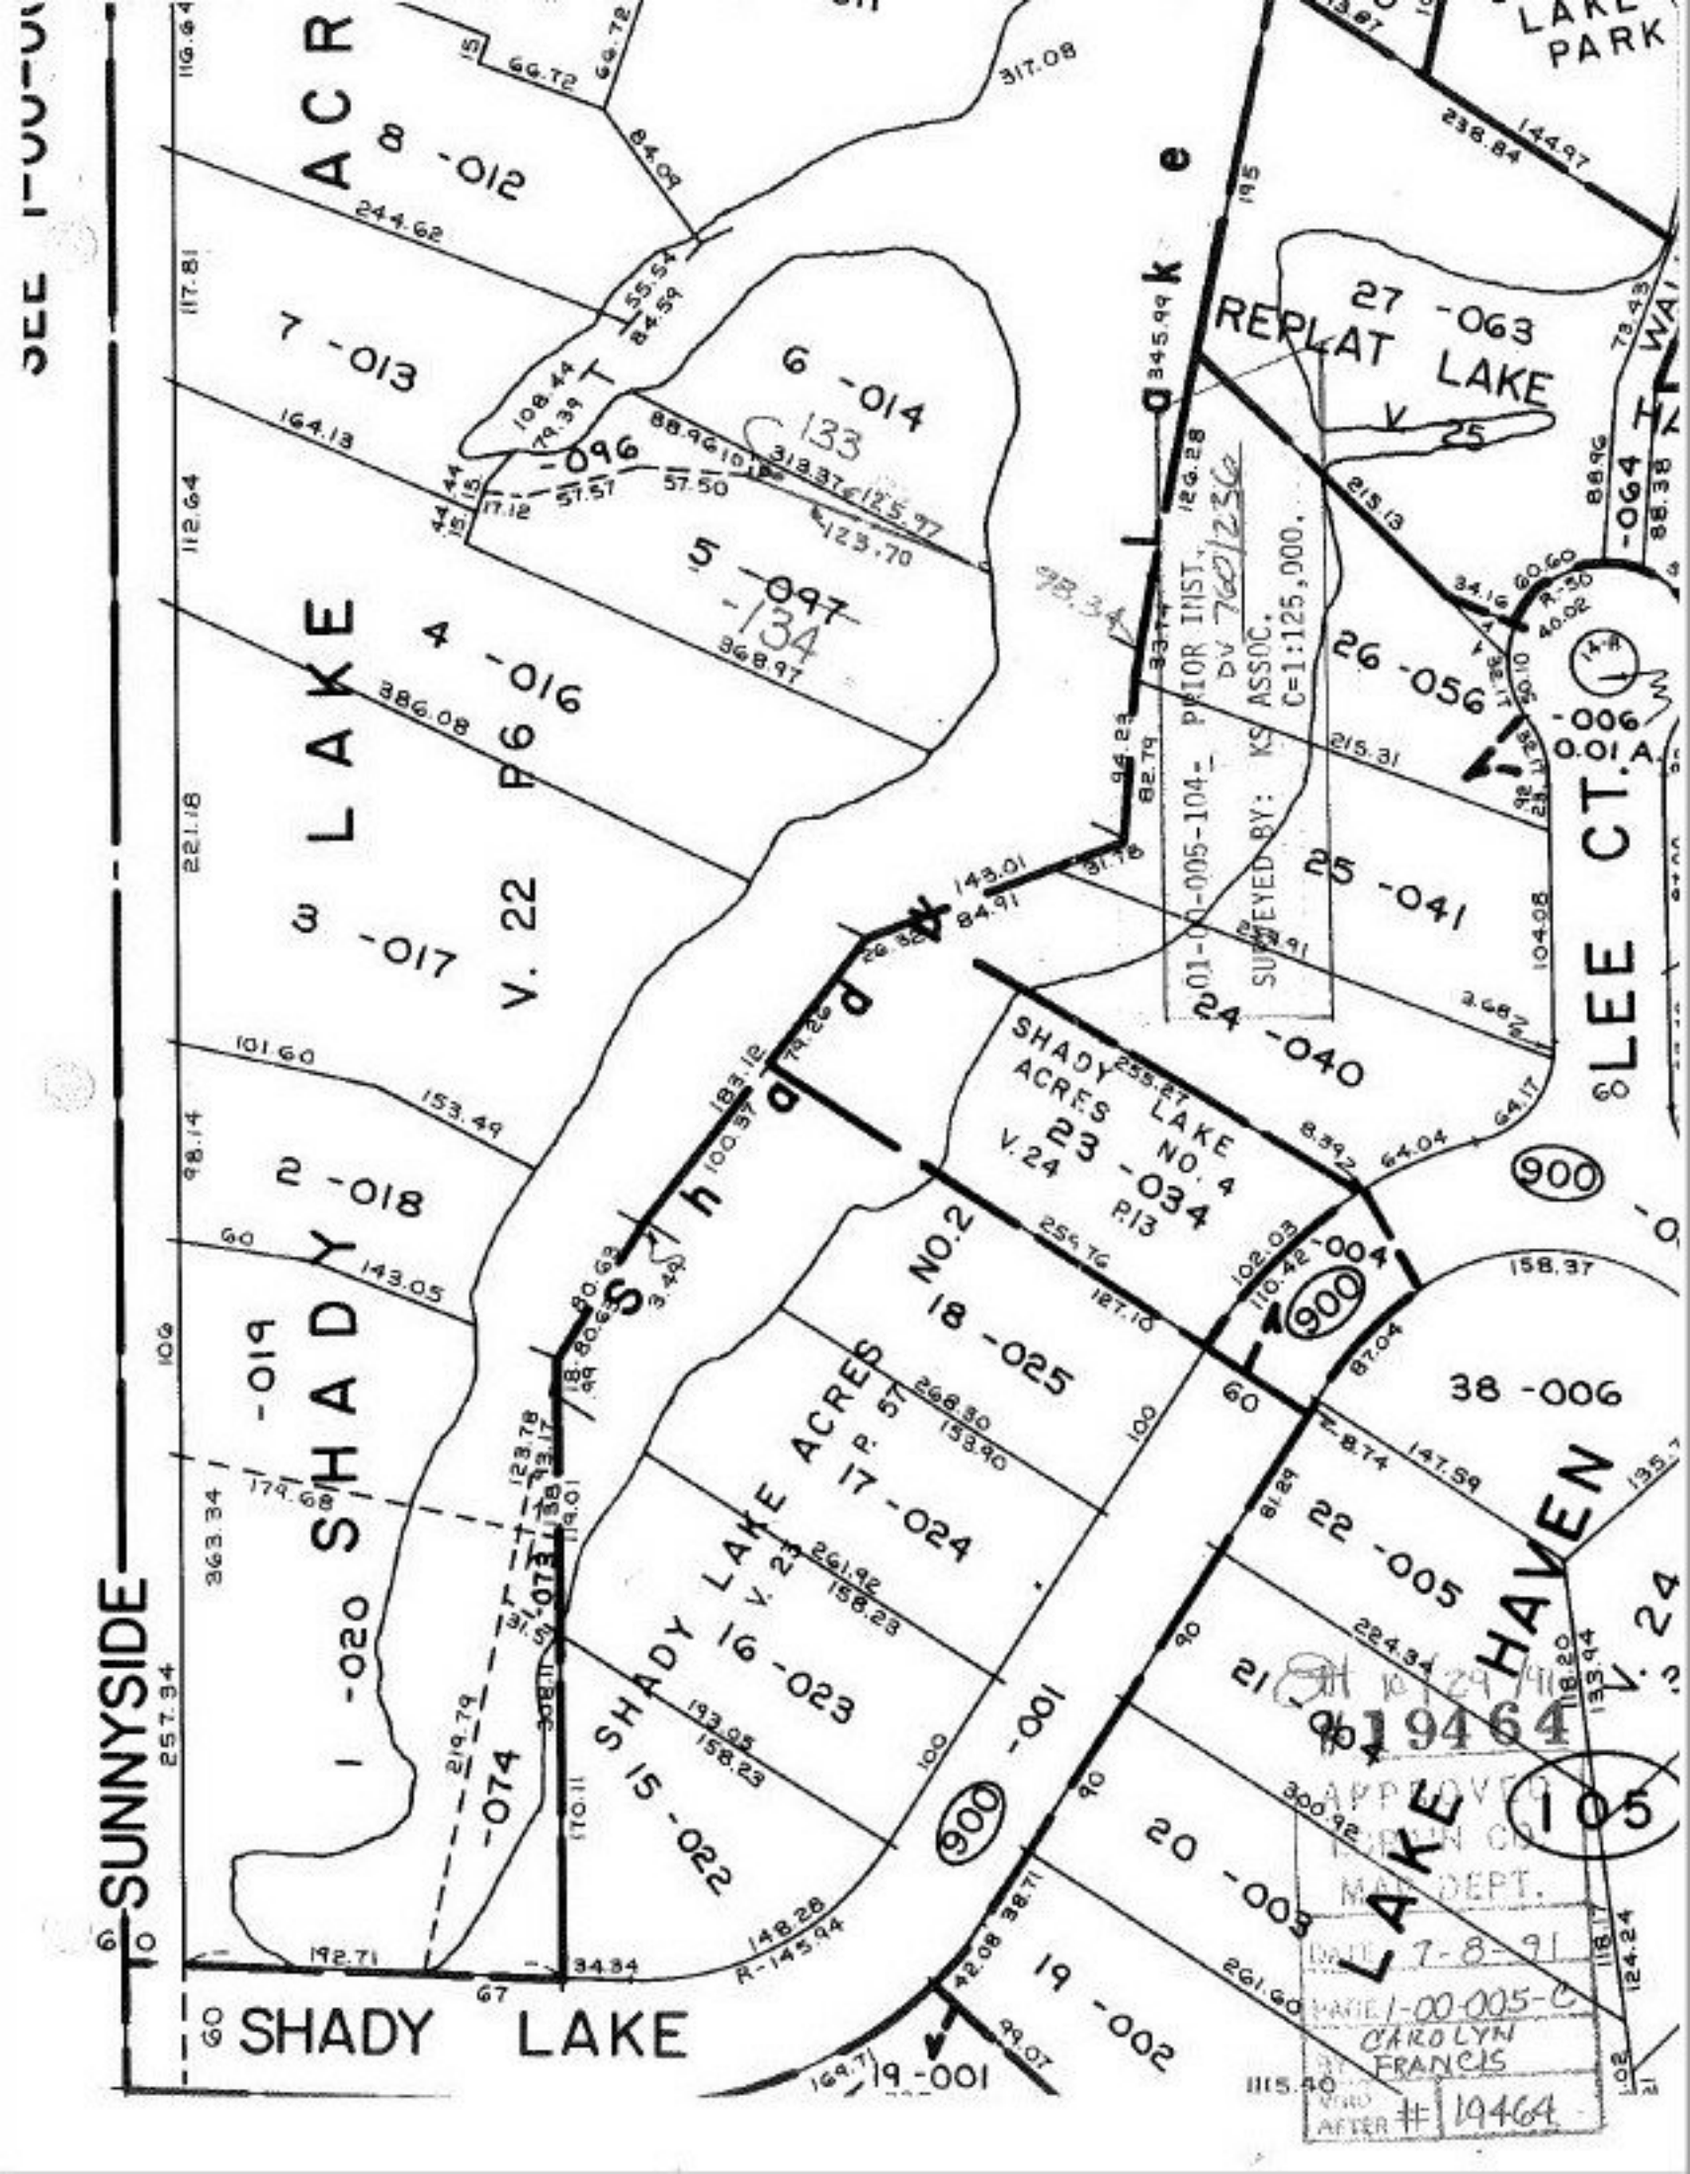
SEE I-00-0
SUNNYSIDE
SHADY LAKE
SHADY LAKE ACRES
SHADY LAKE ACRES NO.2
SHADY LAKE ACRES NO. 4
REPLAT LAKE
LAKE HAVEN
LEE CT.
LAKE
8 -012
7 -013
6 -014
5 -097
-134
4 -016
3 -017
V. 22
P 6
2 -018
1 -020
-019
-074
-073
-096
-133
27 -063
V 25
-064
26 -056
-006
0.01 A
25 -041
24 -040
23 -034
V.24
P.13
-004
18 -025
17 -024
16 -023
15 -022
-001
38 -006
22 -005
21 -00
20 -003
19 -002
19 -001
19464
APPROVED
MAP DEPT.
DATE 7-8-91
MAP# 1-00-005-C
CAROLYN FRANCIS
RTD AFTER # 19464
SURVEYED BY: KS ASSOC.
C=1:125,000.
PRIOR INST. DV 760/236
900
-105