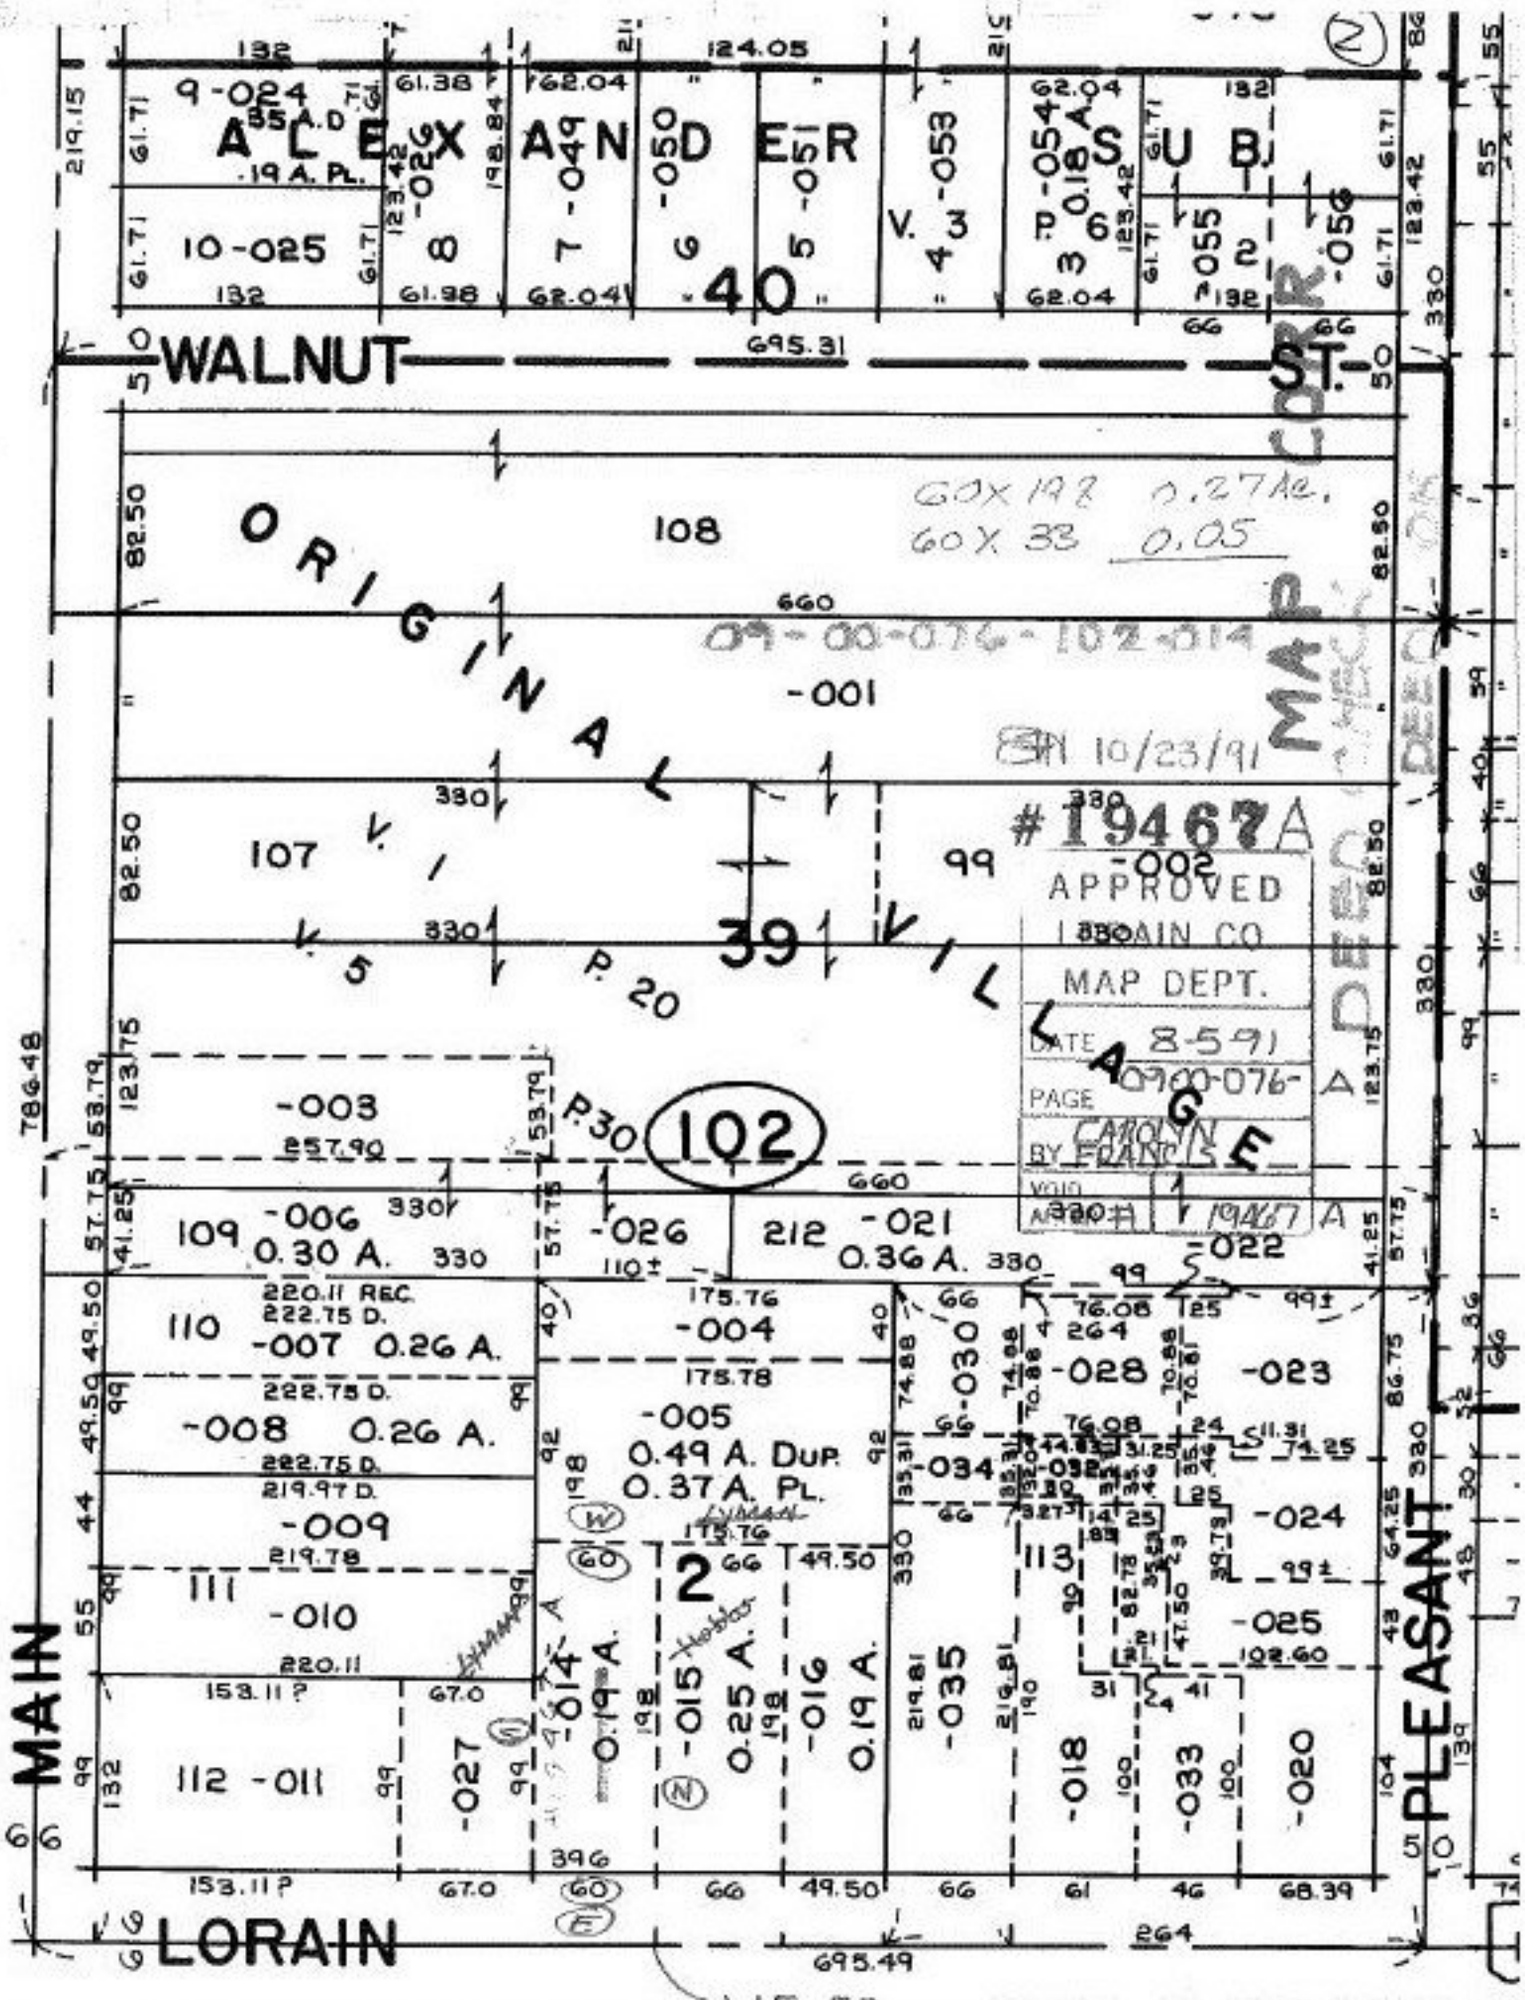

P.P. NO 09-00-076-102-014 IS BEING CHANGE FROM A.C. TO FRONTAGE & DEPTH

PRIOR INST. 1234/42