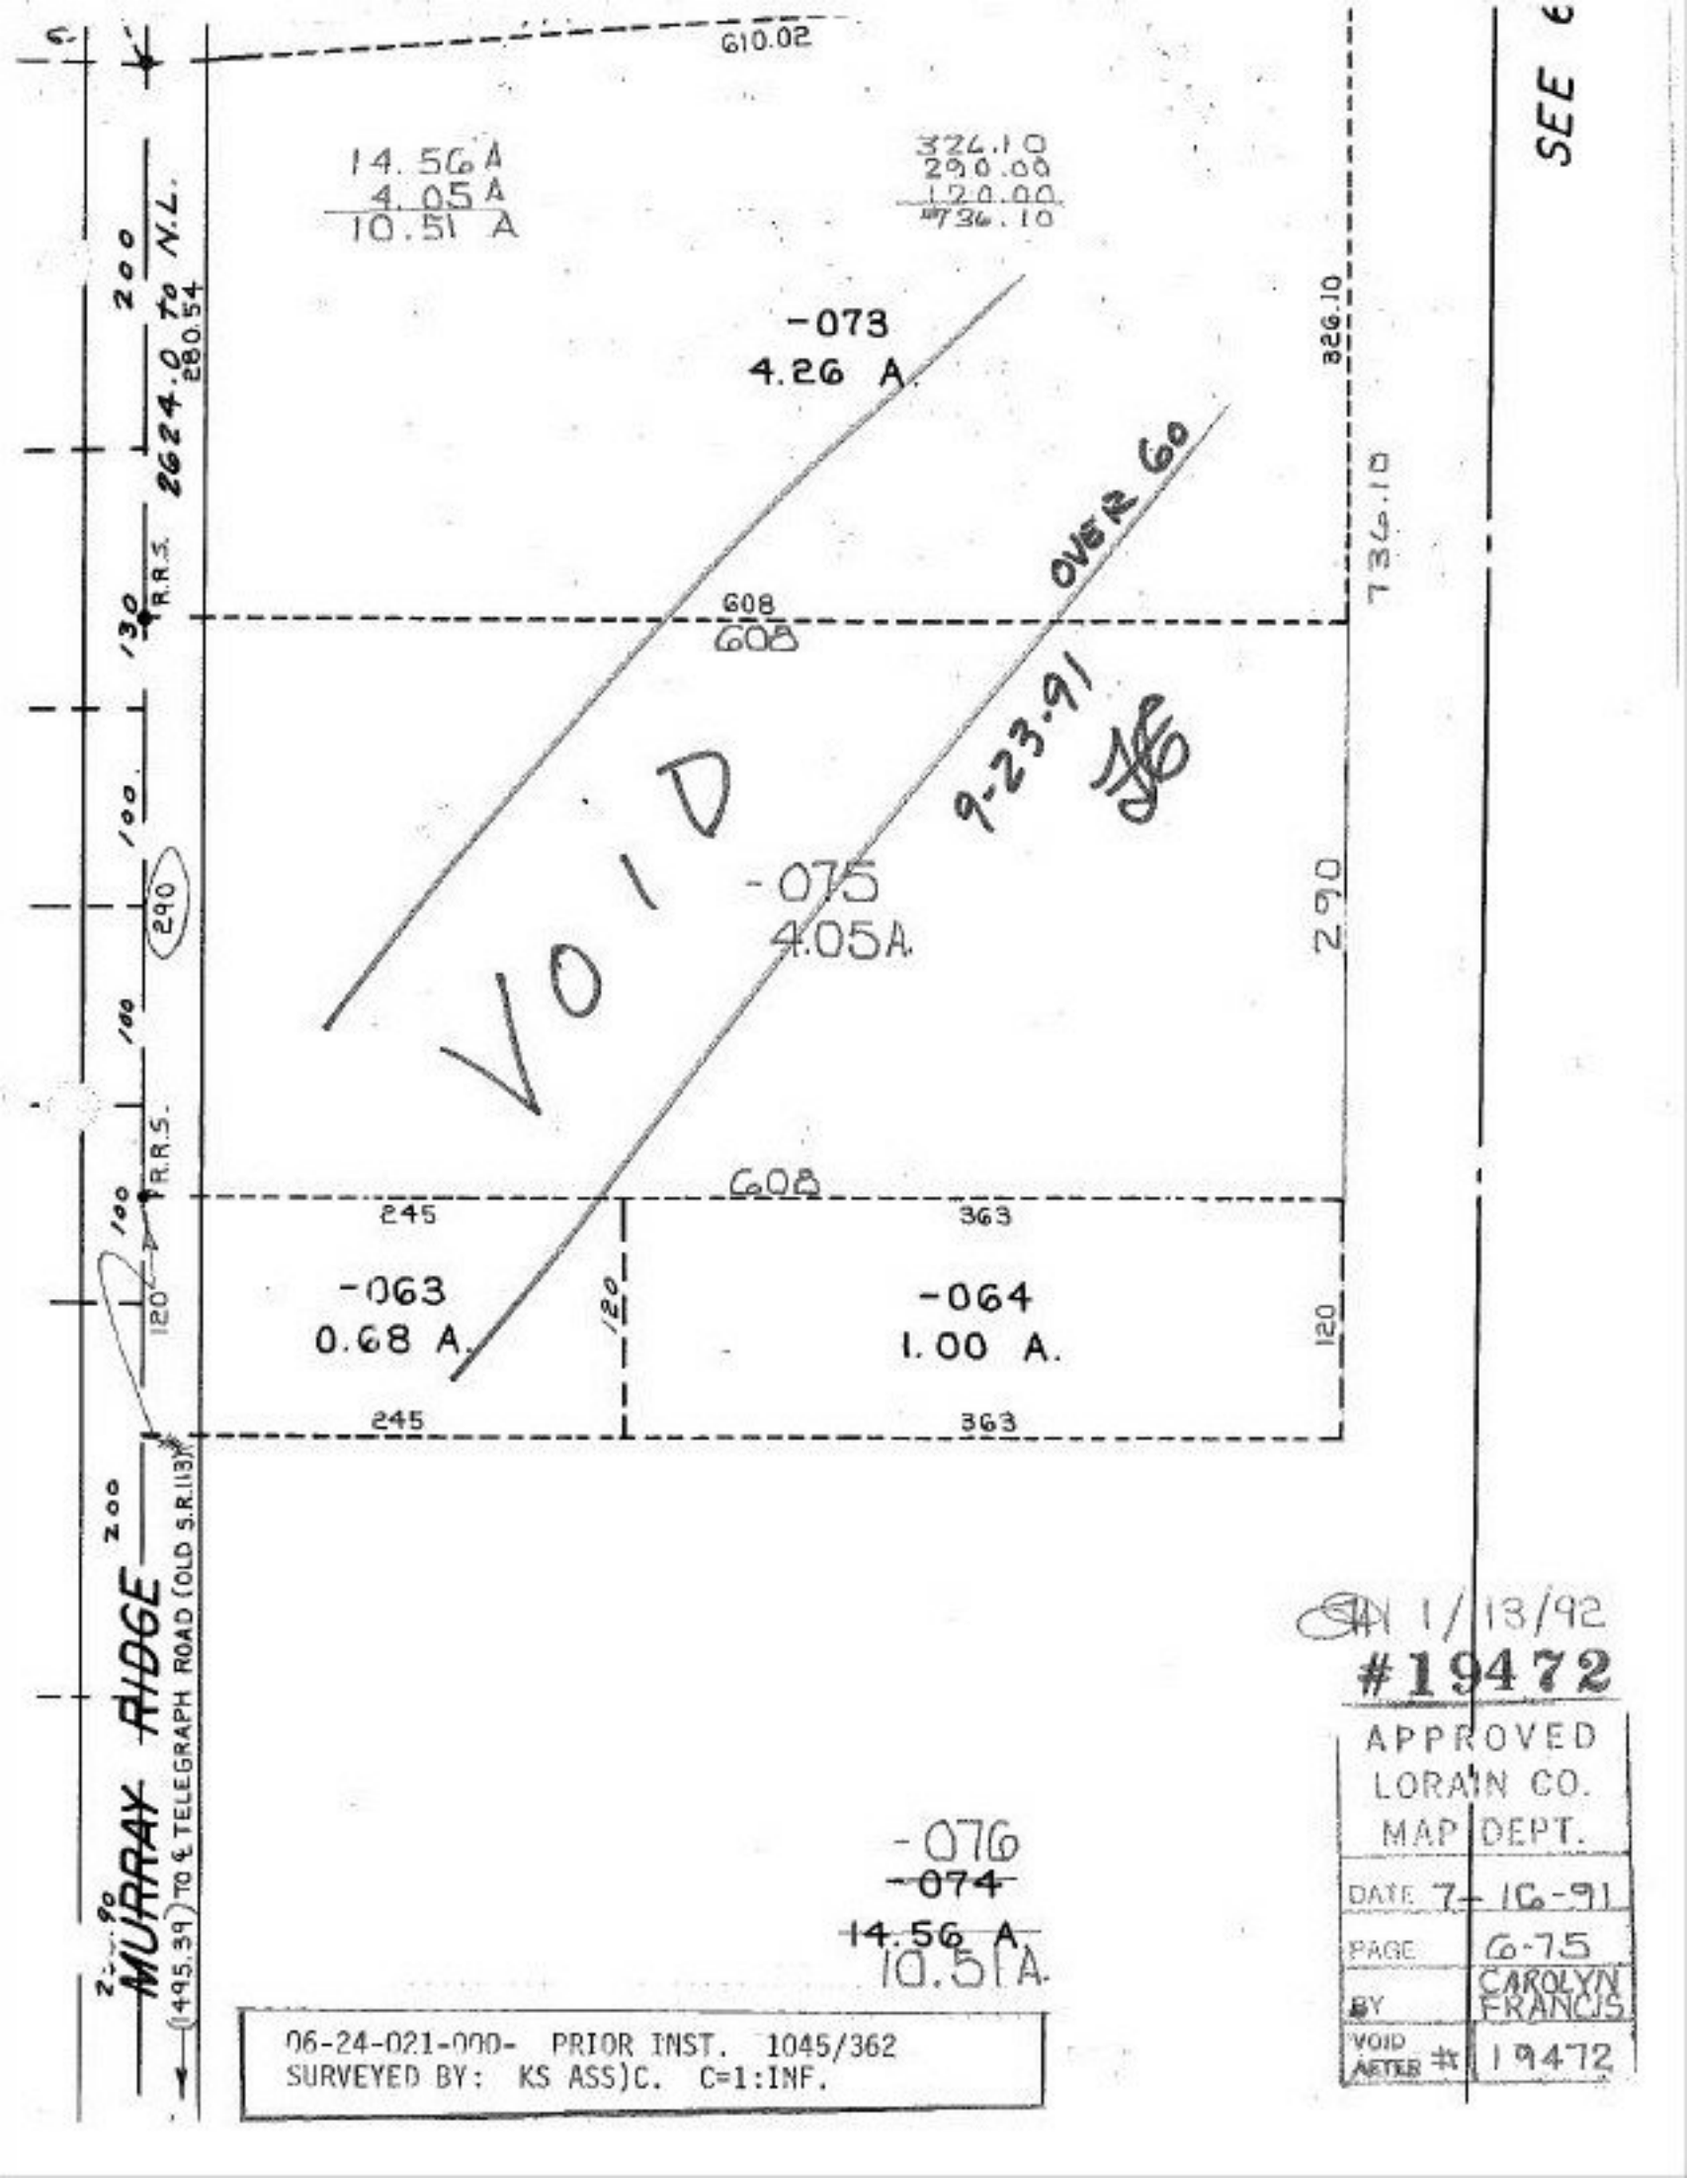
610.02
14.56 A
4.05 A
10.51 A
324.10
290.00
120.00
736.10
-073
4.26 A.
OVER 60
826.10
736.10
2624.0 to N.L.
280.54
200
130
R.R.S.
608
608
9-23-91
VOID
-075
4.05A.
290
100
290
100
R.R.S.
608
245
363
-063
0.68 A.
120
-064
1.00 A.
120
245
363
MURRAY RIDGE
200
(495.39) TO ℄ TELEGRAPH ROAD (OLD S.R.113)
-076
-074
14.56 A
10.51A.
06-24-021-000- PRIOR INST. 1045/362
SURVEYED BY: KS ASS)C. C=1:INF.
SEE
1/13/92
#19472
APPROVED
LORAIN CO.
MAP DEPT.
DATE 7-16-91
PAGE 6-75
BY CAROLYN FRANCIS
VOID AFTER # 19472