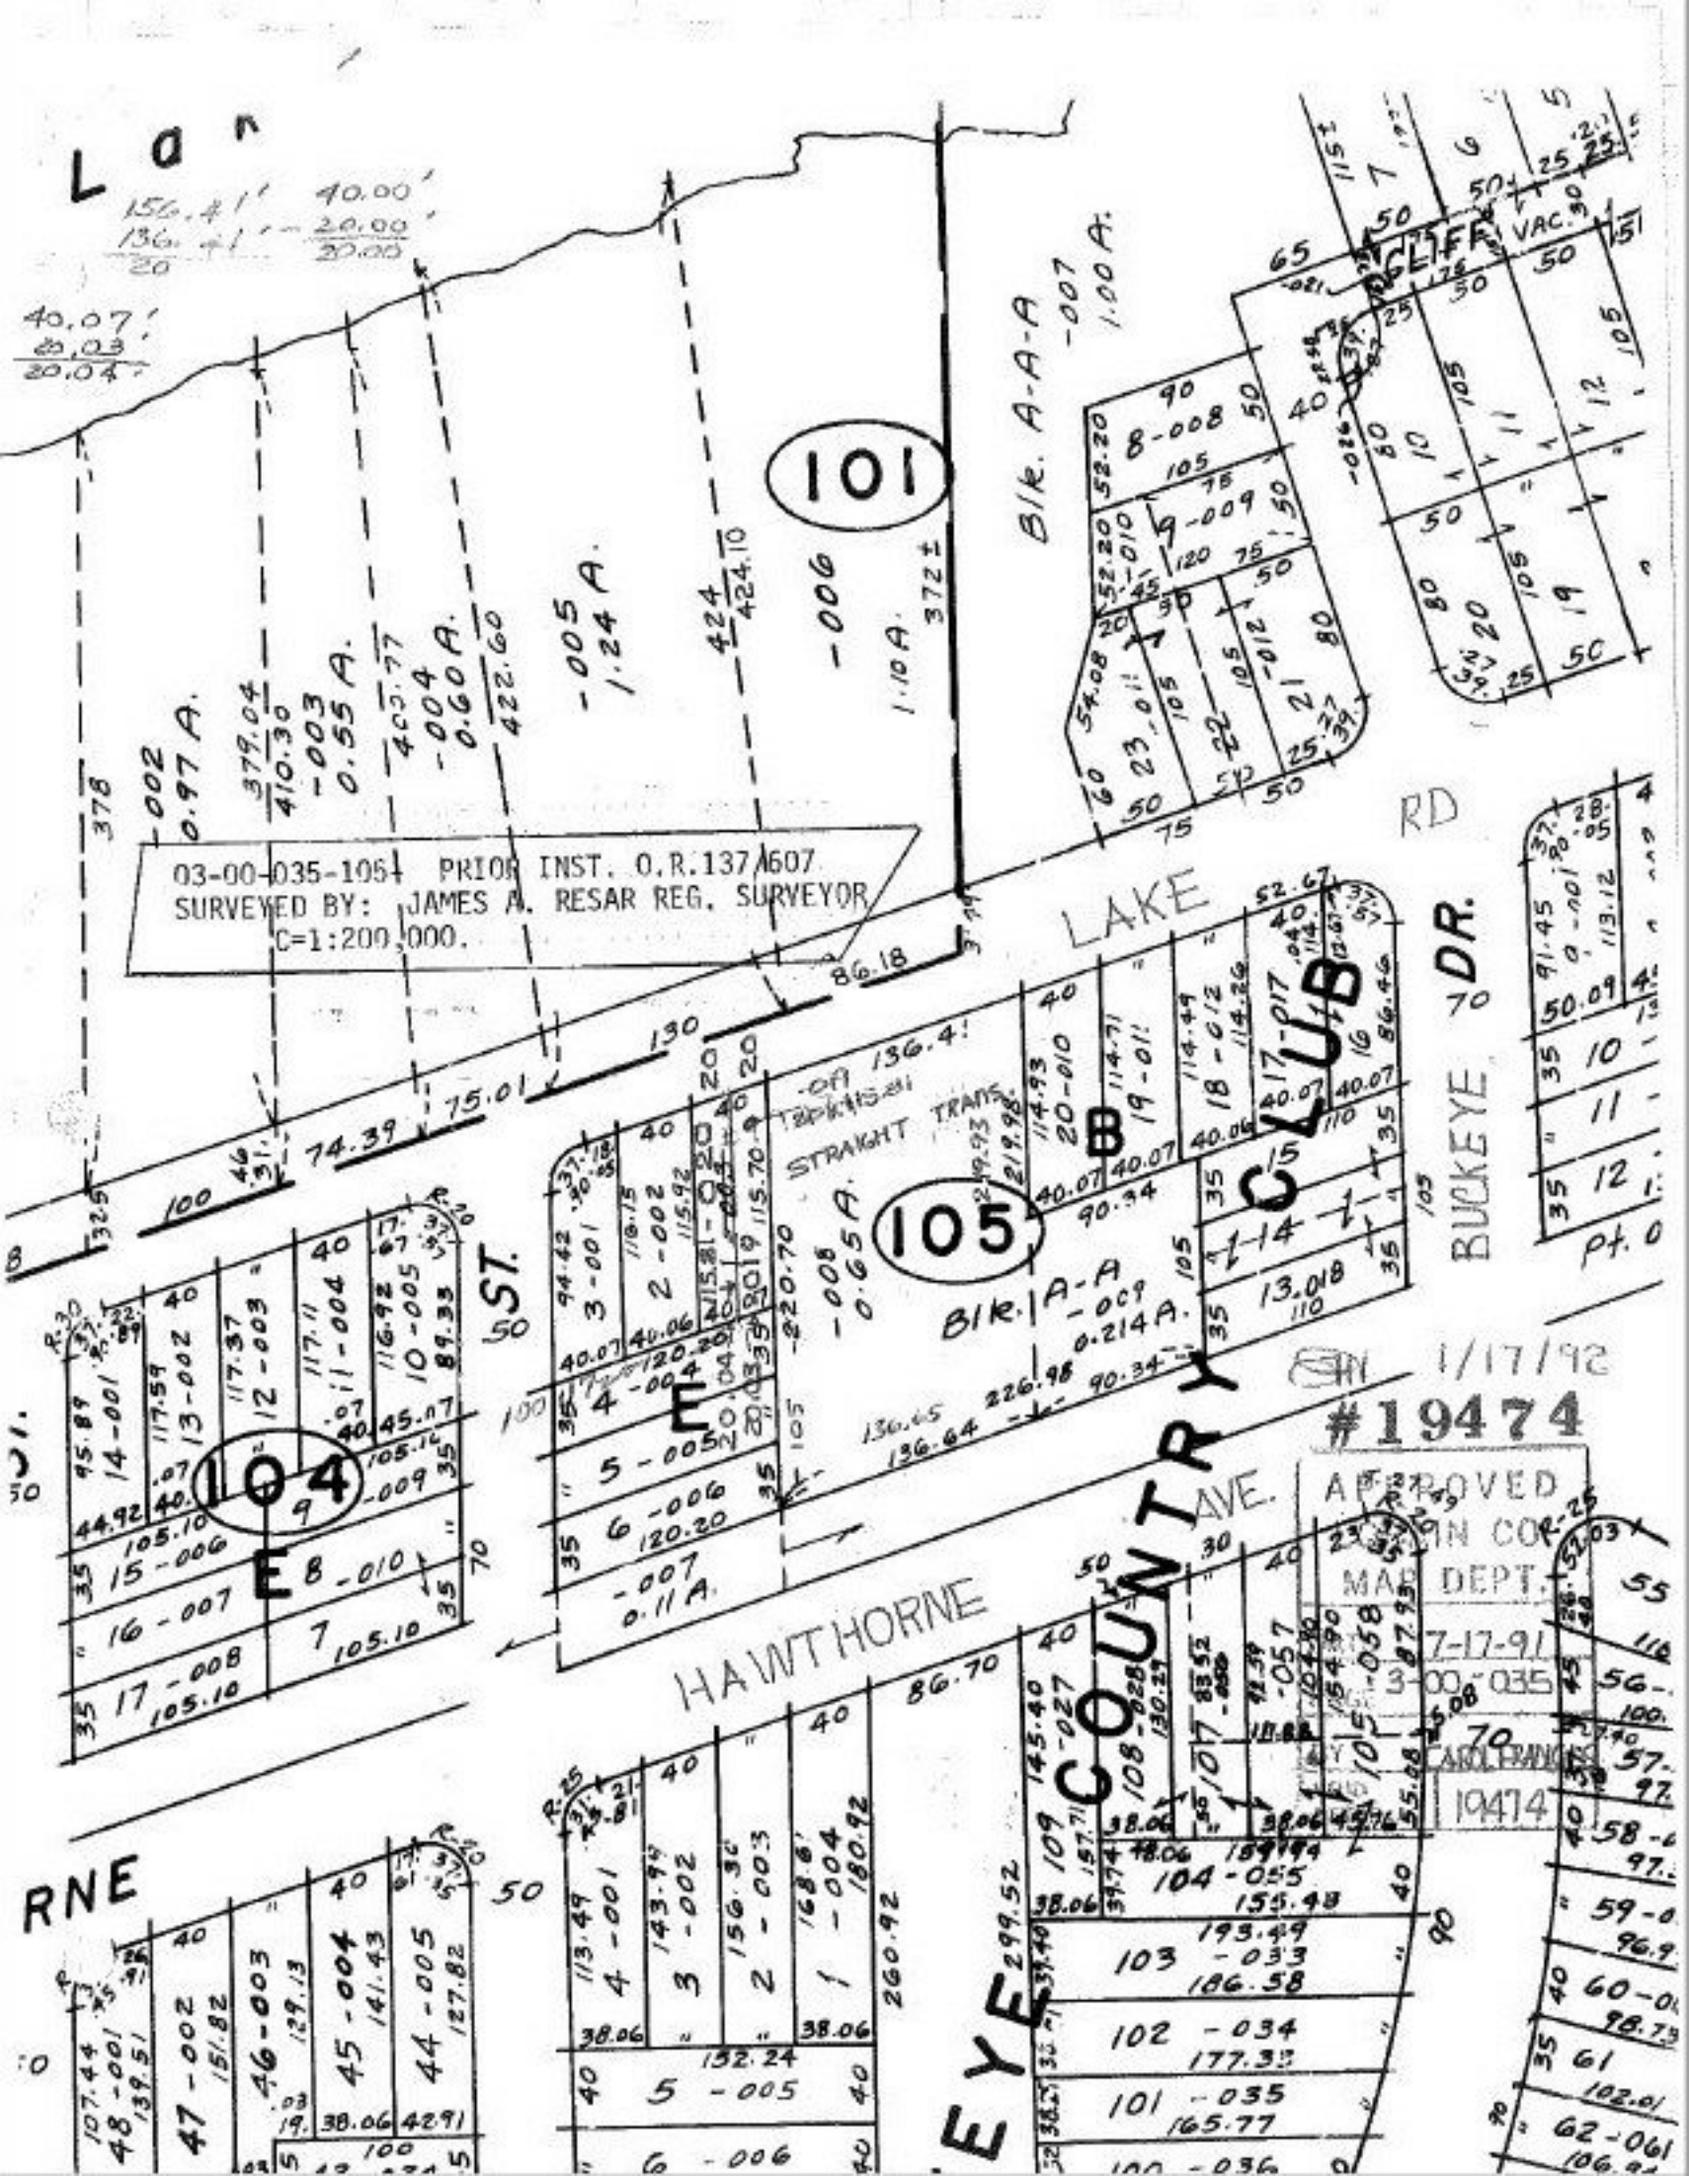

03-00-035-105 PRIOR INST. O.R.137/607
SURVEYED BY: JAMES A. RESAR REG. SURVEYOR
C=1:200,000.
101
105
104
LAKE
RD
BUCKEYE DR.
HAWTHORNE
AVE.
ST.
RNE
COUNTRY CLUB
STRAIGHT TRANS.
Blk. A-A-A
Blk. A-A
CLIFF
VAC.
#19474
APPROVED
MAP DEPT.
7-17-91
3-00-035
CAROL FRANCIS
19474
1/17/92