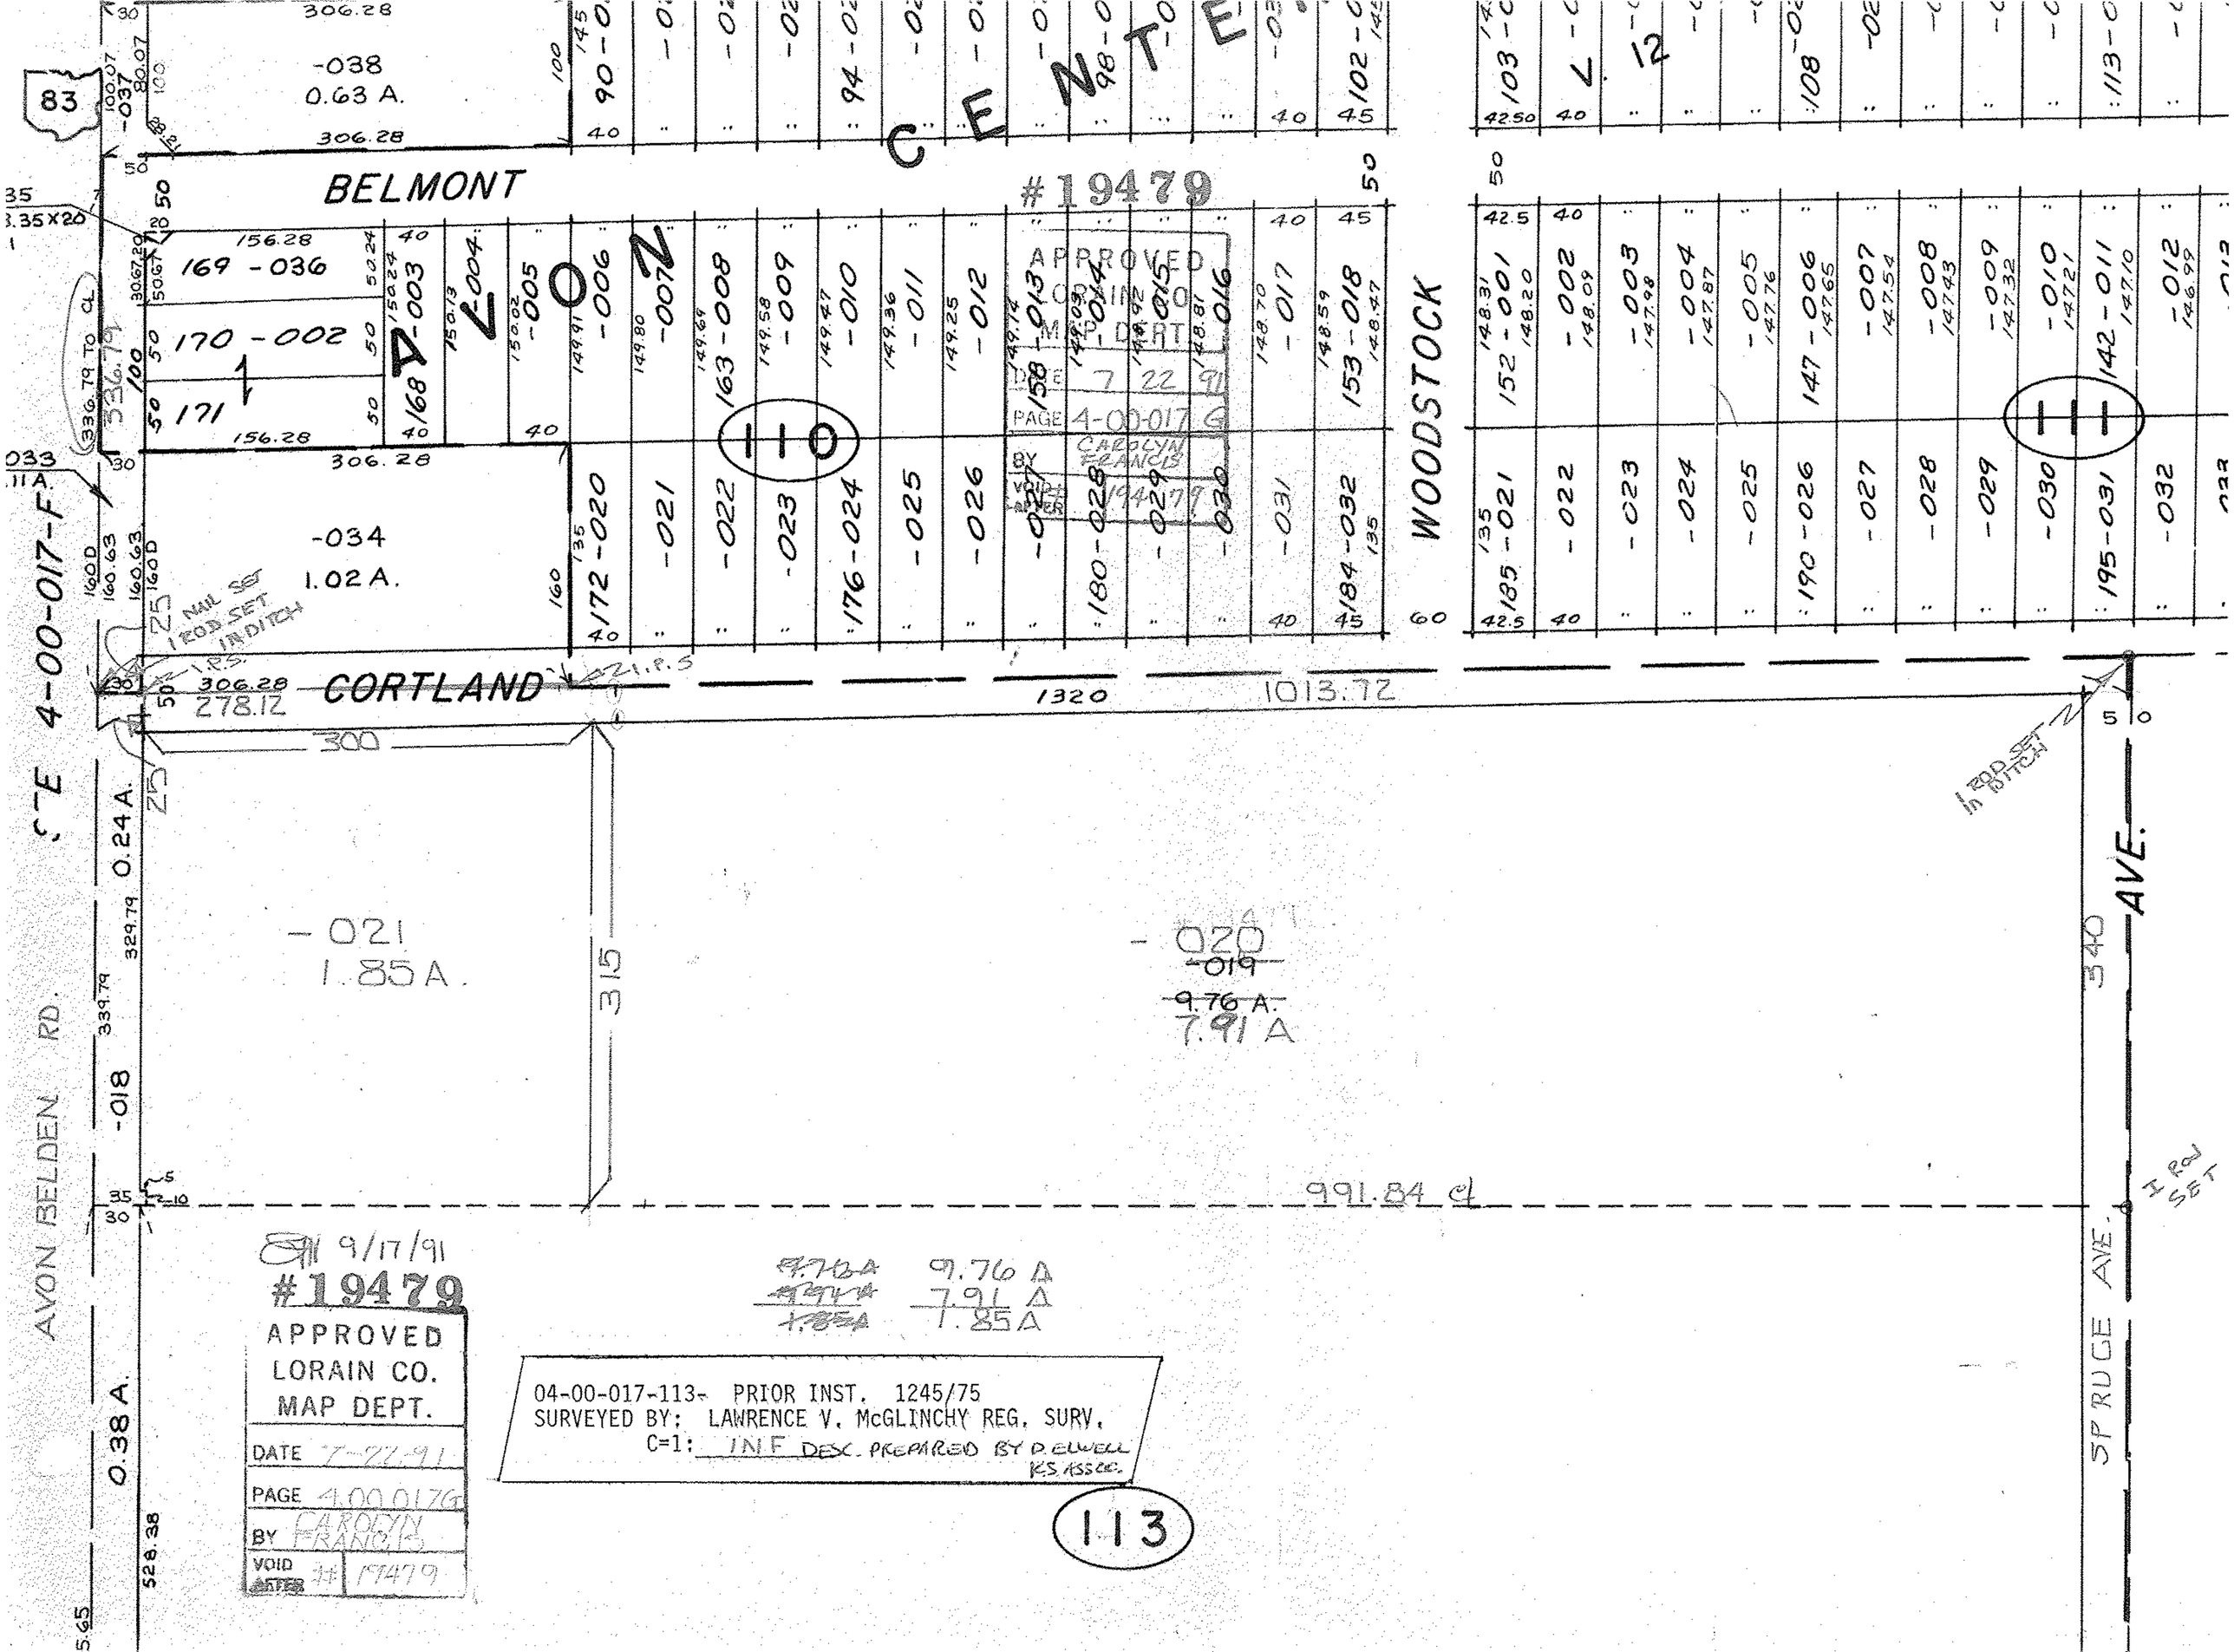

9/17/91

#19479

APPROVED
LORAIN CO.
MAP DEPT.

DATE 7-22-91
PAGE 4.00.017G
BY CAROLYN FRANCIS
VOID AFTER # 19479

~~9.76 A~~ 9.76 A
~~7.91 A~~ 7.91 A
~~1.85 A~~ 1.85 A

04-00-017-113- PRIOR INST. 1245/75
SURVEYED BY: LAWRENCE V. McGLINCHY REG. SURV.
C=1: INF DESC. PREPARED BY D. ELWELL K.S. ASSOC.