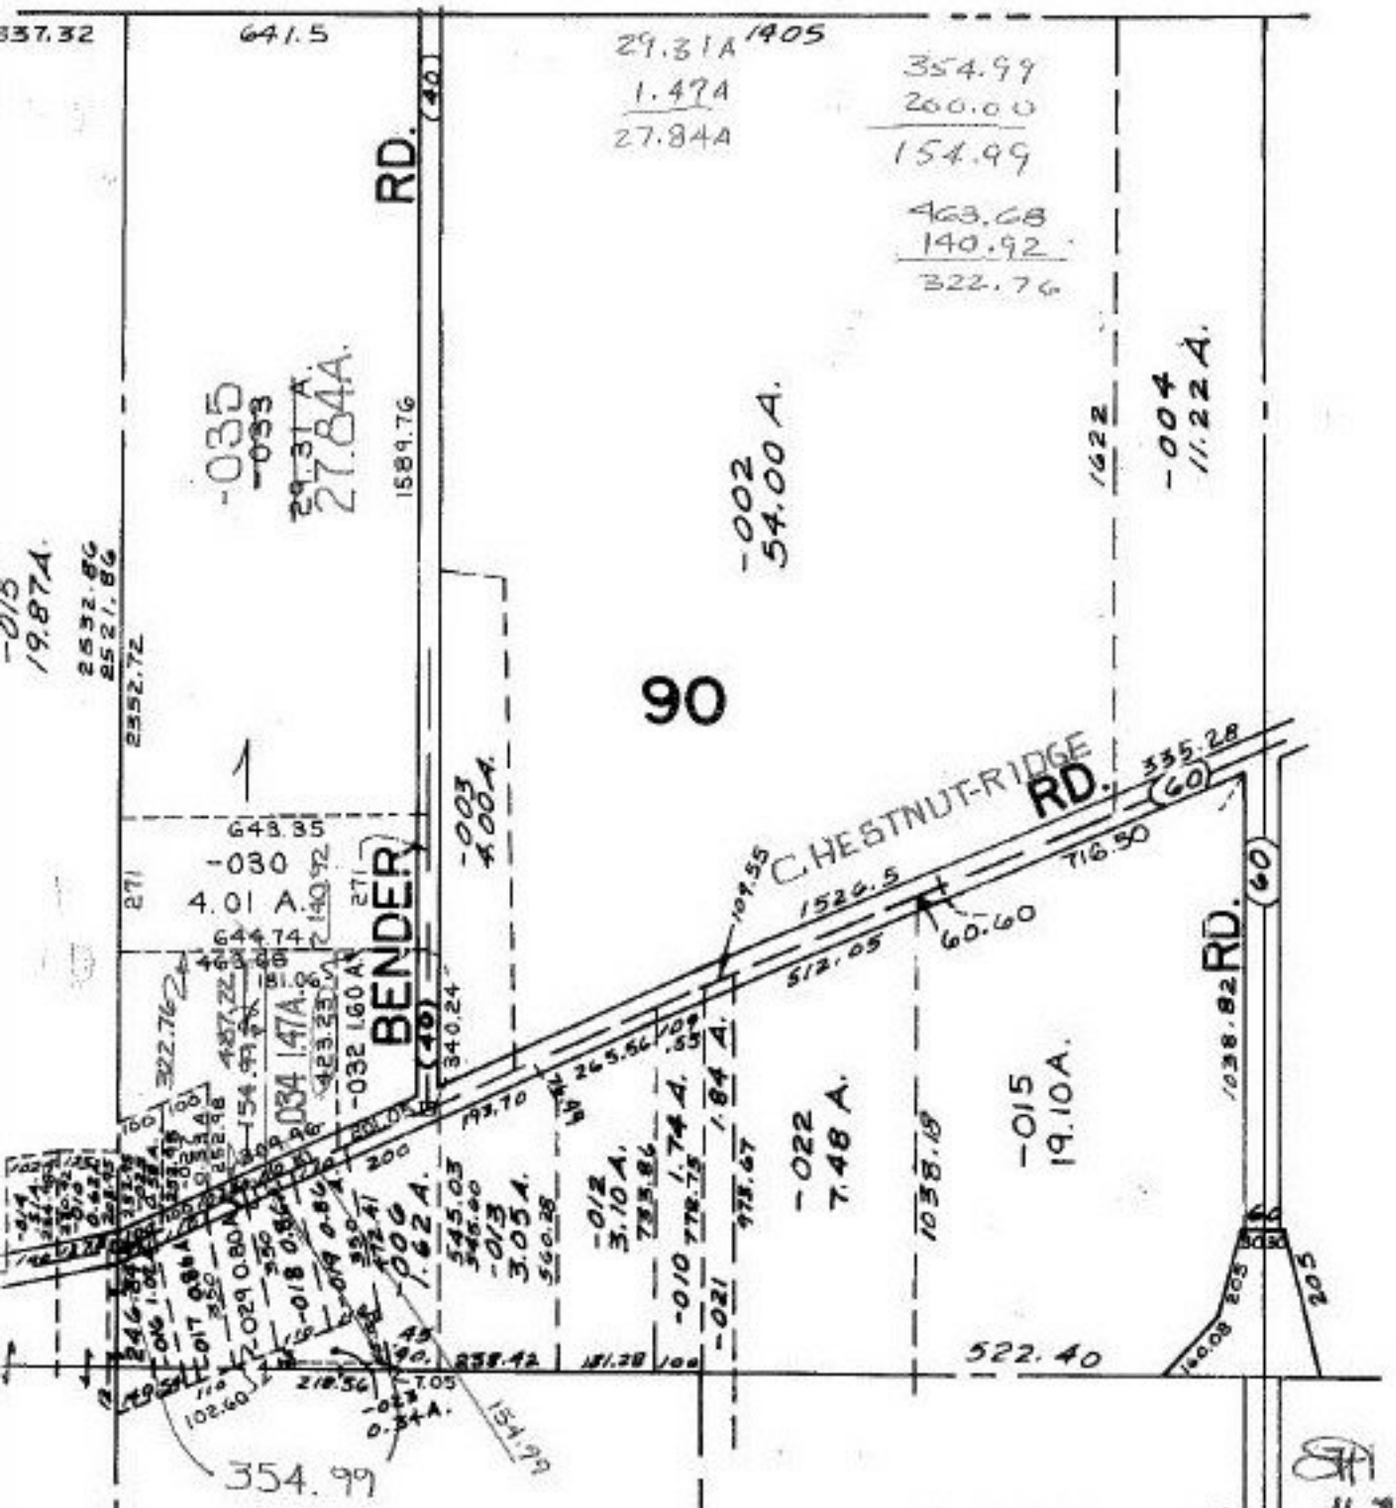

8/27/92

#19480

APPROVED
LORAIN CO.
MAP DEPT.

DATE 7-23-91

PAGE 11-A

BY CAROLYN FRANCIS

VOID AFTER # 19480.