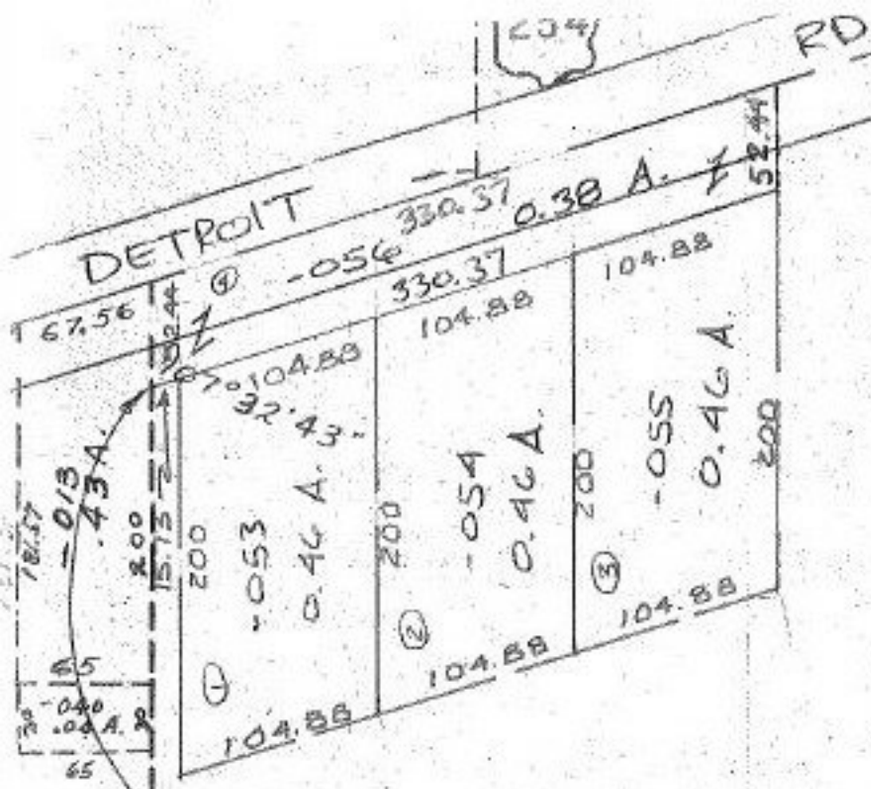

SEE SURVEY BY
VIRGIL D. LANDIS
SHAFFNER, JOHNSTON, LICHTENWALTER & ASSOC., INC.
CL ON ALL 4 PARCELS 1:1NF

PRIOR INST. REF - OR 259/501

~~-050~~
~~42.64 A.~~

-057
40.88 A.

#19481

102

~~-050~~
~~42.64 A.~~

9/17/91
#19481

APPROVED
LORAIN CO.
MAP DEPT.
DATE 7/29/91
PAGE 4.00 027-F
BY T. McMains
SEQ. NO. 19481

1502.36
1709.37
1654.93