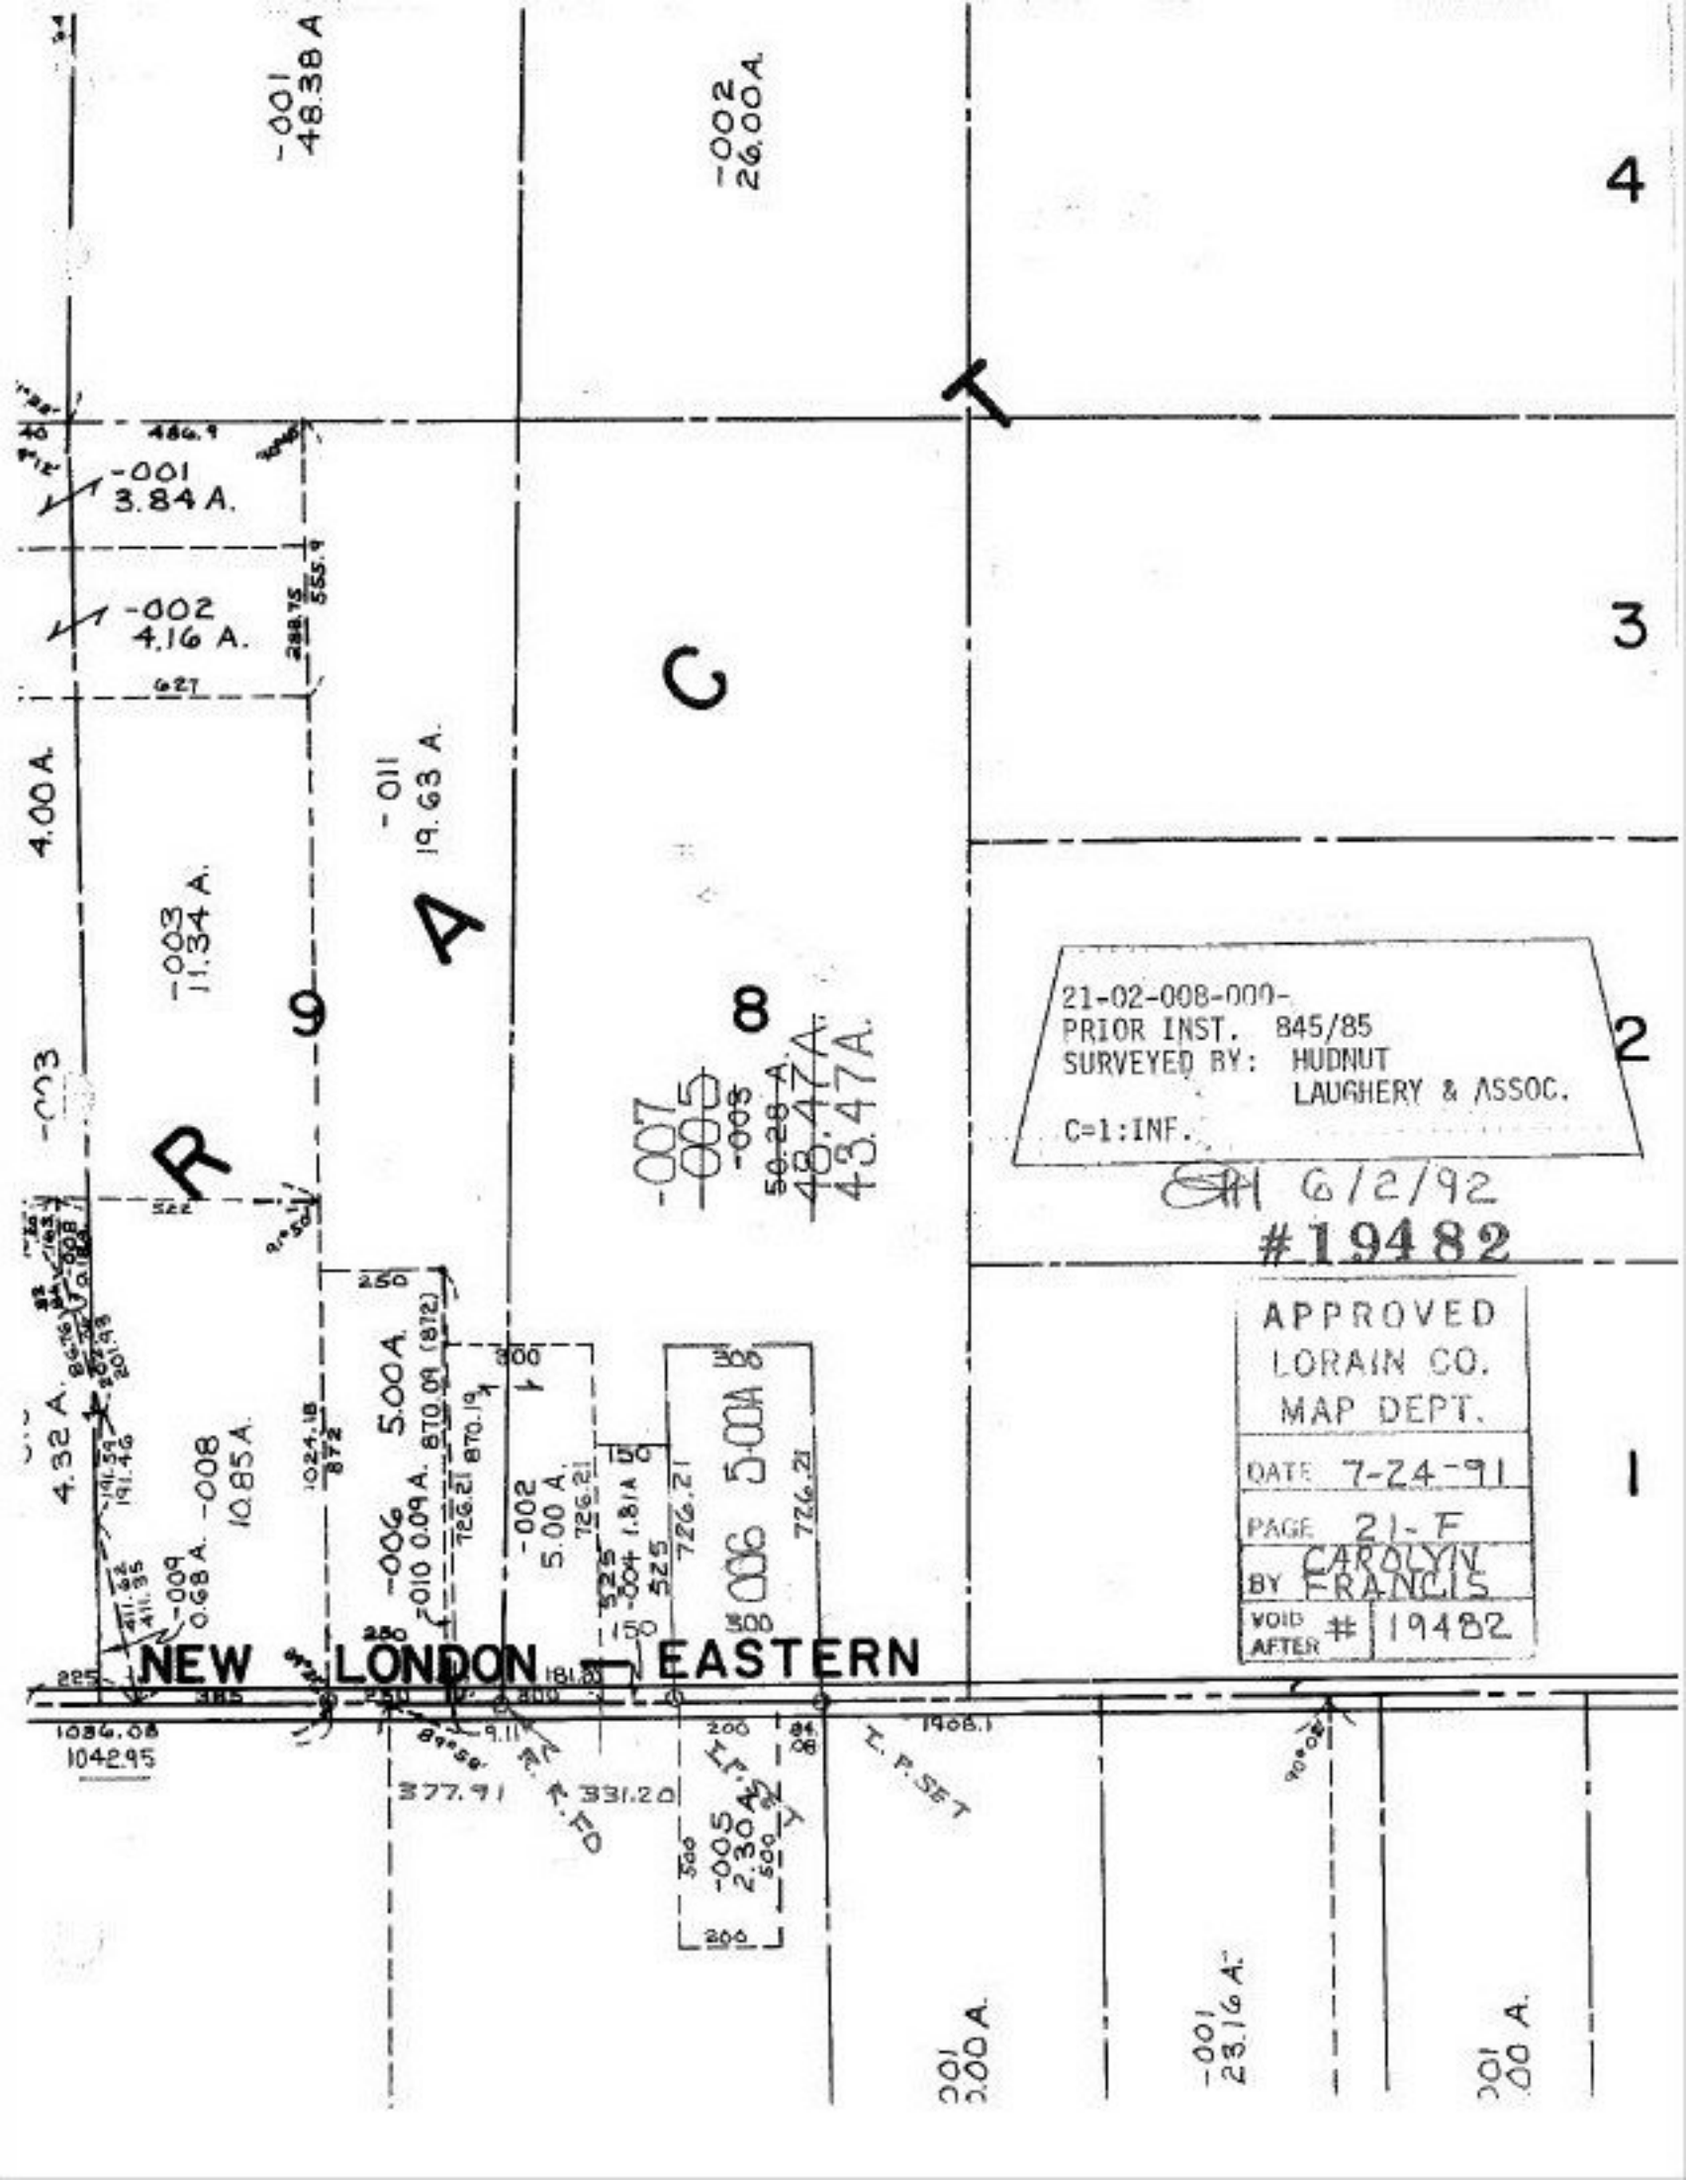
-001
48.38 A.
-002
26.00A.
4
T
-001
3.84 A.
-002
4.16 A.
3
C
-011
19.63 A.
4.00 A.
-003
11.34 A.
9
A
8
-007
-005
-003
50.28 A.
43.47A.
2
21-02-008-000-
PRIOR INST. 845/85
SURVEYED BY: HUDNUT
LAUGHERY & ASSOC.
C=1:INF.
6/2/92
#19482
APPROVED
LORAIN CO.
MAP DEPT.
DATE 7-24-91
PAGE 21-F
BY CAROLYN FRANCIS
VOID AFTER # 19482
1
R
-003
4.32 A.
-008
10.85A.
-009
0.68 A.
-006
5.00A.
-010 0.09 A.
-002
5.00 A.
-004 1.81A
-006 5.00A
NEW LONDON EASTERN
1084.08
1042.95
377.91
331.20
-005
2.30 A.
1908.1
-001
23.16 A.
3.00 A.