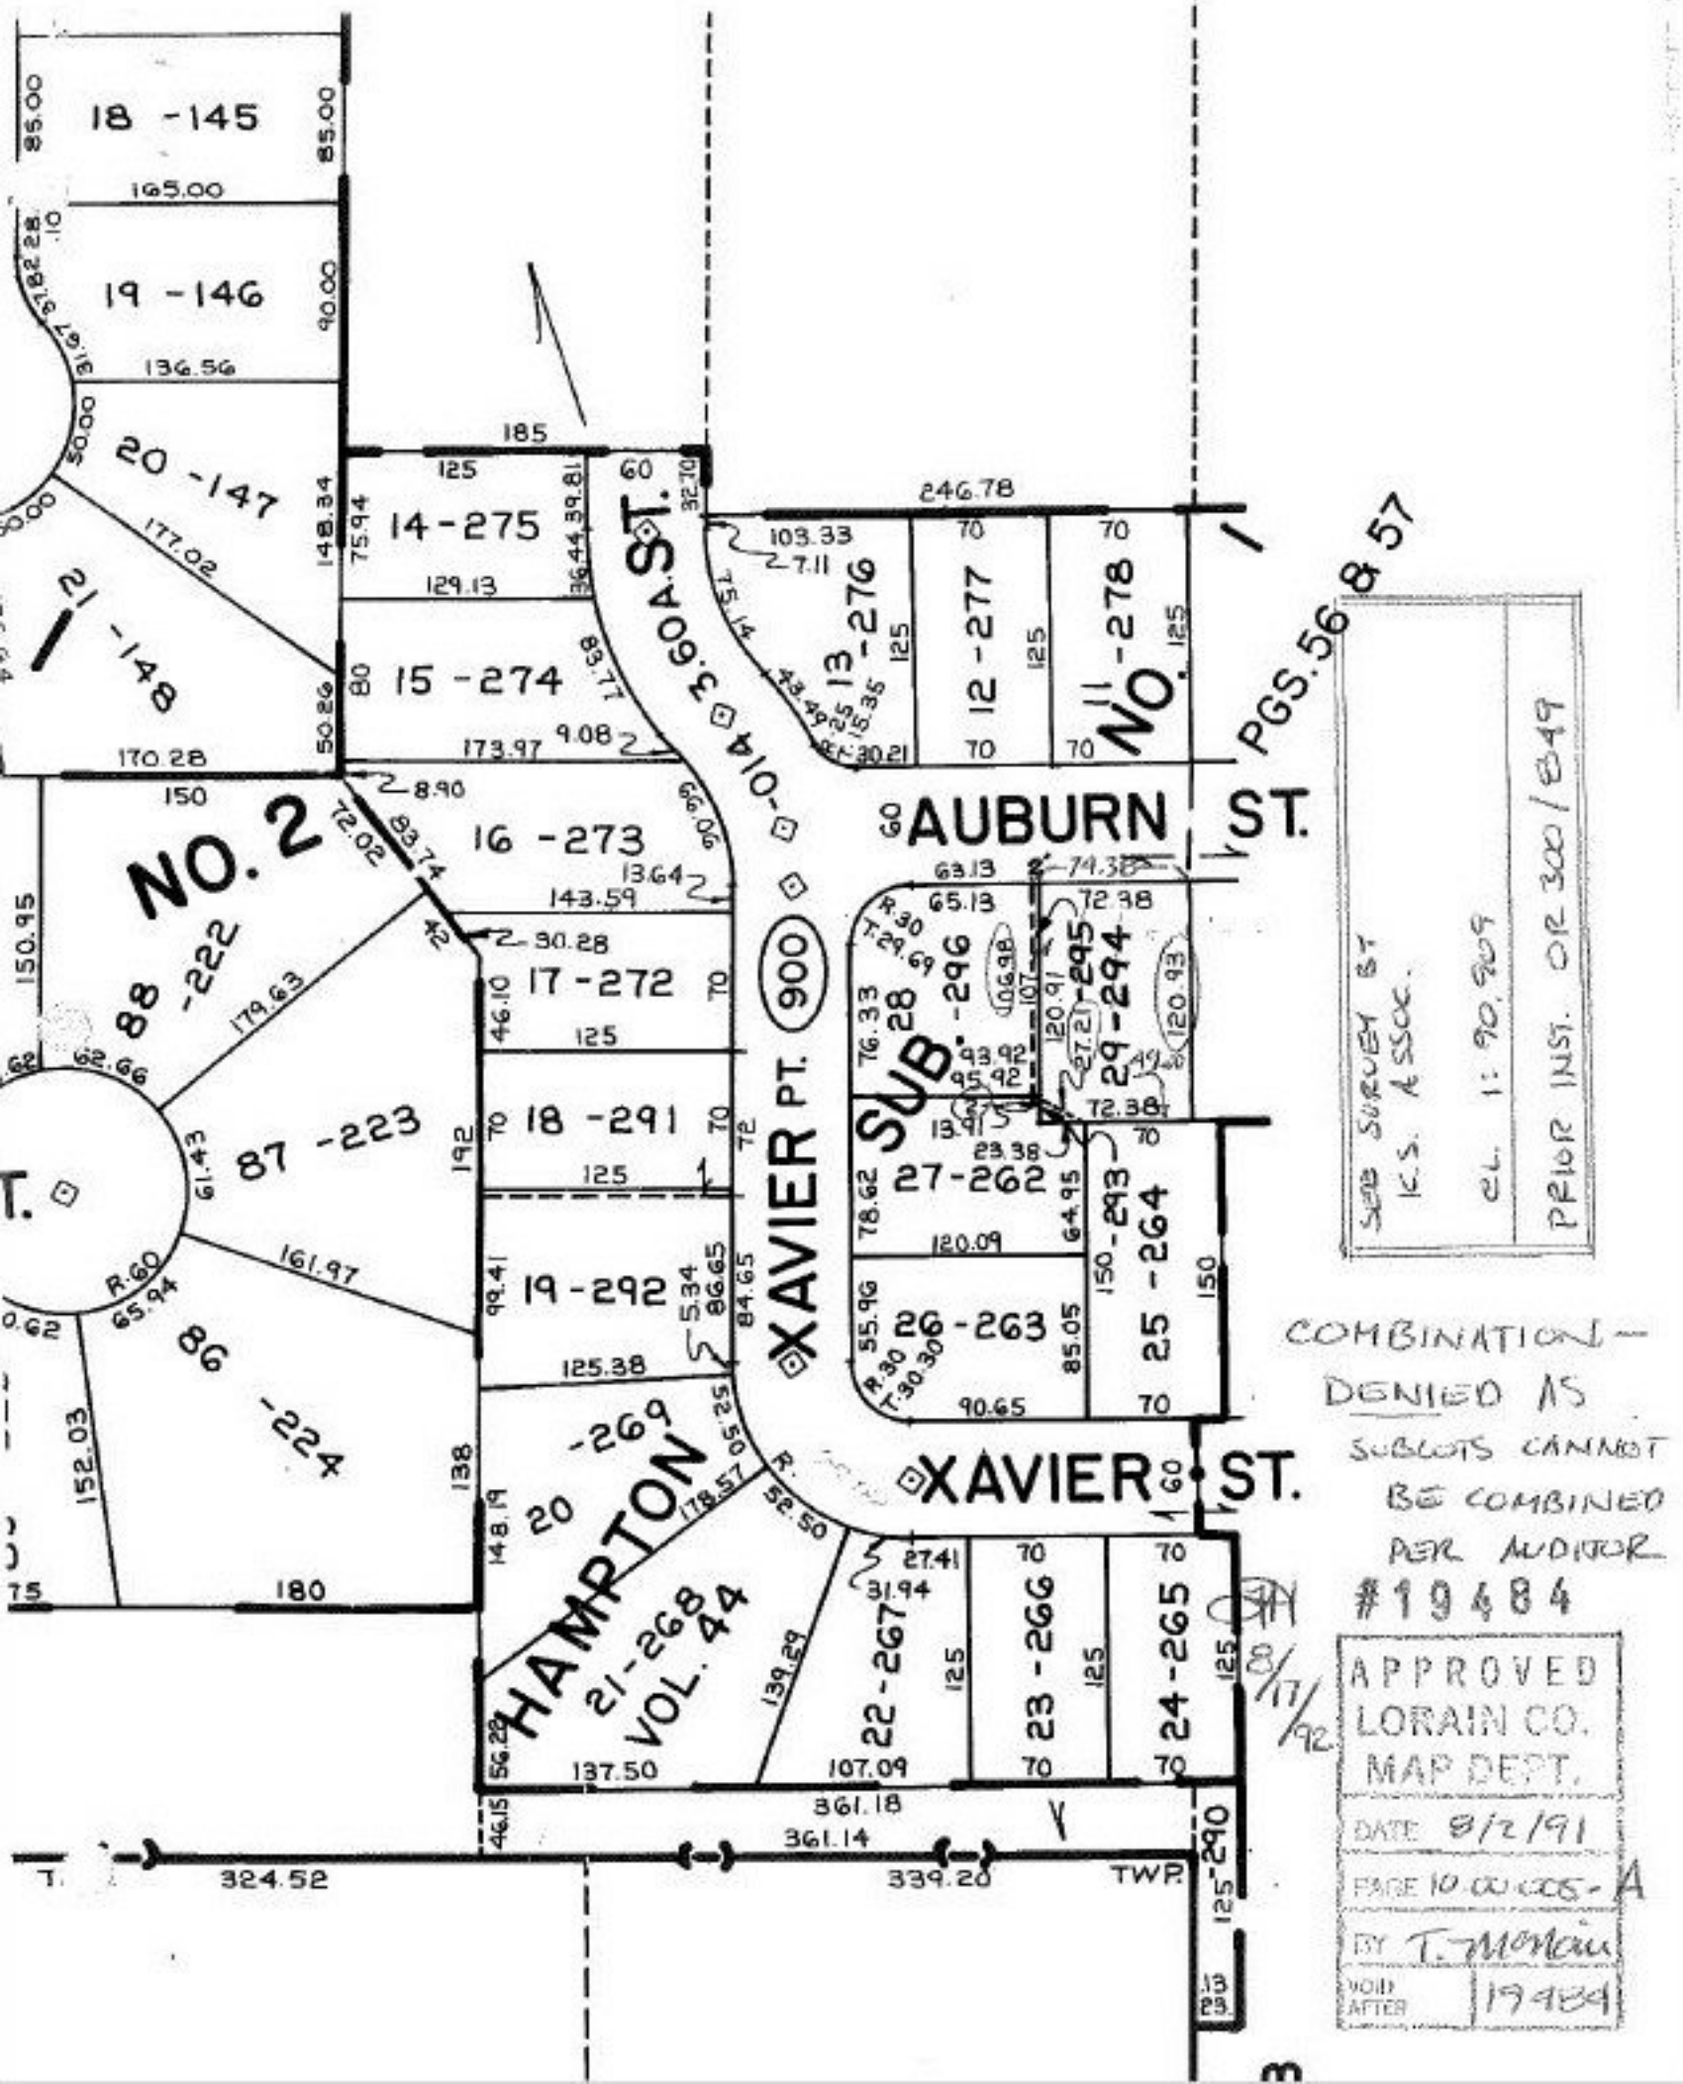

18 -145
19 -146
20 -147
21 -148
14 -275
15 -274
16 -273
17 -272
18 -291
19 -292
20 -269
21 -268
VOL. 44
22 -267
23 -266
24 -265
25 -264
26 -263
27 -262
28 -296
29 -294
13 -276
12 -277
11 -278
NO. 2
88 -222
87 -223
86 -224
AUBURN ST.
XAVIER ST.
XAVIER PT. 900
3.60 A. ST.
HAMPTON
SUB.
NO. 1
PGS. 56 & 57
TWP.
SEE SURVEY BY K.S. ASSOC.
CL. 1: 90,909
PRIOR INST. OR 300/849
COMBINATION — DENIED AS SUBLOTS CANNOT BE COMBINED PER AUDITOR
#19484
APPROVED LORAIN CO. MAP DEPT.
DATE 8/2/91
PAGE 10.00.005-A
BY T. Monain
VOID AFTER 19484
8/17/92