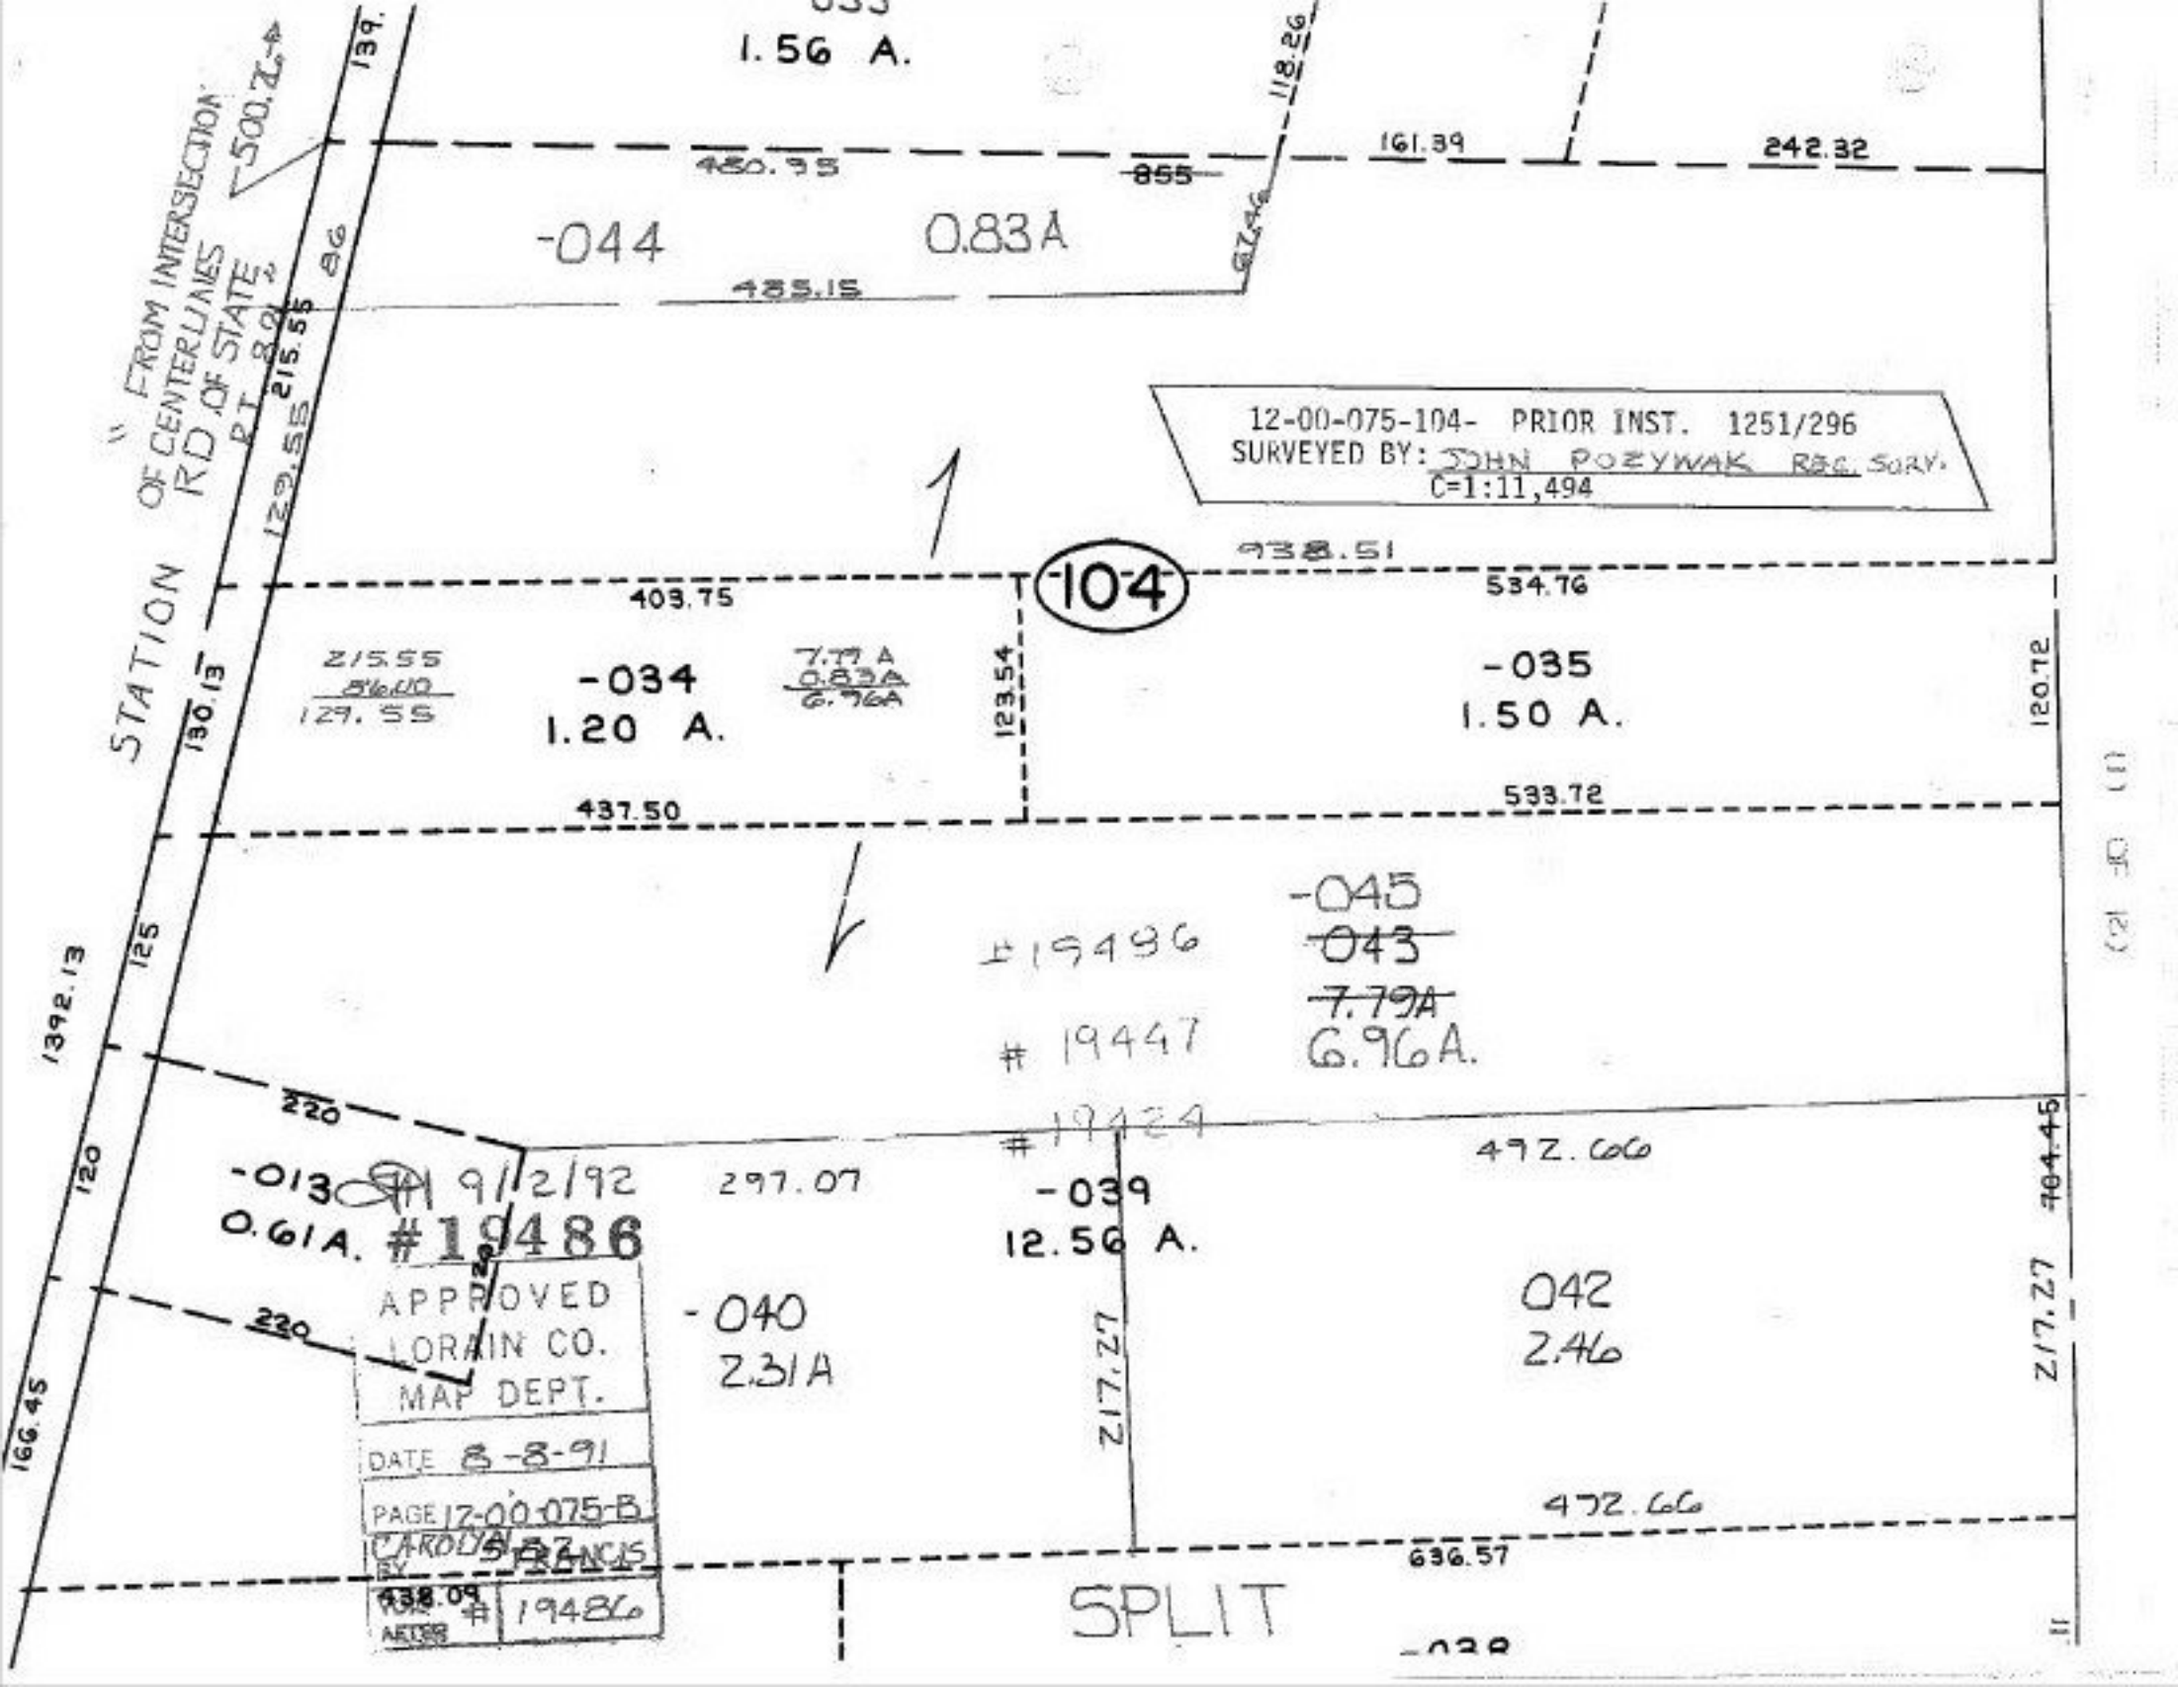

1.56 A.
-044
0.83A
480.95
855
161.39
242.32
485.15
118.26
67.46
12-00-075-104- PRIOR INST. 1251/296
SURVEYED BY: JOHN POZYWAK REG. SURV.
C=1:11,494
938.51
104
403.75
534.76
215.55
86.00
129.55
-034
1.20 A.
7.79 A
0.83A
6.96A
123.54
-035
1.50 A.
120.72
437.50
533.72
-045
~~043~~
~~7.79A~~
6.96A.
#19486
#19447
#19424
220
-013
0.61A.
9/2/92
#19486
297.07
-039
12.56 A.
492.66
704.45
-040
2.31A
042
2.46
217.27
472.66
636.57
438.09
SPLIT
STATION
" FROM INTERSECTION OF CENTERLINES RD. OF STATE RT. 801 "
500.26
139.
86
215.55
129.55
130.13
125
1392.13
120
166.45
APPROVED
LORAIN CO.
MAP DEPT.
DATE 8-8-91
PAGE 12-00-075-B
CAROLYN S. FRANCIS
BY
VOL. # 19486
ACTES