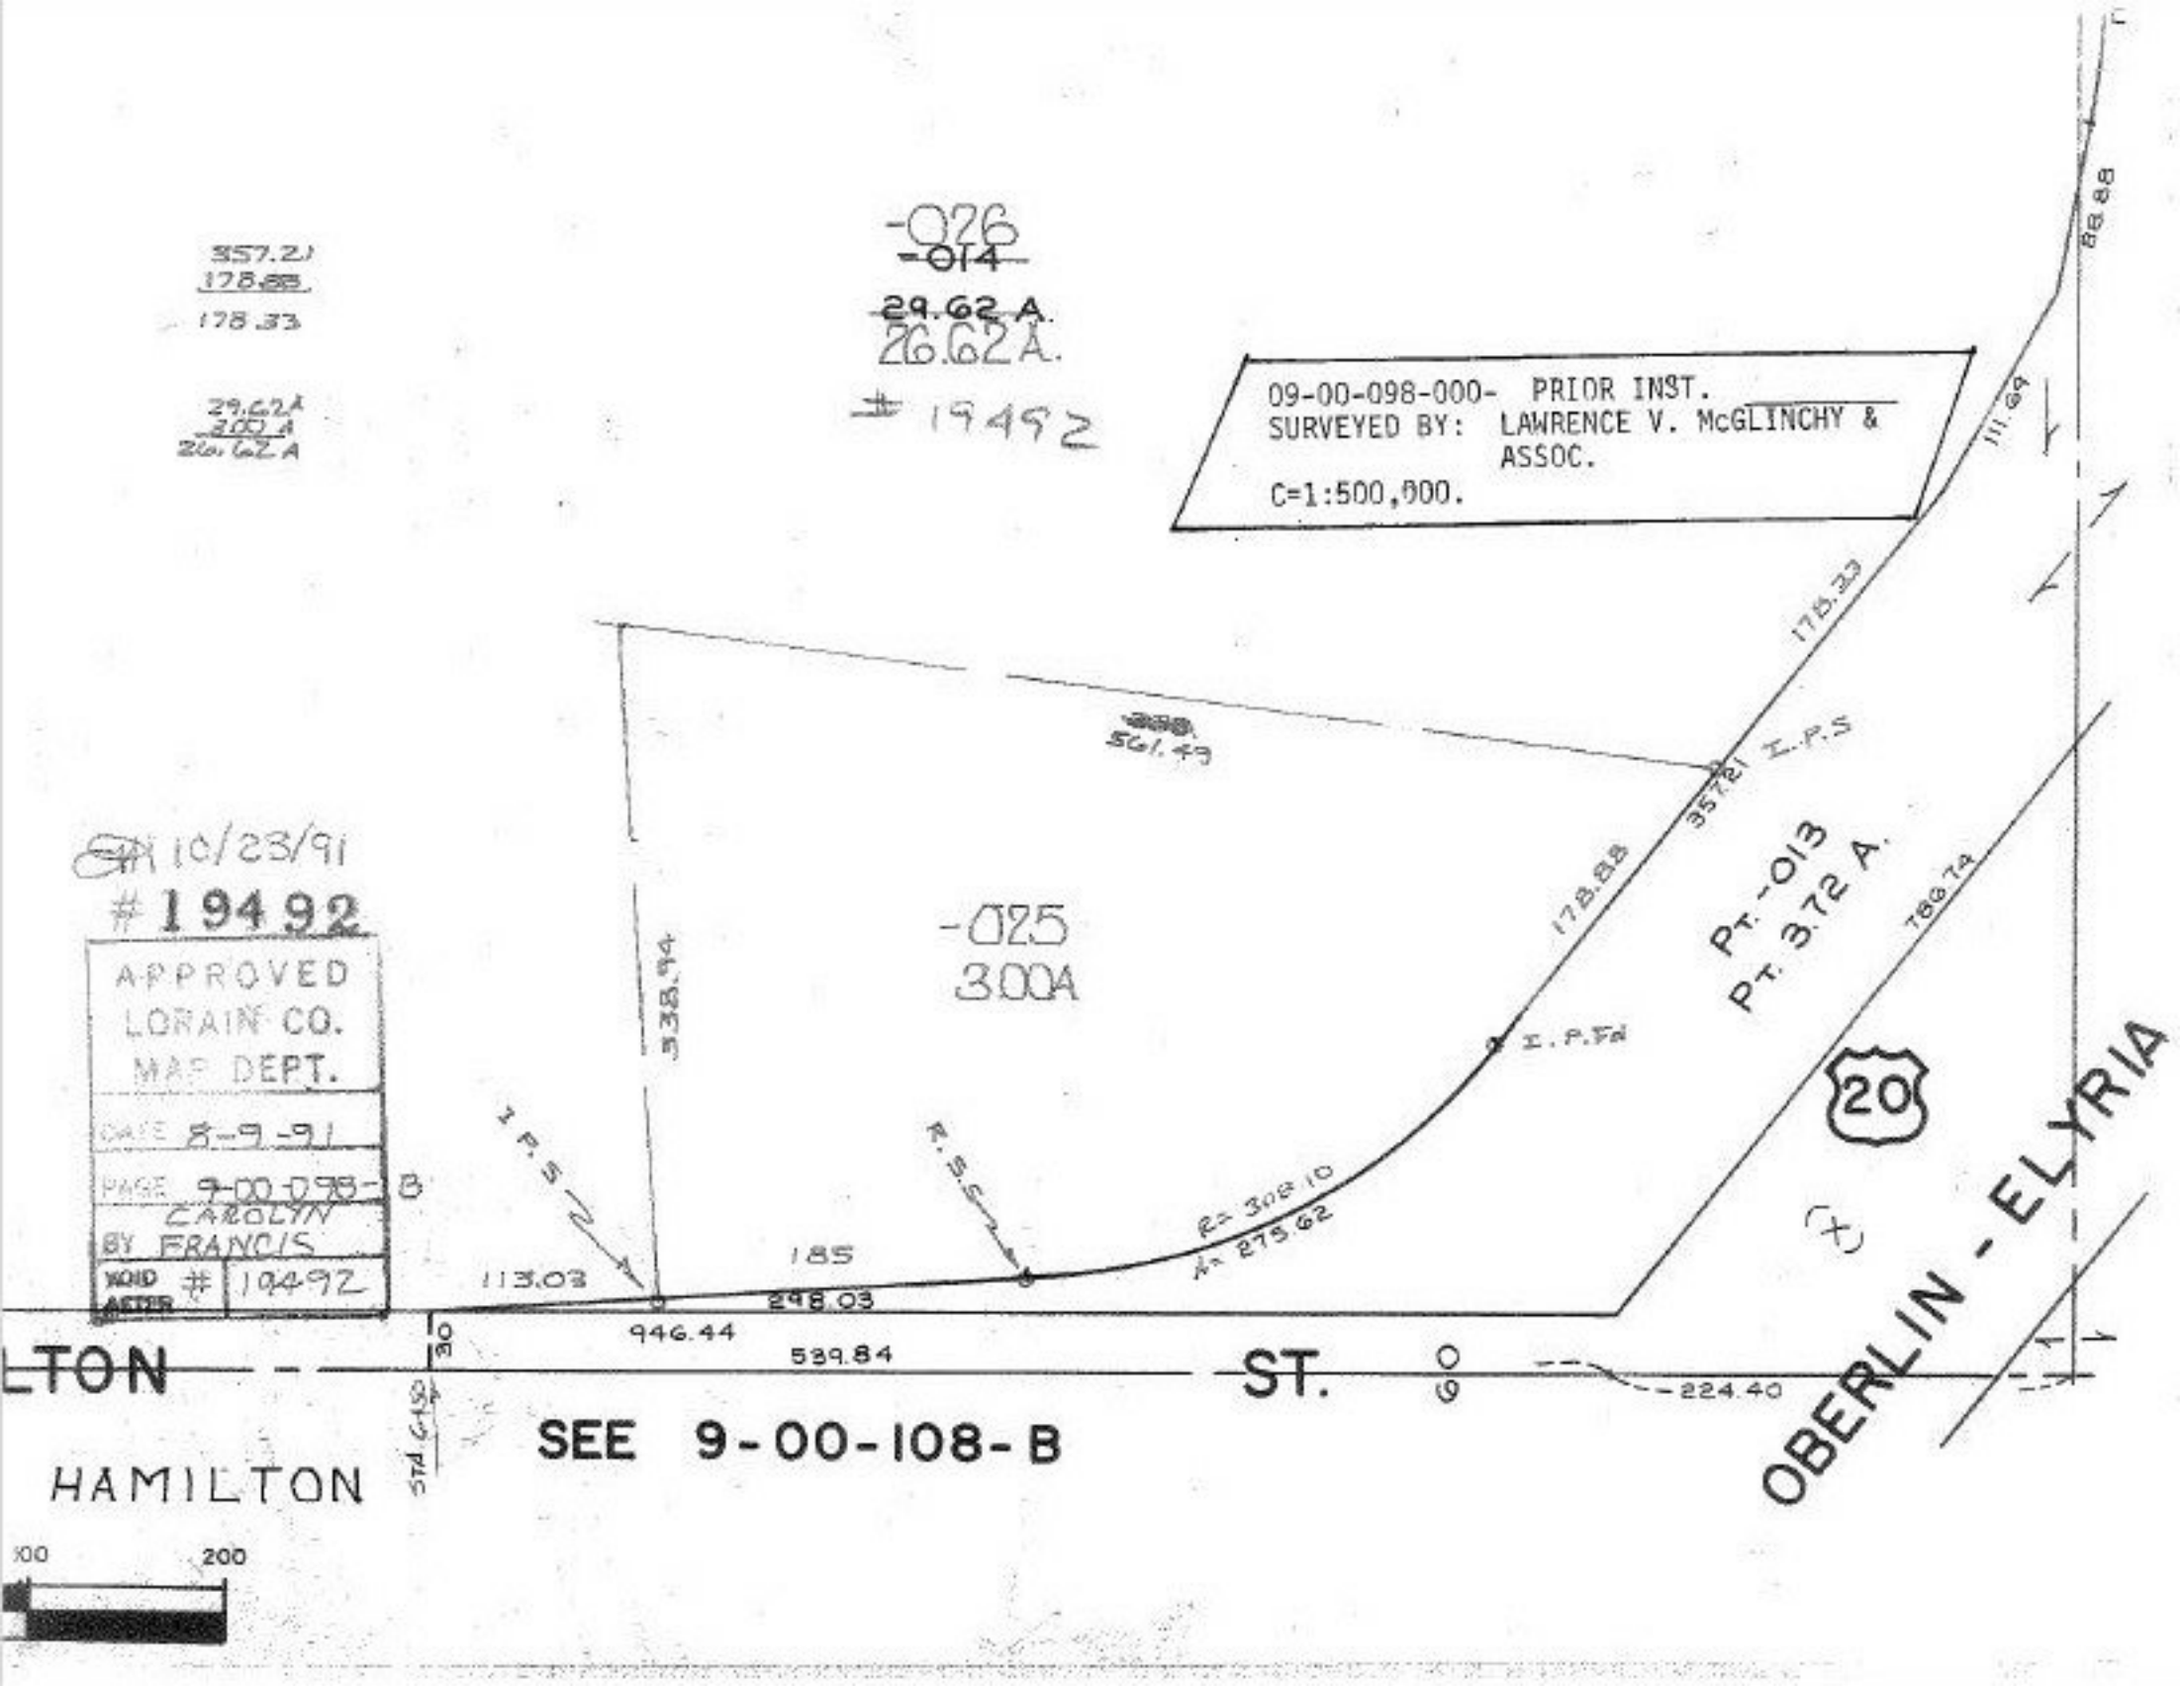

09-00-098-000- PRIOR INST.
SURVEYED BY: LAWRENCE V. McGLINCHY & ASSOC.
C=1:500,000.
-026
-014
29.62 A.
26.62 A.
19492
357.21
178.88
178.33
29.62 A
3.00 A
26.62 A
-025
3.00A
561.49
338.94
I.P.S
I.P.Fd
R.S.S
R= 308.10
A= 275.62
185
298.03
113.03
946.44
539.84
224.40
Pt.-013
Pt. 3.72 A.
786.74
111.69
88.88
20
OBERLIN - ELYRIA
LTON
ST.
HAMILTON
SEE 9-00-108-B
10/23/91
19492
APPROVED
LORAIN CO.
MAP DEPT.
DATE 8-9-91
PAGE 9-00-098-B
BY CAROLYN FRANCIS
VOID AFTER # 19492
100
200