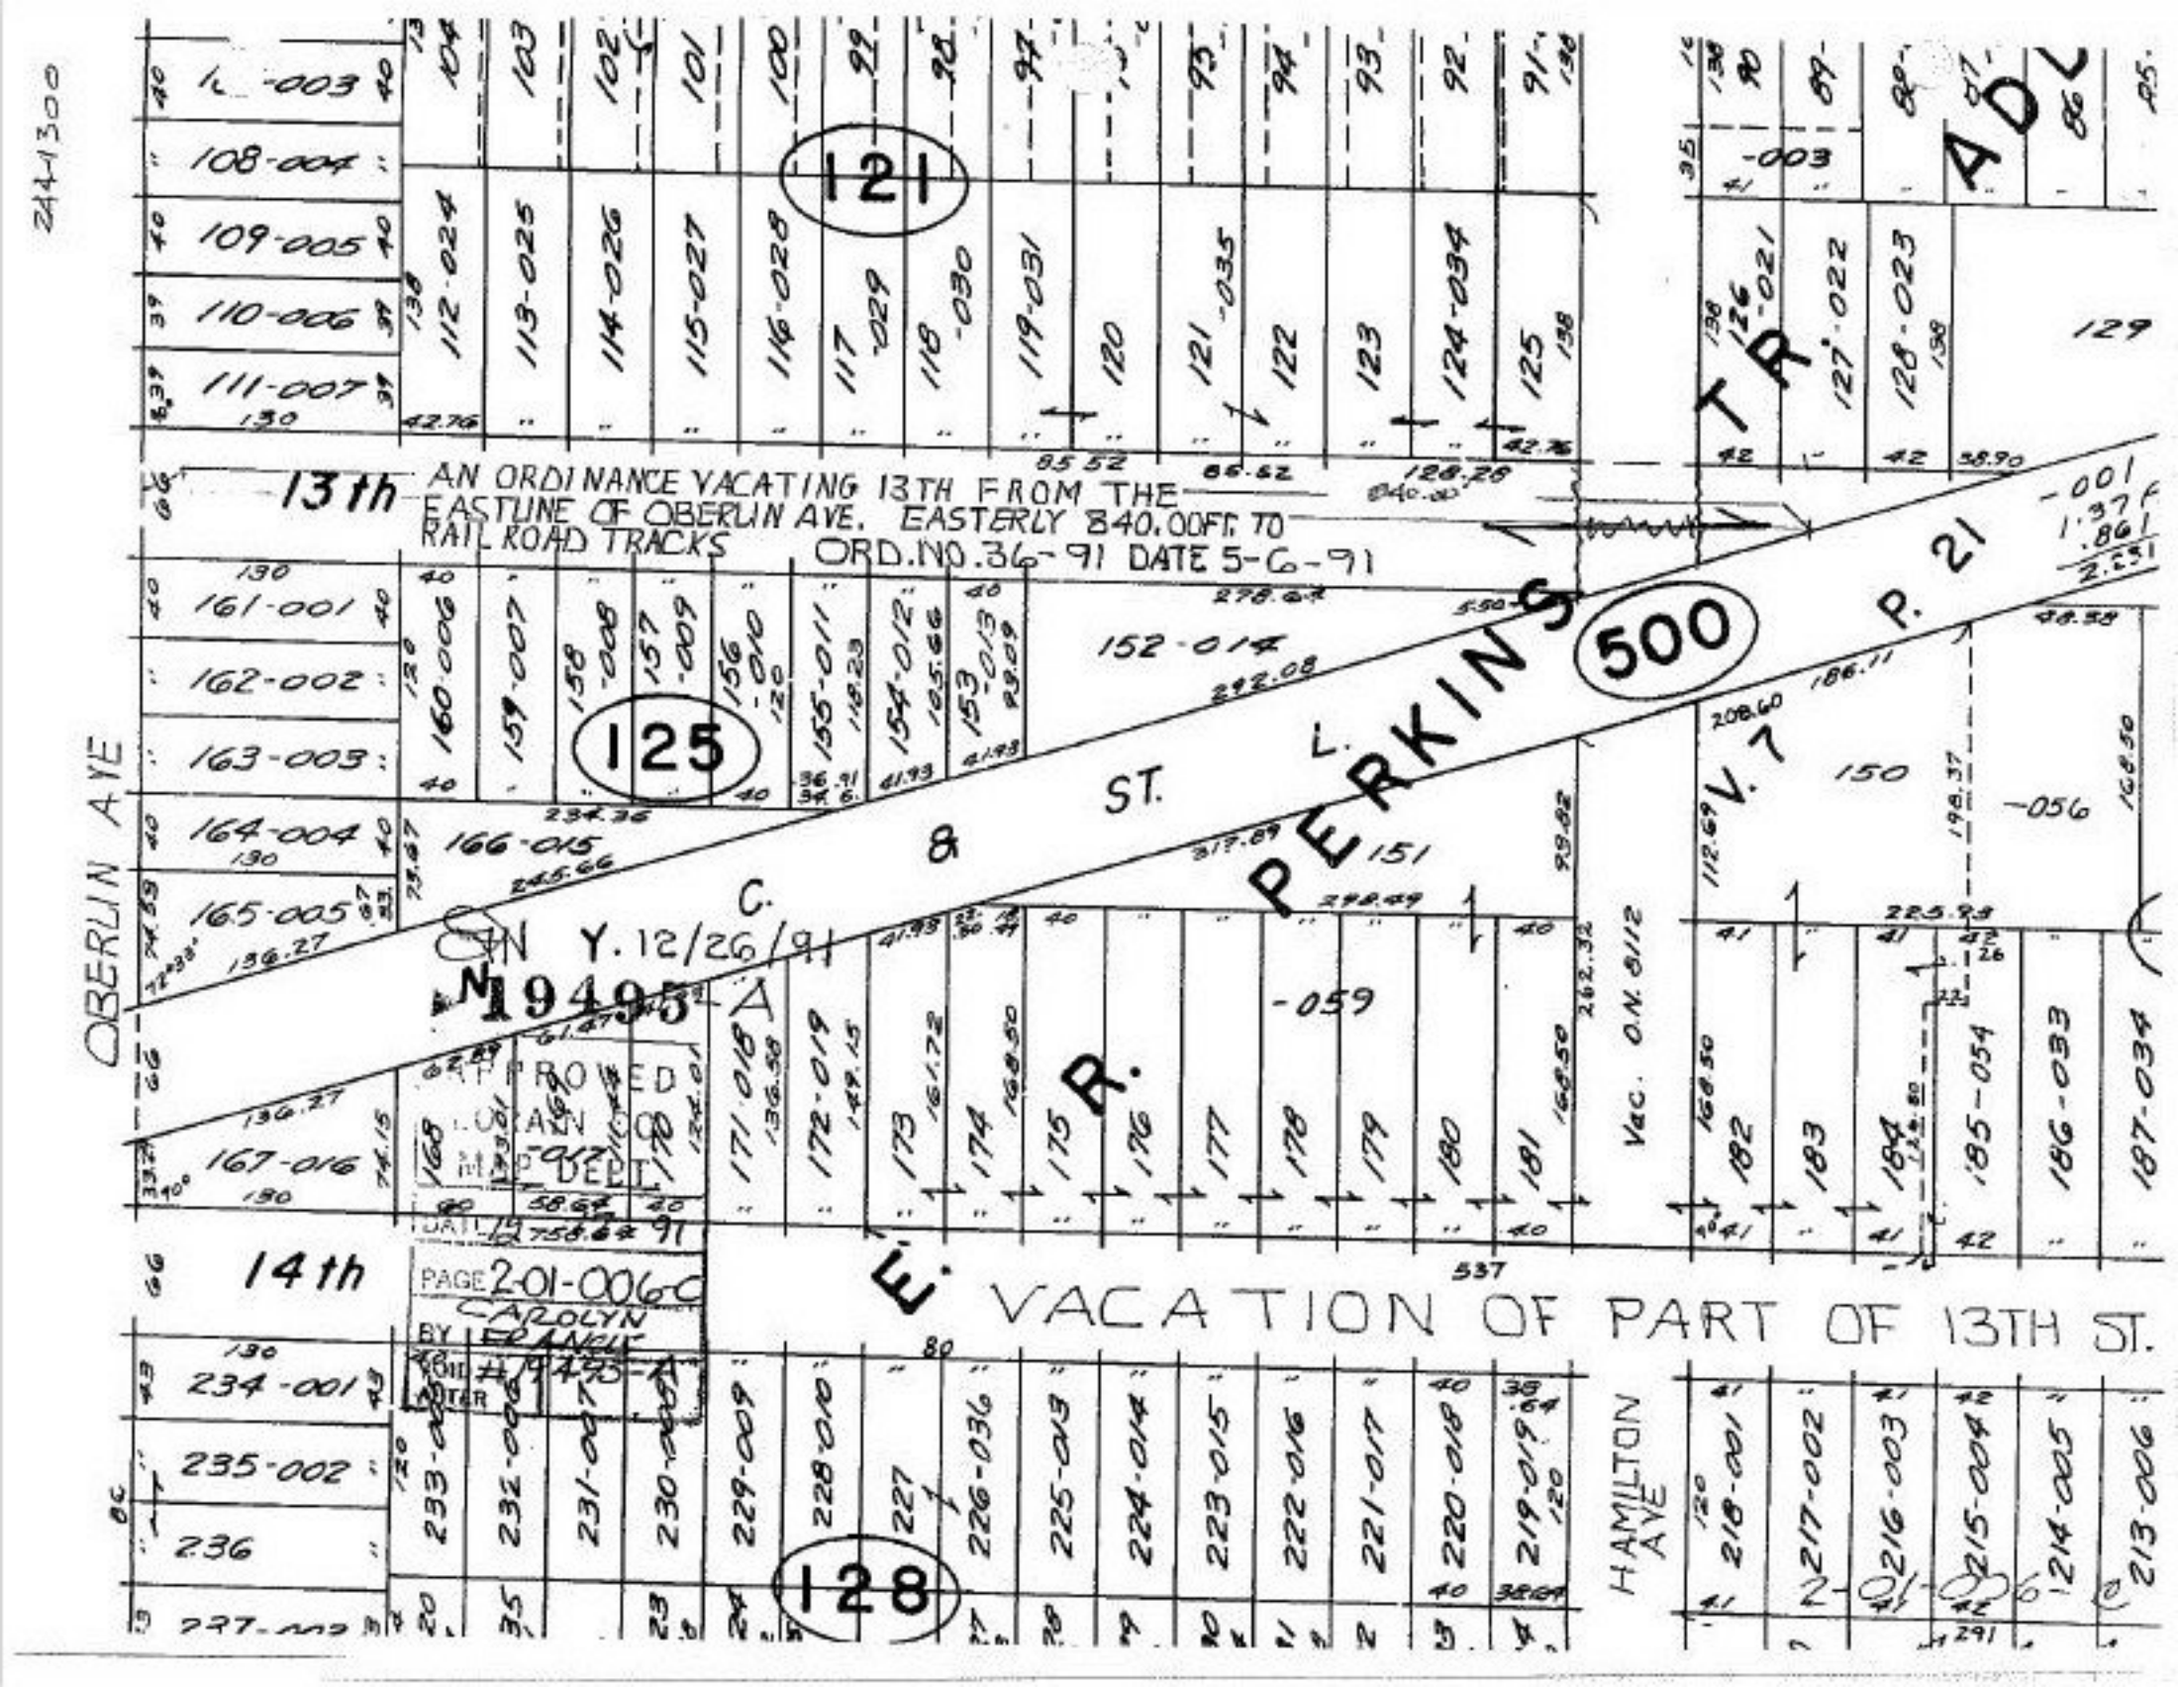
244300
13th
AN ORDINANCE VACATING 13TH FROM THE EASTLINE OF OBERLIN AVE. EASTERLY 840.00FT. TO RAIL ROAD TRACKS ORD.NO.36-91 DATE 5-6-91
14th
OBERLIN AVE
C. & E. R. R. ST.
PERKINS
500
P. 21
V. 7
L.
CAN Y. 12/26/91
N 19495 A
DATE 12-26-91
PAGE 2-01-006C
BY CAROLYN FRANCIS
VACATION OF PART OF 13TH ST.
Vac. ON 6112
HAMILTON AVE
125
126
127
128
129
150
151
152-014
-059
-056
161-001
162-002
163-003
164-004
165-005
166-015
167-016
234-001
235-002
236
237-003
160-006
159-007
158-008
157-009
156-010
155-011
154-012
153-013
171-018
172-019
173
174
175
176
177
178
179
180
181
182
183
184
185-054
186-033
187-034
233-005
232-006
231-007
230-008
229-009
228-010
227
226-036
225-013
224-014
223-015
222-016
221-017
220-018
219-019
218-001
217-002
216-003
215-004
214-005
213-006
112-024
113-025
114-026
115-027
116-028
117-029
118-030
119-031
120
121-035
122
123
124-034
125
-001
-003
-021
-022
-023
