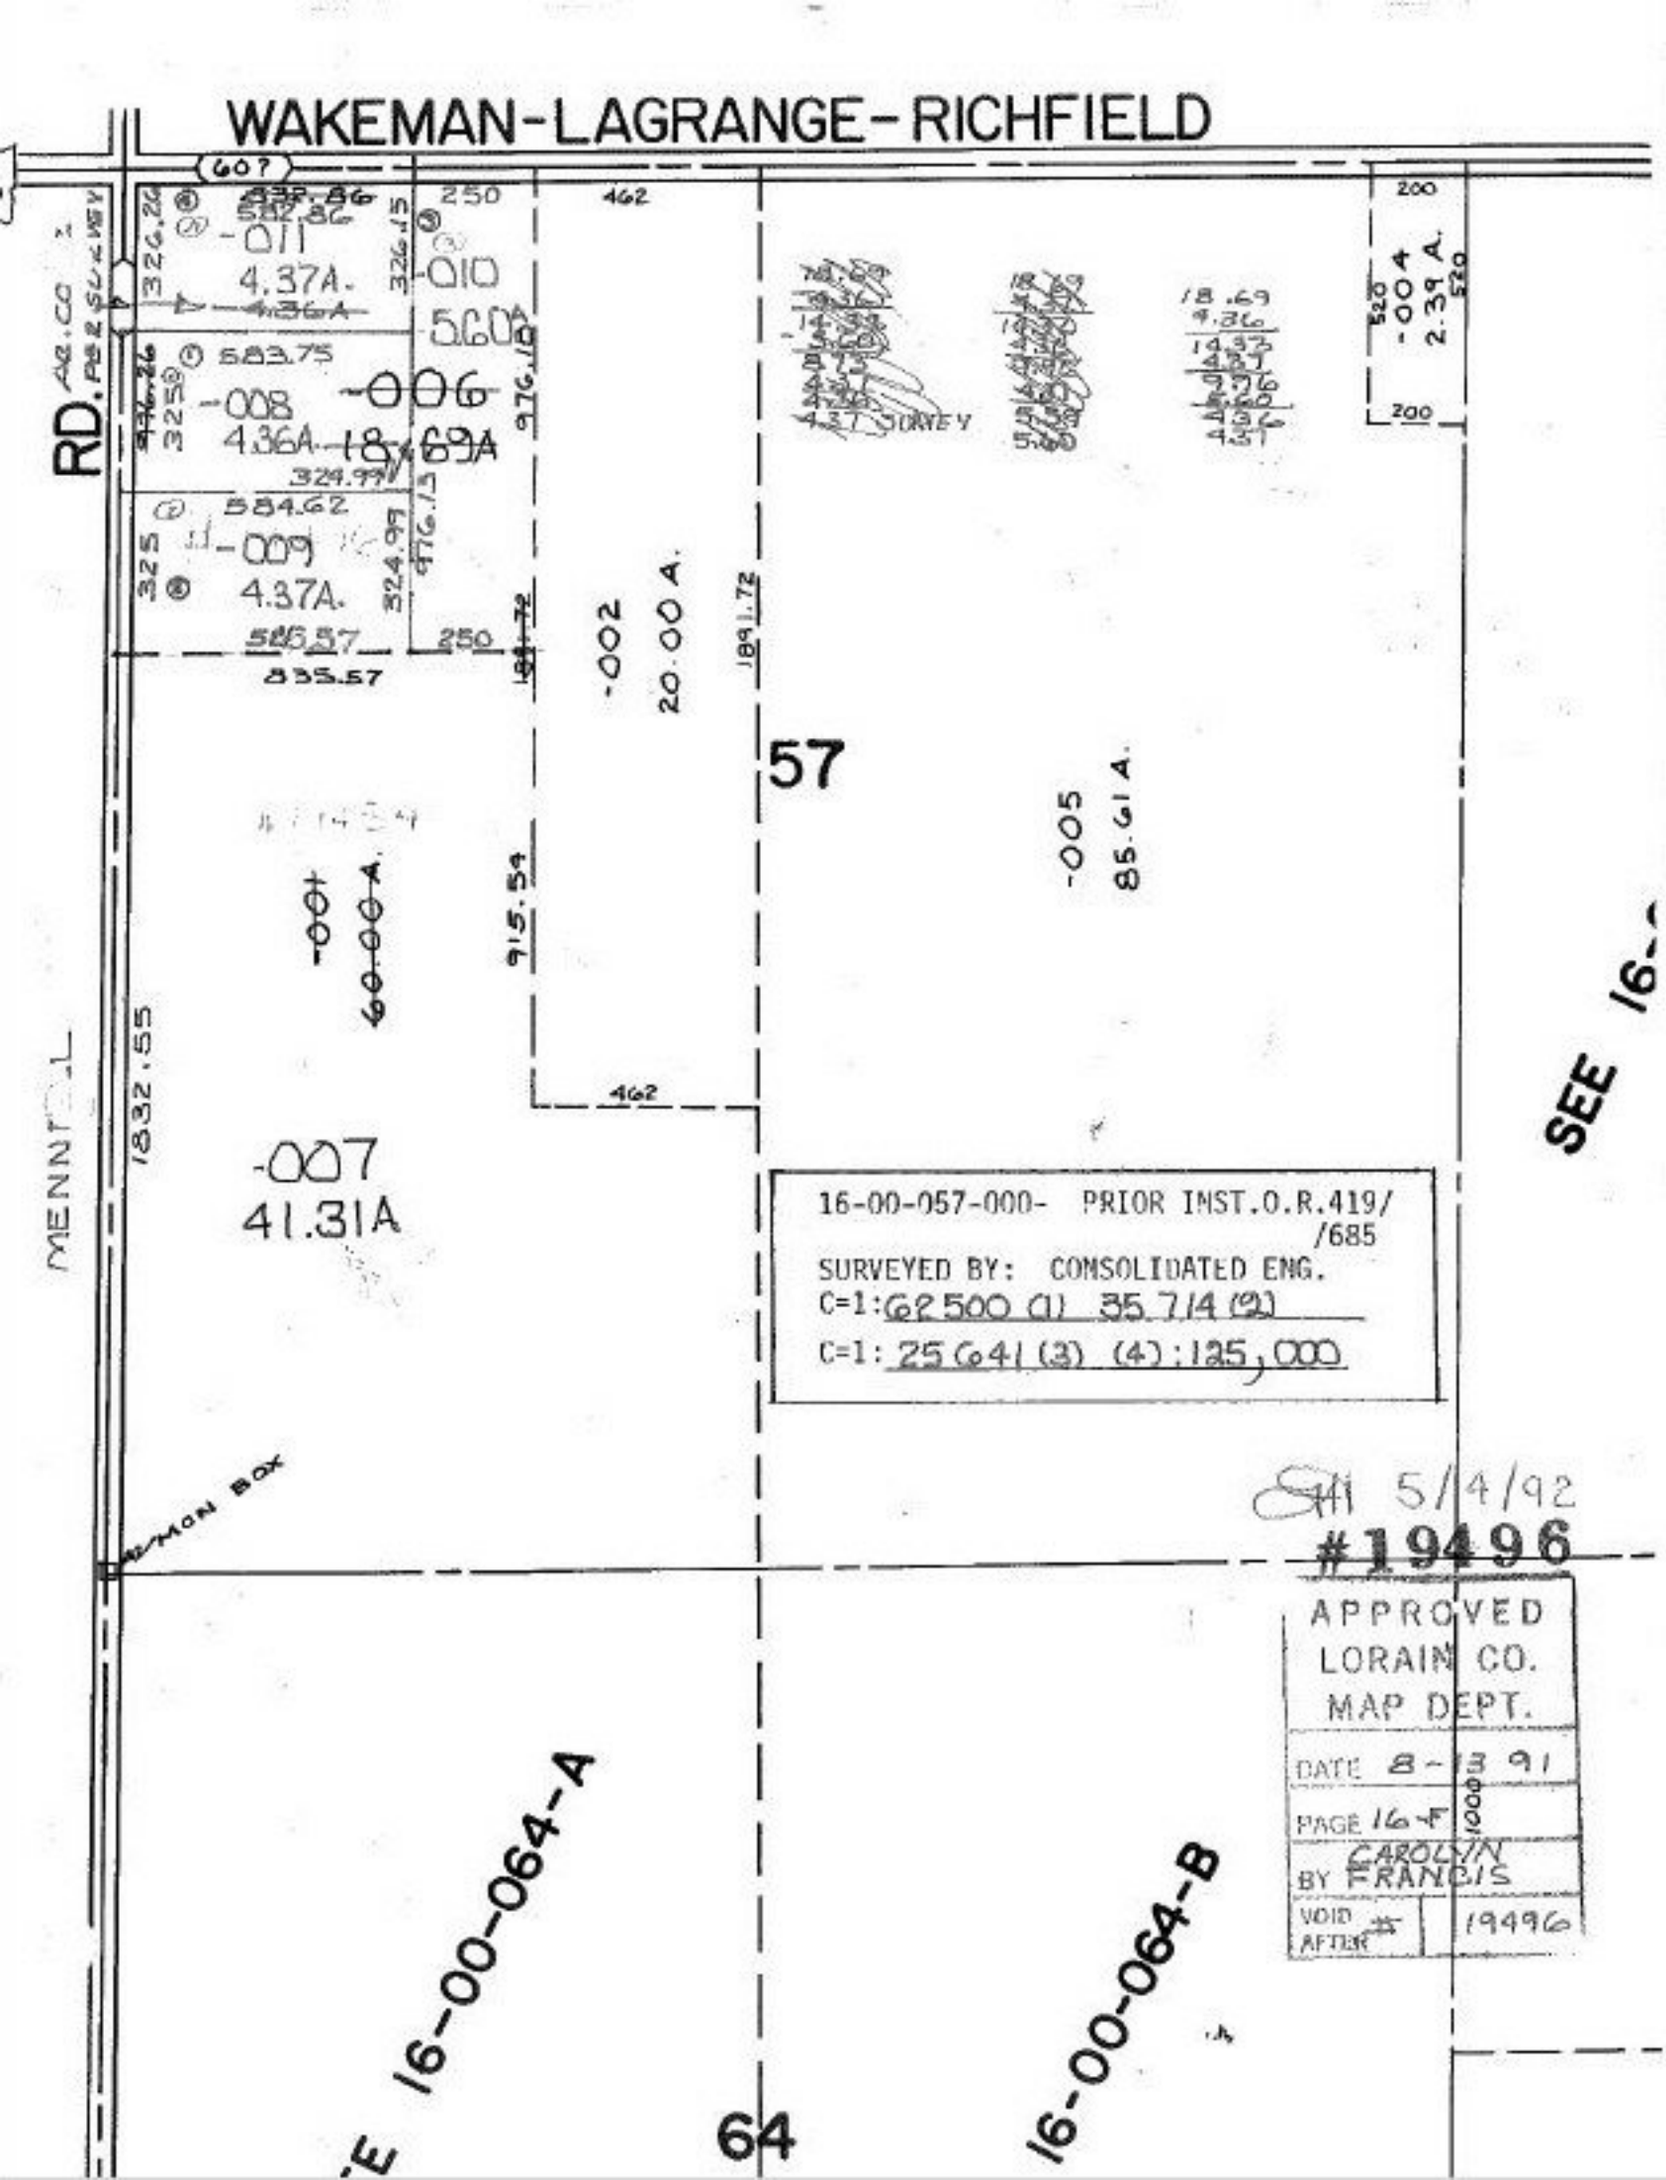
WAKEMAN-LAGRANGE-RICHFIELD
RD.
MENNTEL
-011
4.37A.
-010
5.60A
-008
4.36A
-006
18.69A
-009
4.37A.
-002
20.00 A.
57
-005
85.61 A.
-001
60.00 A.
-007
41.31A
SEE 16-
16-00-057-000- PRIOR INST.O.R.419/
/685
SURVEYED BY: CONSOLIDATED ENG.
C=1: 62500 (1) 35714 (2)
C=1: 25641 (3) (4): 125,000
5/4/92
#19496
APPROVED
LORAIN CO.
MAP DEPT.
DATE 8-13 91
PAGE 16-F
BY CAROLYN FRANCIS
VOID AFTER # 19496
16-00-064-A
16-00-064-B
64