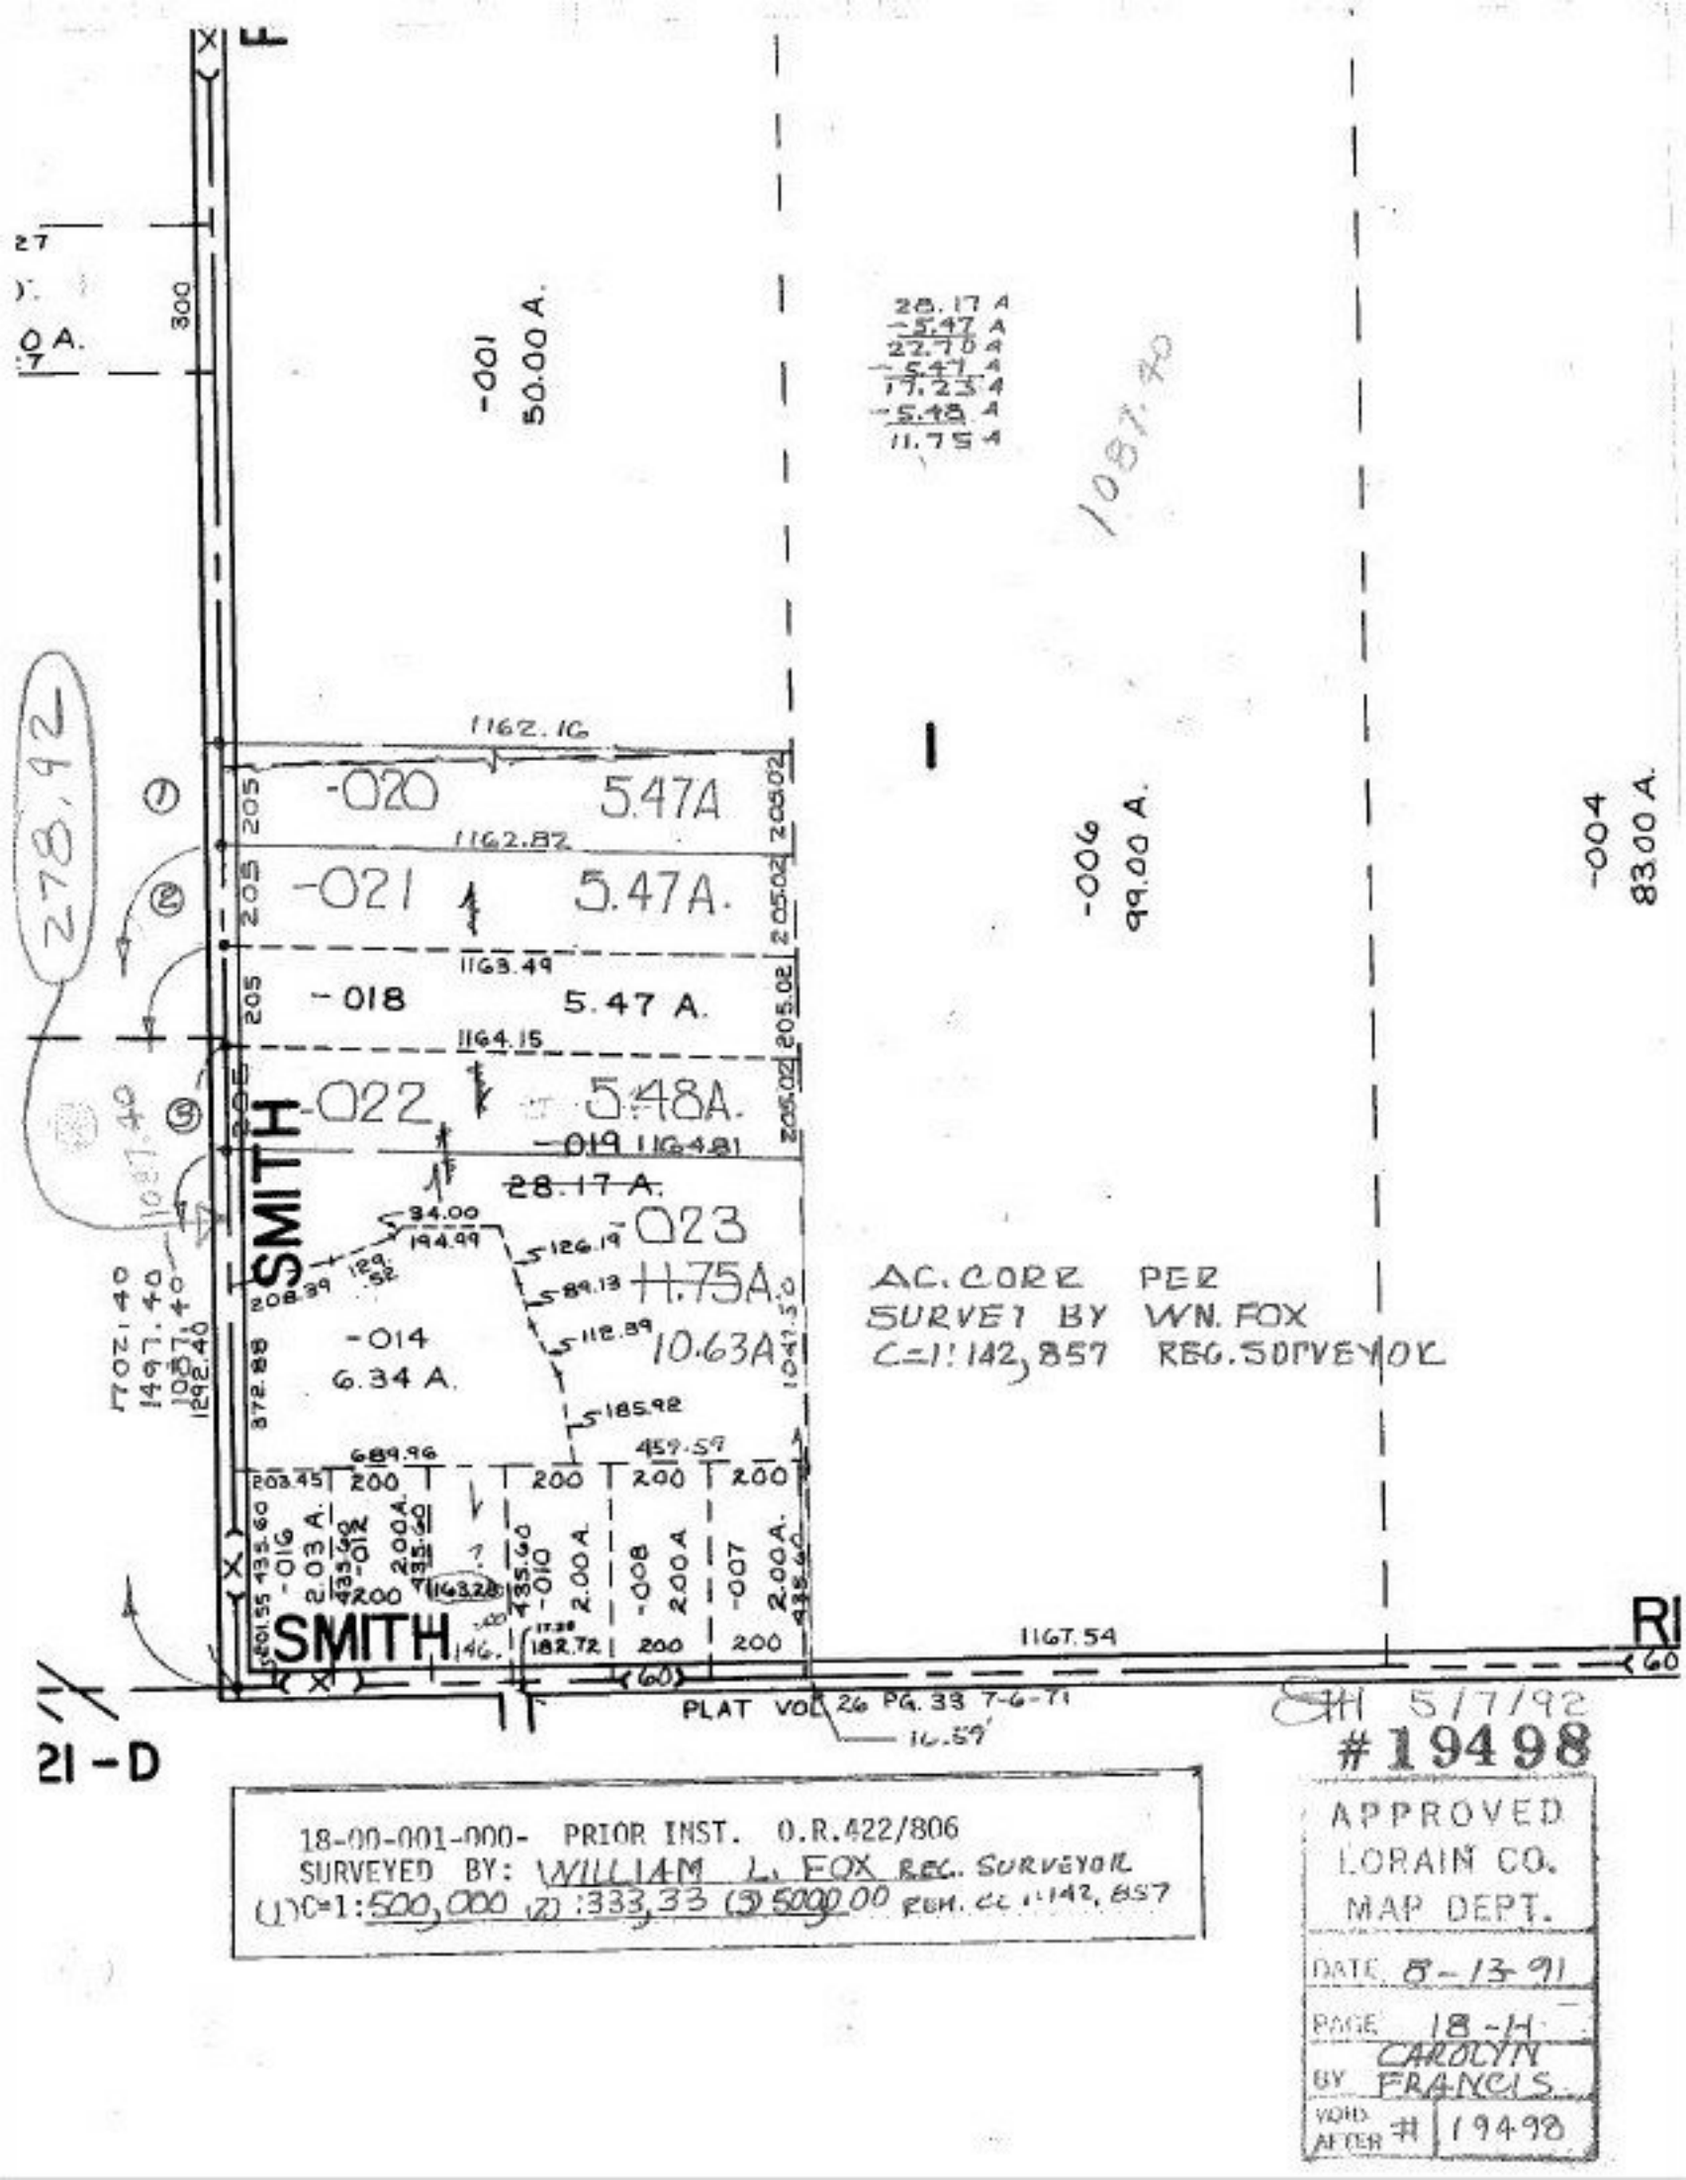

18-00-001-000- PRIOR INST. O.R.422/806
SURVEYED BY: WILLIAM L. FOX REG. SURVEYOR
(1) C=1:500,000 (2) :333.33 (3) 5000.00 REM. CL 1:142,857

AC. CORR PER SURVEY BY WM. FOX C=1:142,857 REG. SURVEYOR

SH 5/7/92

#19498

APPROVED
LORAIN CO.
MAP DEPT.
DATE 8-13-91
PAGE 18-14
BY CAROLYN FRANCIS
VOID AFTER #1 19498