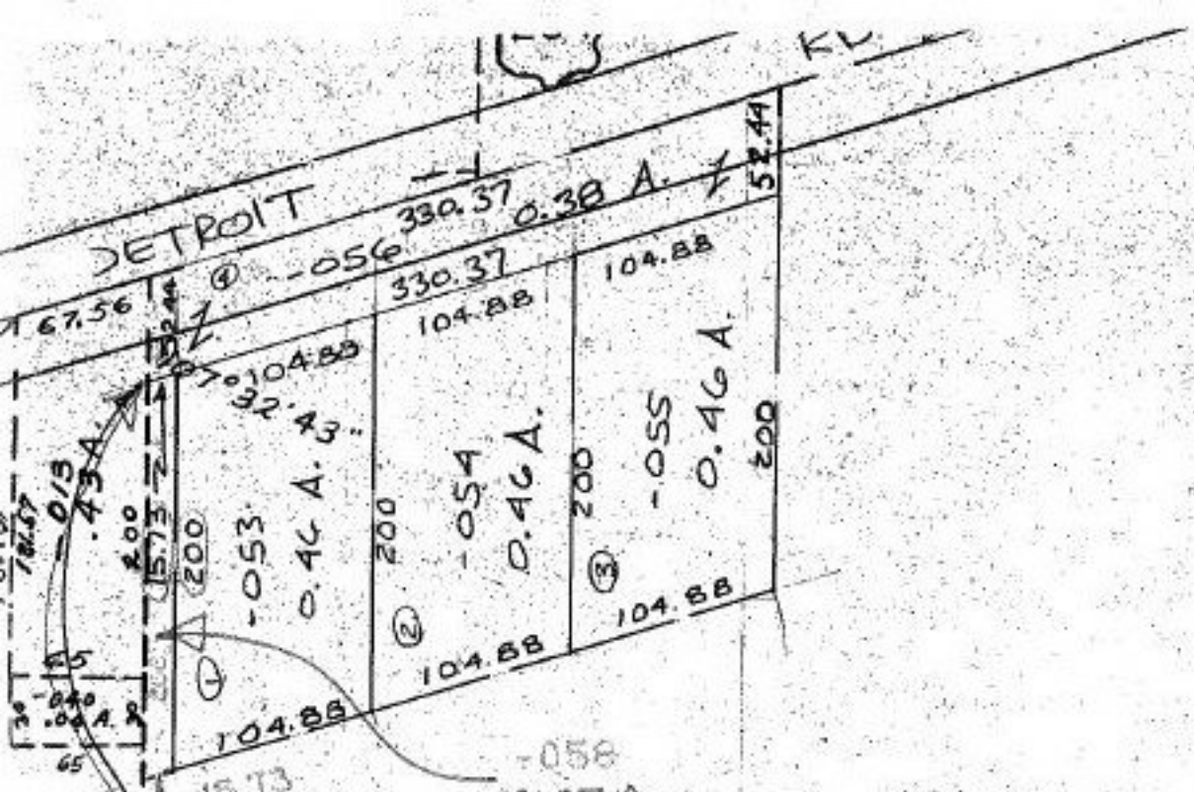

SEE SURVEY BY
VIRGIL D. LANDIS
SHAFFER, JOHNSTON, LICHTENWALTER & ASSOC., INC.
CC ON ALL 4 PARCELS 1:1NF

PRIOR INST. REF - OR 259/501

9/17/91
#19502

APPROVED
LORAIN CO.
MAP DEPT.
DATE 8/12/91
PAGE 4-00-027-F
BY T. HOLLIS
VOID AFTER 19502

~~-050~~
~~42.64 A.~~

~~-057~~
~~40.88 A.~~

-059
40.81 Ac.
#19481

-050
42.64 A.

102

1508.36
1209.37
1656.93