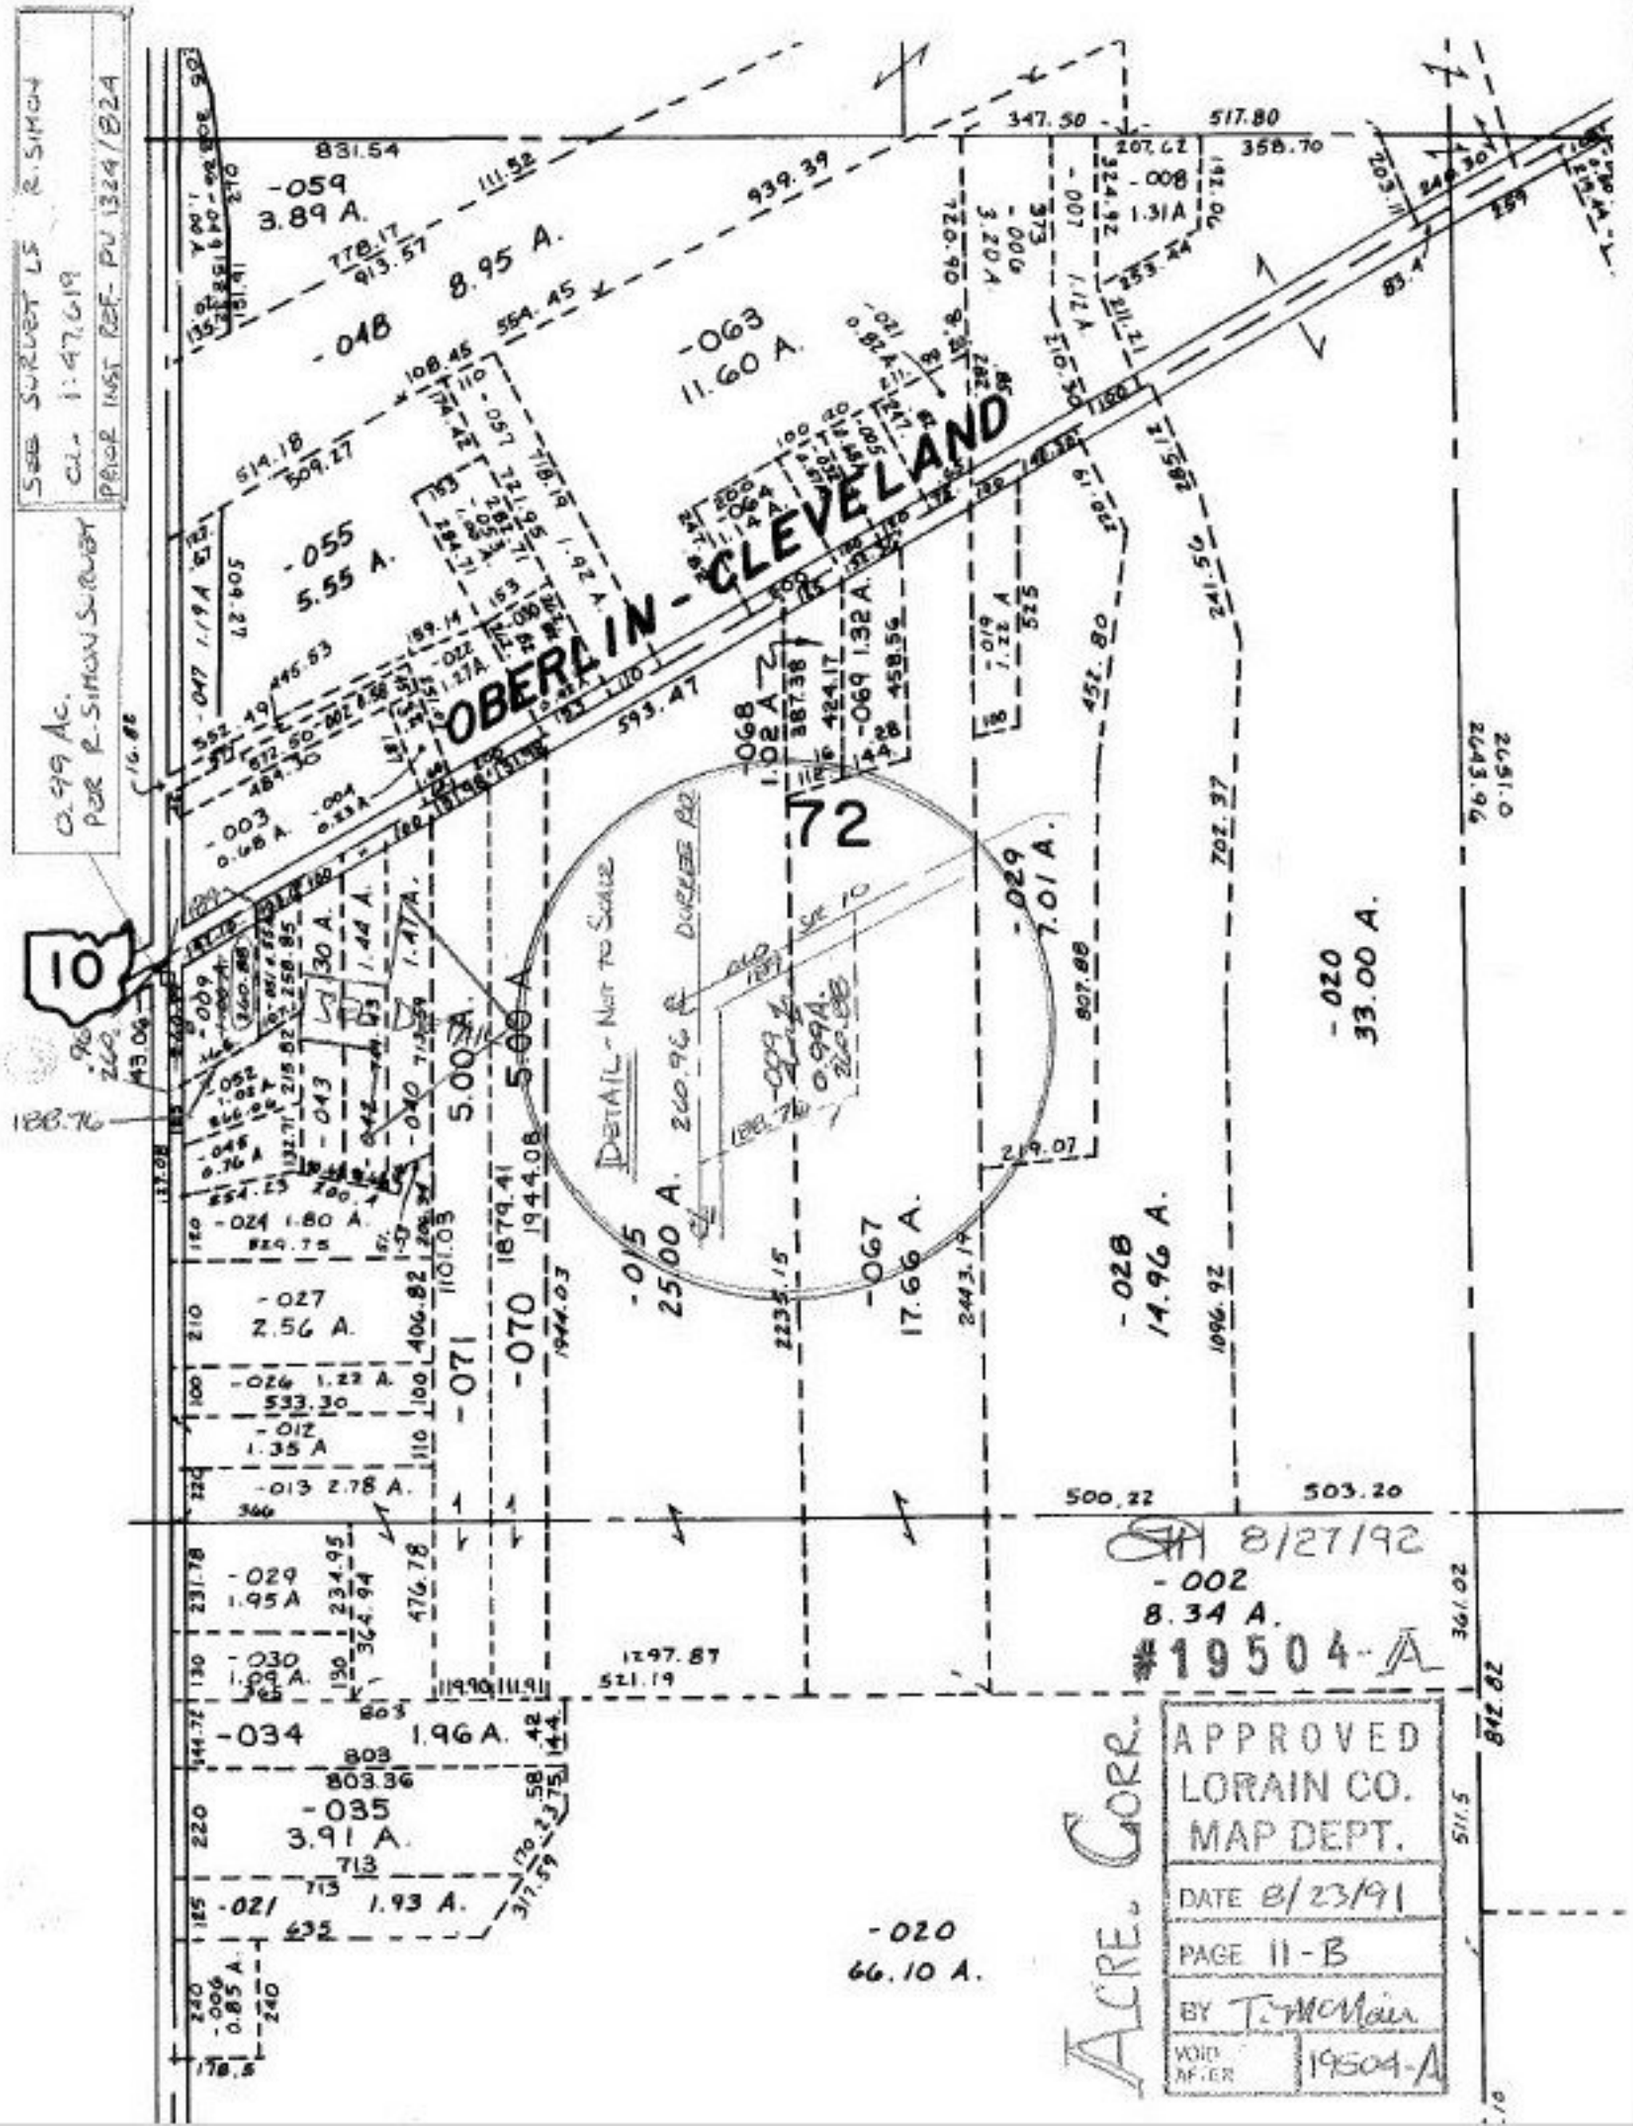

SEE SURVEY LS R. SIMON
CL. 1:47,619
PRIOR INST REF. PU 1324/824
0.99 Ac. PER R. SIMON SURVEY
10
OBERLIN - CLEVELAND
72
DETAIL - NOT TO SCALE
DURRER RD
-059 3.89 A.
-048 8.95 A.
-063 11.60 A.
-055 5.55 A.
-068 1.02 A.
-069 1.32 A.
-029 7.01 A.
-020 33.00 A.
-028 14.96 A.
-015 25.00 A.
-067 17.66 A.
-071 5.00 A.
-070 5.00 A.
-027 2.56 A.
-029 1.95 A.
-030 1.09 A.
-034 1.96 A.
-035 3.91 A.
-021 1.93 A.
-020 66.10 A.
-002 8.34 A.
-008 1.31 A.
-007 1.12 A.
-006 3.20 A.
-019 1.22 A.
-024 1.80 A.
-026 1.22 A.
-012 1.35 A.
-013 2.78 A.
-006 0.85 A.
8/27/92
#19504-A
ACRE. CORR.
APPROVED
LORAIN CO.
MAP DEPT.
DATE 8/23/91
PAGE 11-B
BY T. McMain
VOID AFTER 19504-A