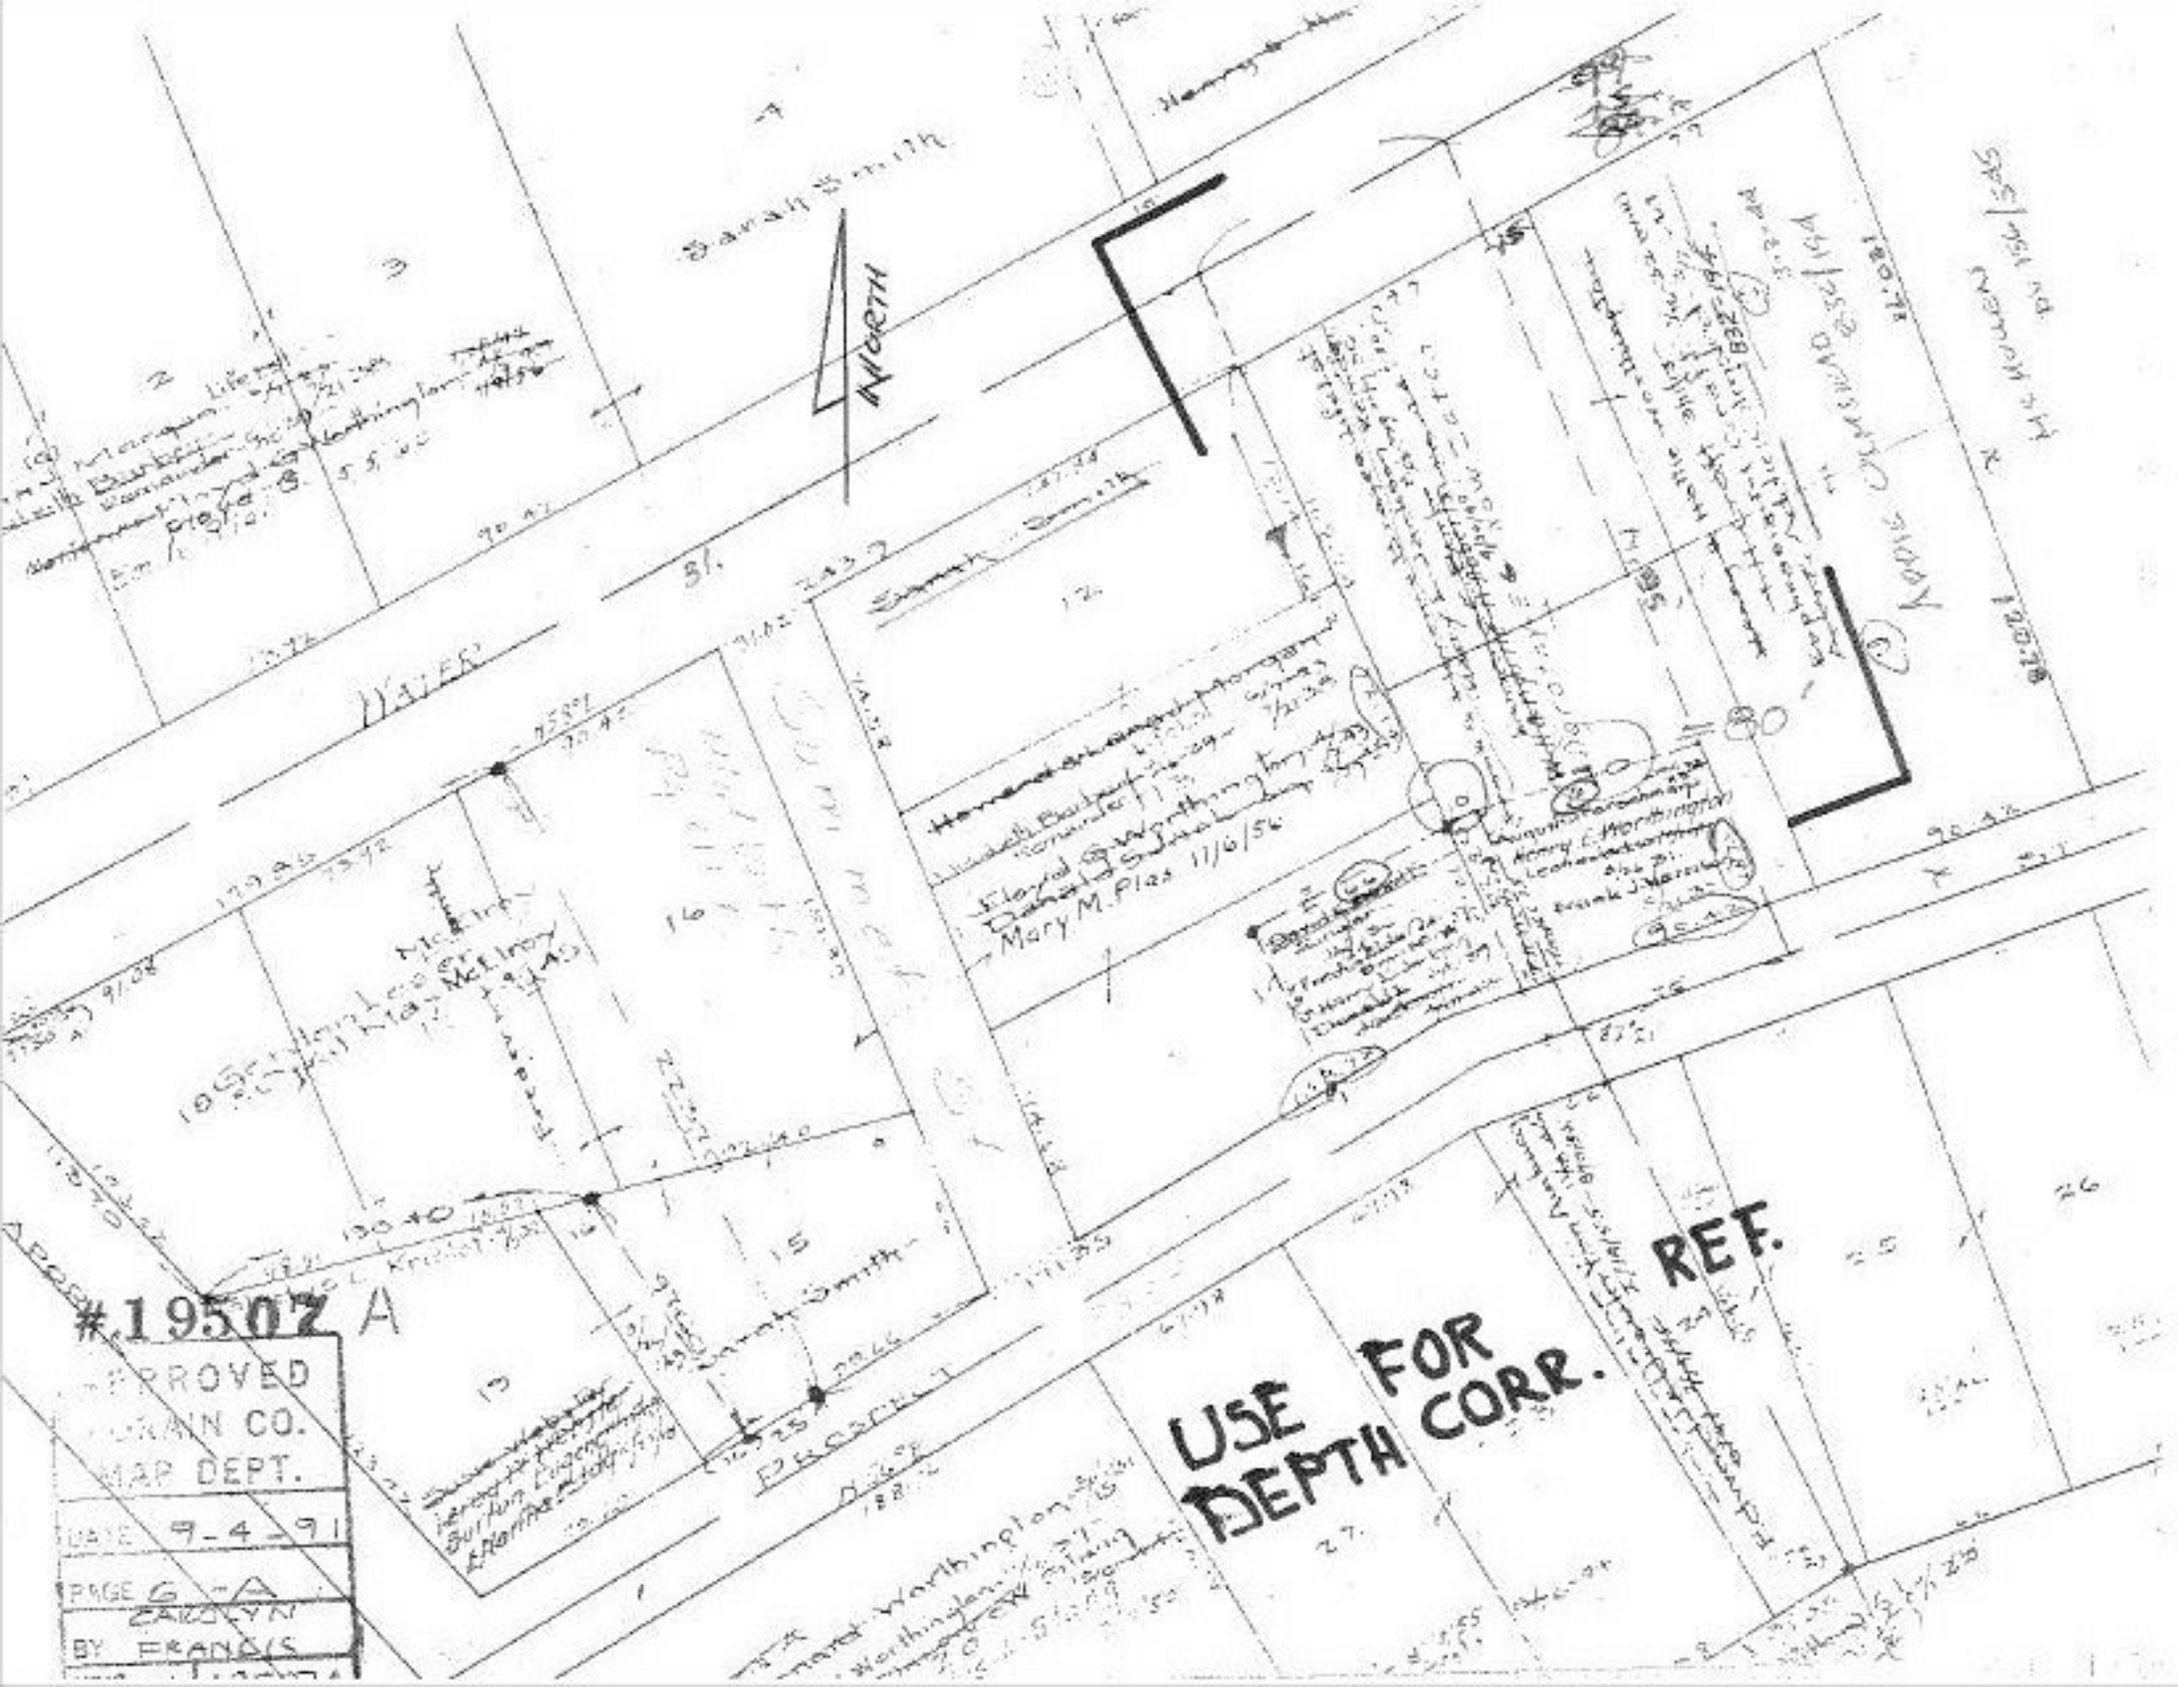

NORTH
WATER
Sarah Smith
Mary M. Plas 11/6/56
Henry E. Worthington
Frank J. Marsilio
McElroy
Sarah Smith
PROSPECT
USE FOR DEPTH CORR. REF.
#19507 A
APPROVED
MAP DEPT.
DATE 9-4-91
PAGE 6-A
BY FRANCIS