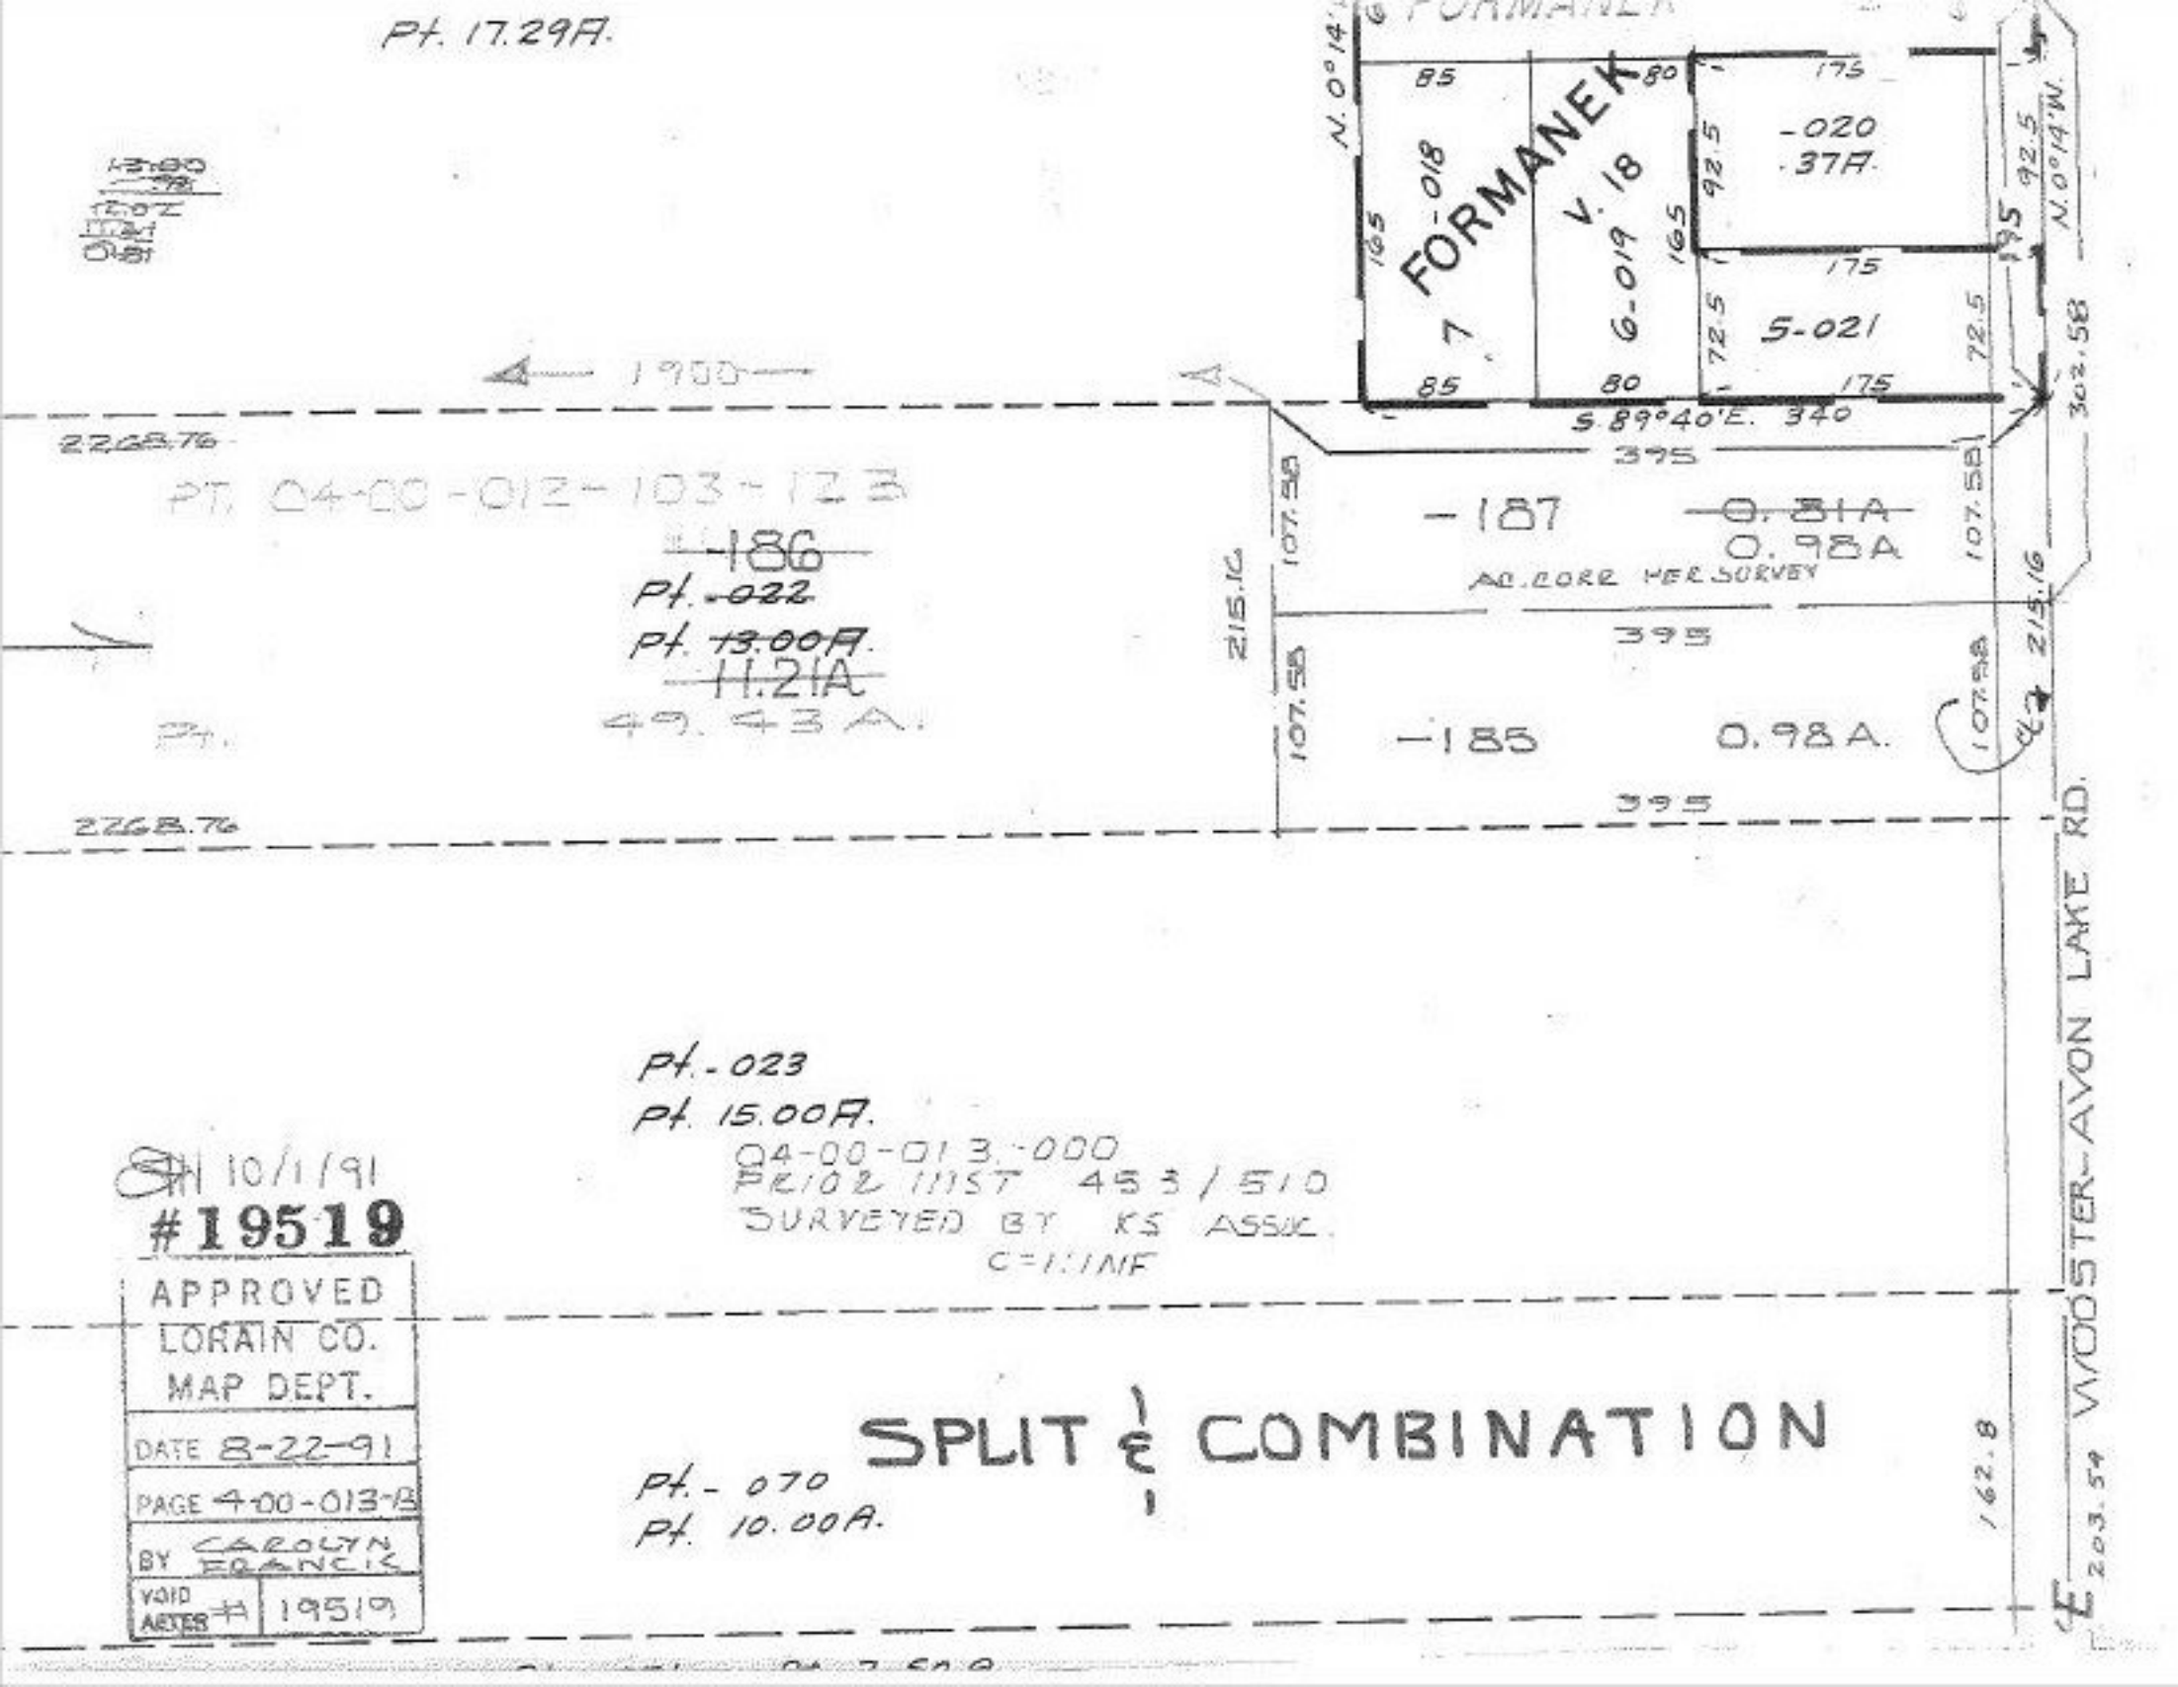
Pt. 17.29A.
N. 0°14'W.
FORMANEK
85
80
175
-020
.37A.
92.5
N. 0°14'W.
-018
7
V. 18
6-019
165
175
5-021
72.5
85
80
175
S. 89°40'E. 340
395
302.58
1950
2268.76
PT. 04-00-012-103-123
-186
Pt. -022
Pt. 13.00A.
11.21A
49.43A.
-187
0.81A
0.98A
AS CORE PER SURVEY
215.16
107.58
395
-185
0.98A.
2268.76
Pt. -023
Pt. 15.00A.
04-00-013.-000
PER02 1115T 453/510
SURVEYED BY KS ASSOC.
C=1.1NF
10/1/91
#19519
APPROVED
LORAIN CO.
MAP DEPT.
DATE 8-22-91
PAGE 4-00-013-B
BY CAROLYN FRANCIK
VOID AETES # 19519
SPLIT & COMBINATION
Pt. - 070
Pt. 10.00A.
162.8
203.59
WOOSTER-AVON LAKE RD.