


0-00-006-B

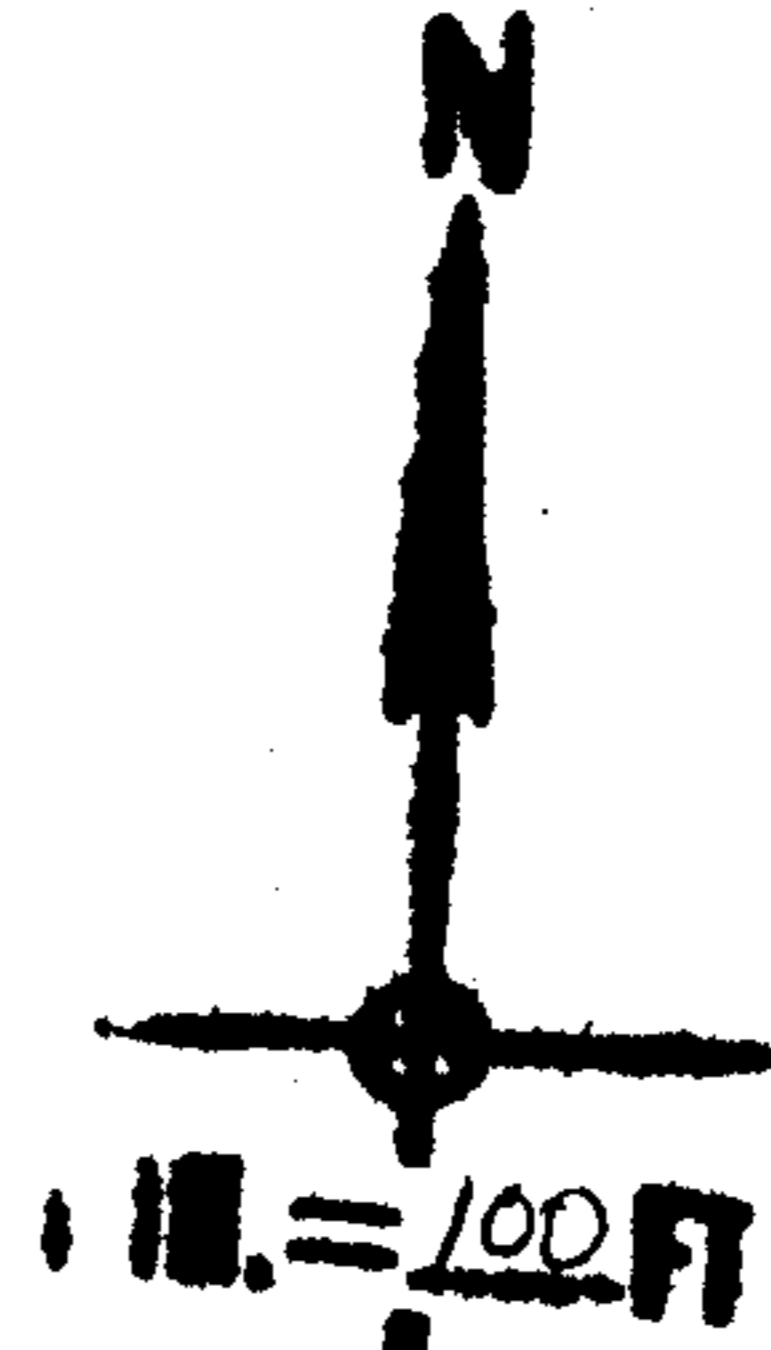

1952

APPROVED
LORAIN CO.
MAP DEPT.


DATE 7-19-68

10-00-006-F

BY *Robert*

9/28/68 R.K.

10-00-006-F

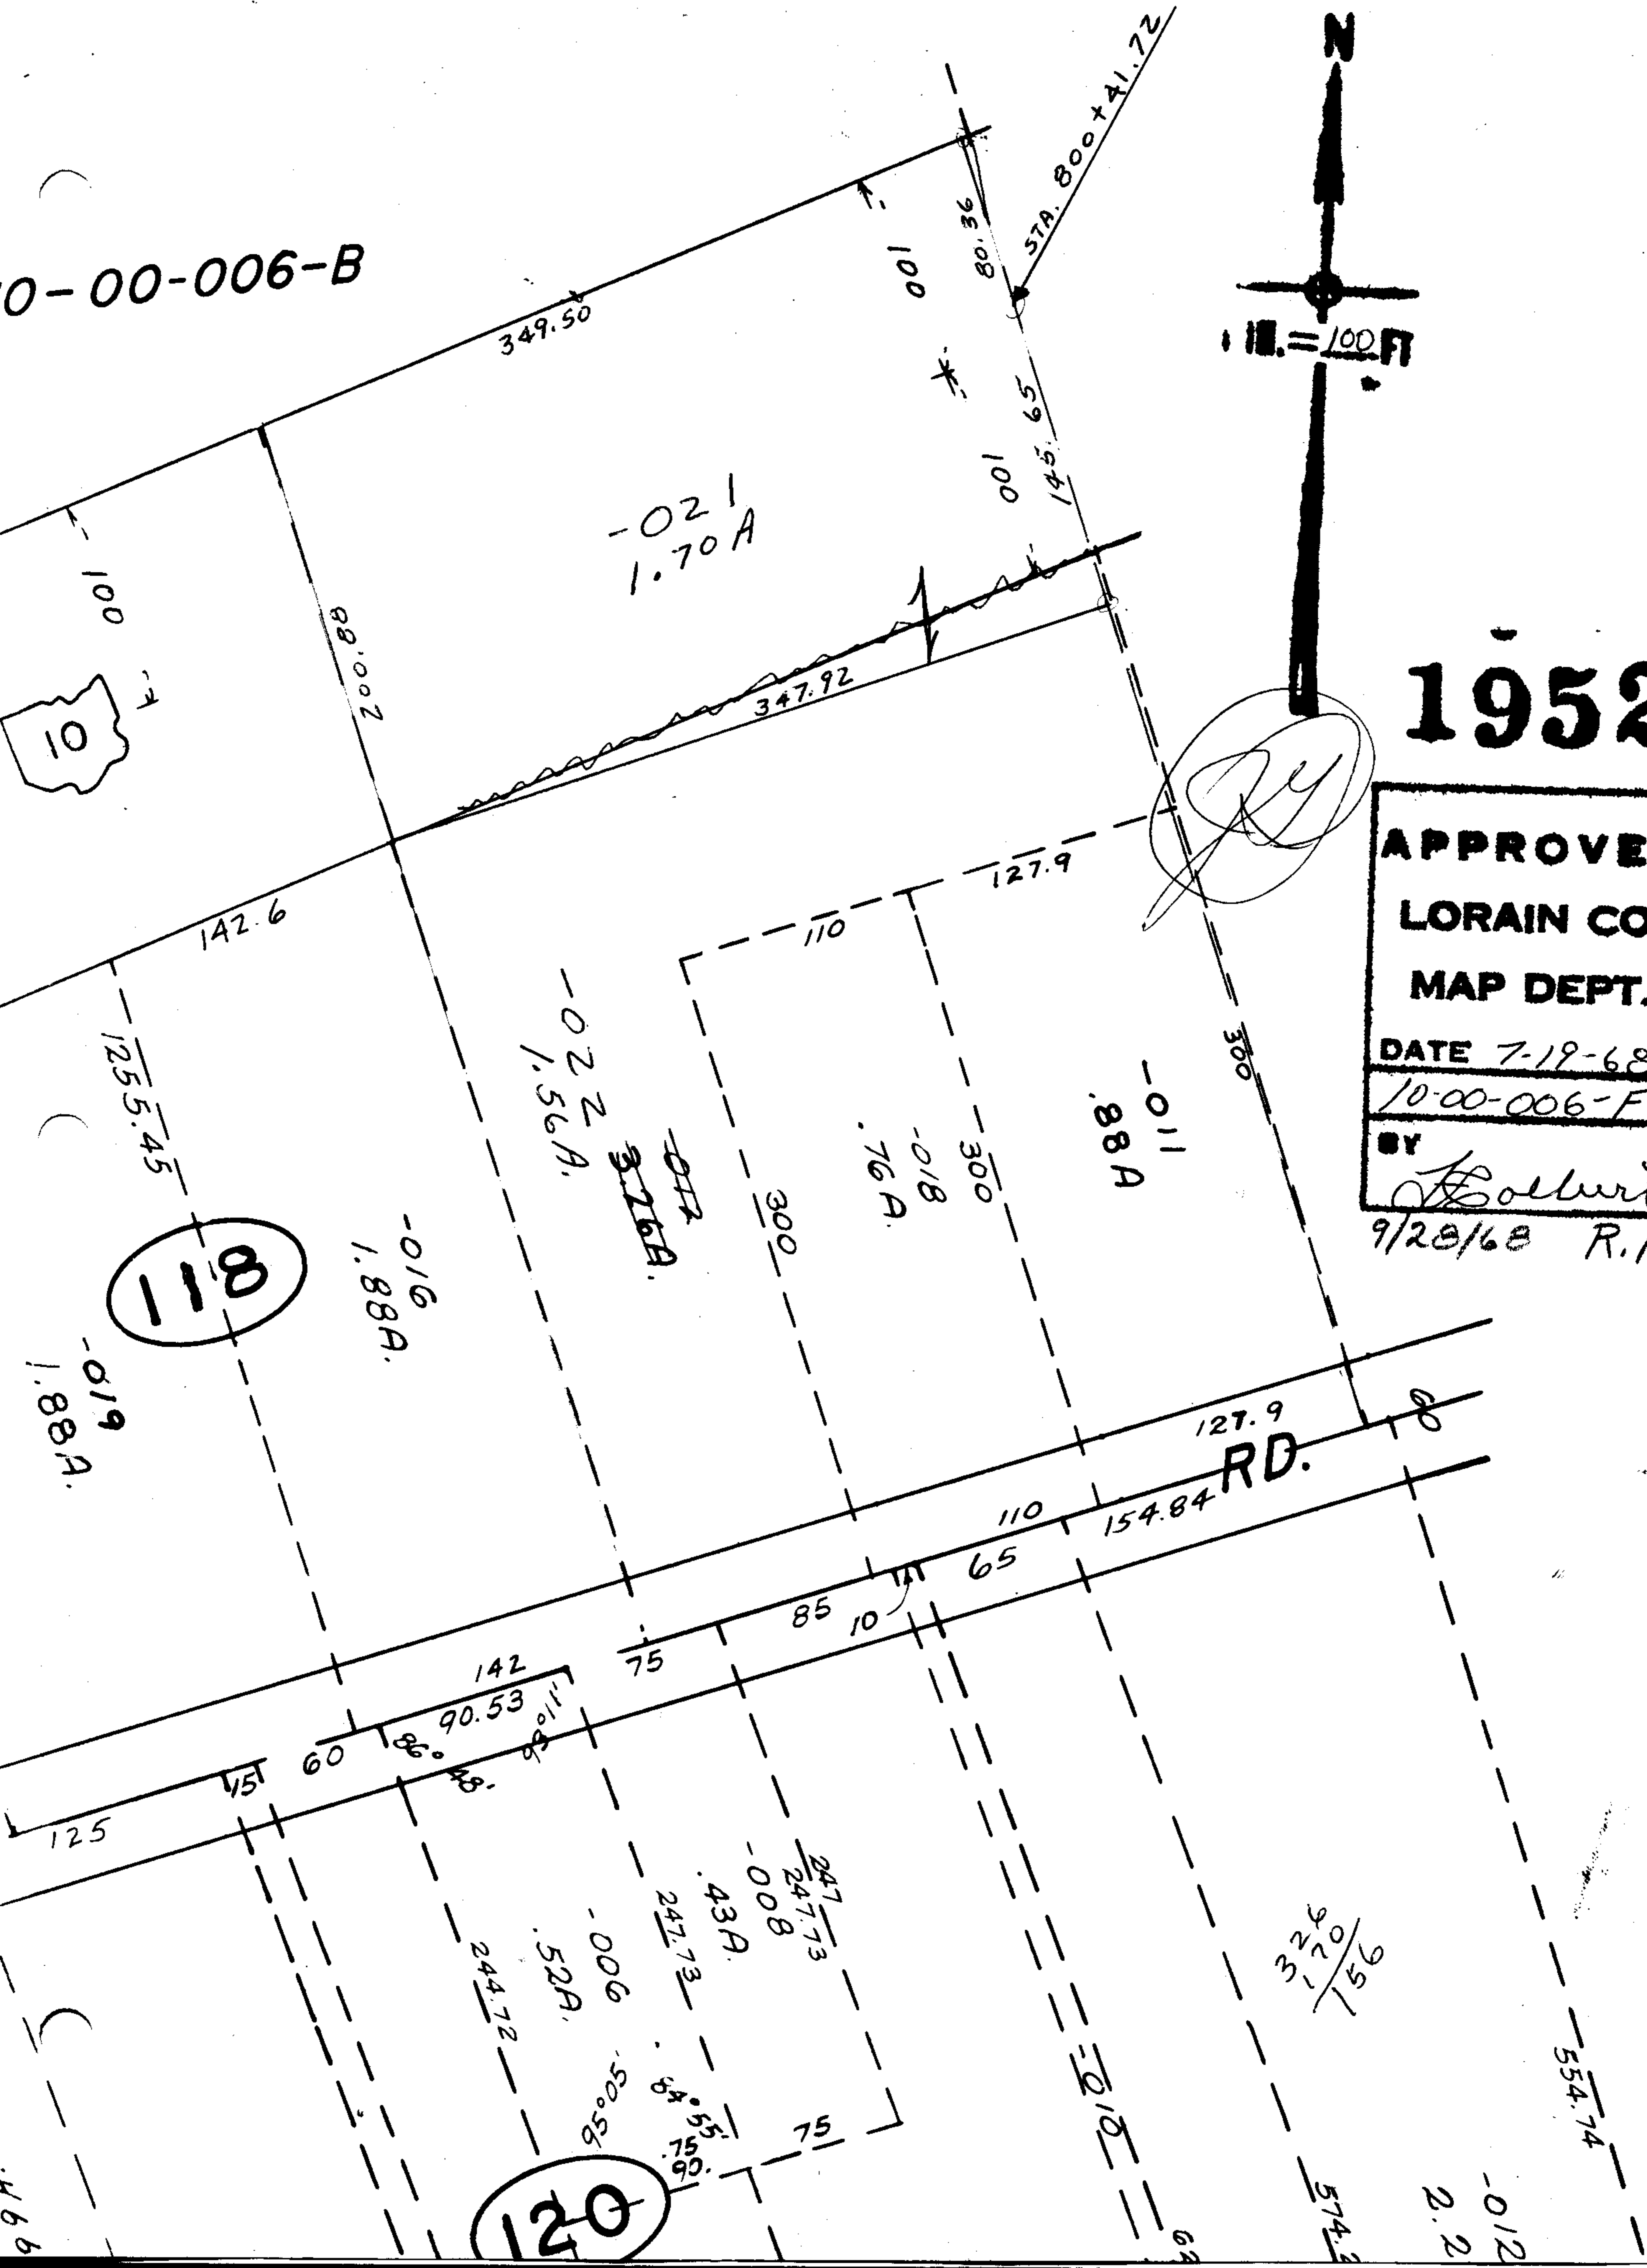

118

120

RD.

$\frac{95}{321}$

554.74

2.2

0.12

468