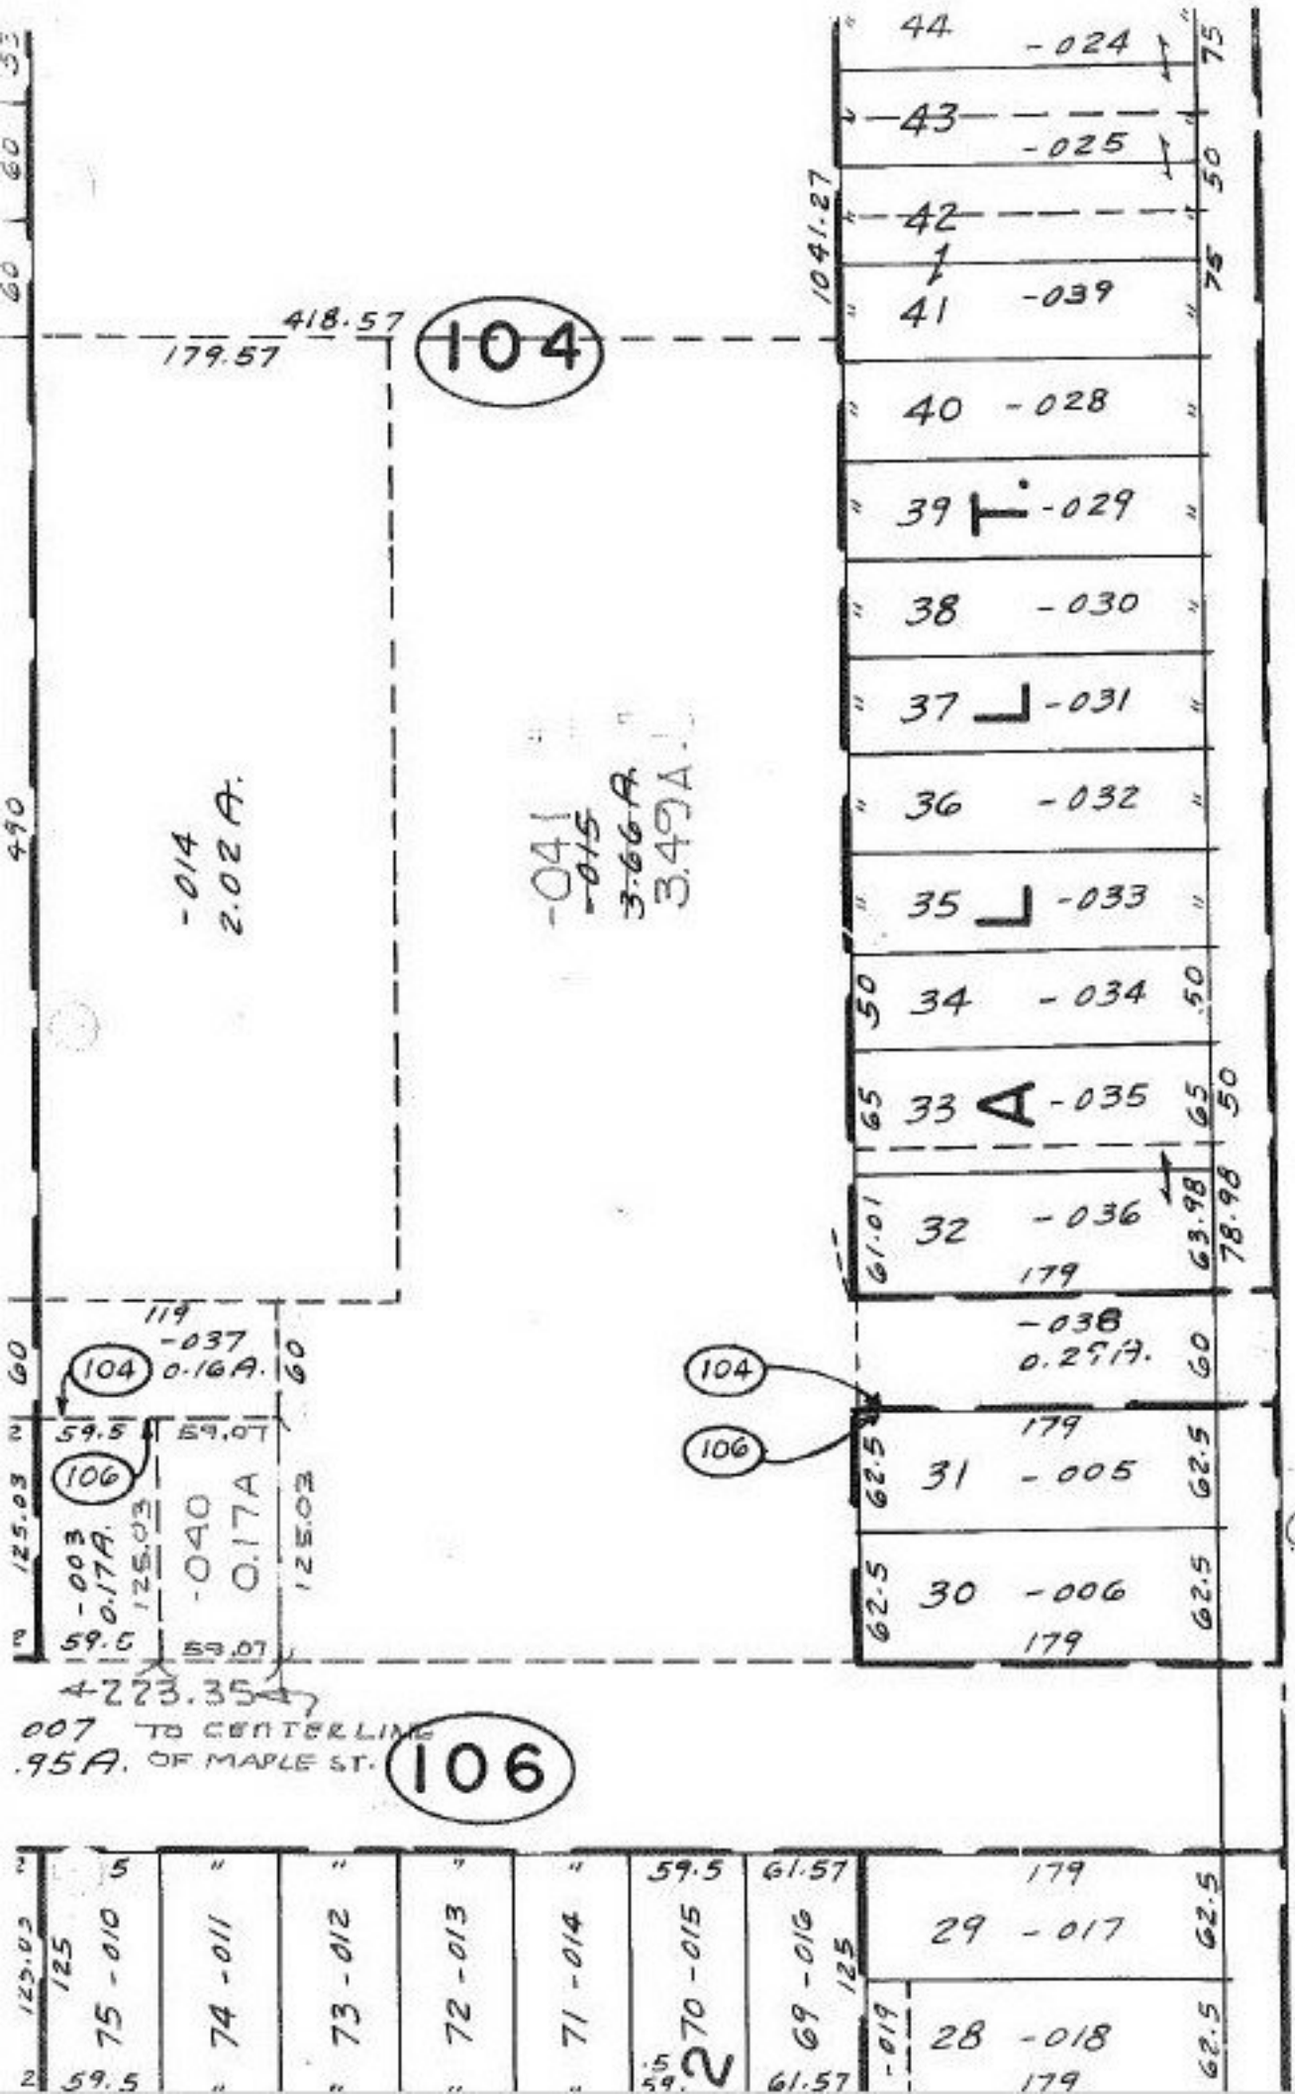

03-00-057-104- PRIOR INST. 1391/714 C=1: INF.
SURVEYED BY: KS ASSOC.

10/31/91

#19521

APPROVED
LORAIN CO.
MAP DEPT.

DATE 8-20-91

PAGE 3-00-057-A

BY CARALYN FRANCIS

VOID AFTER # 19521