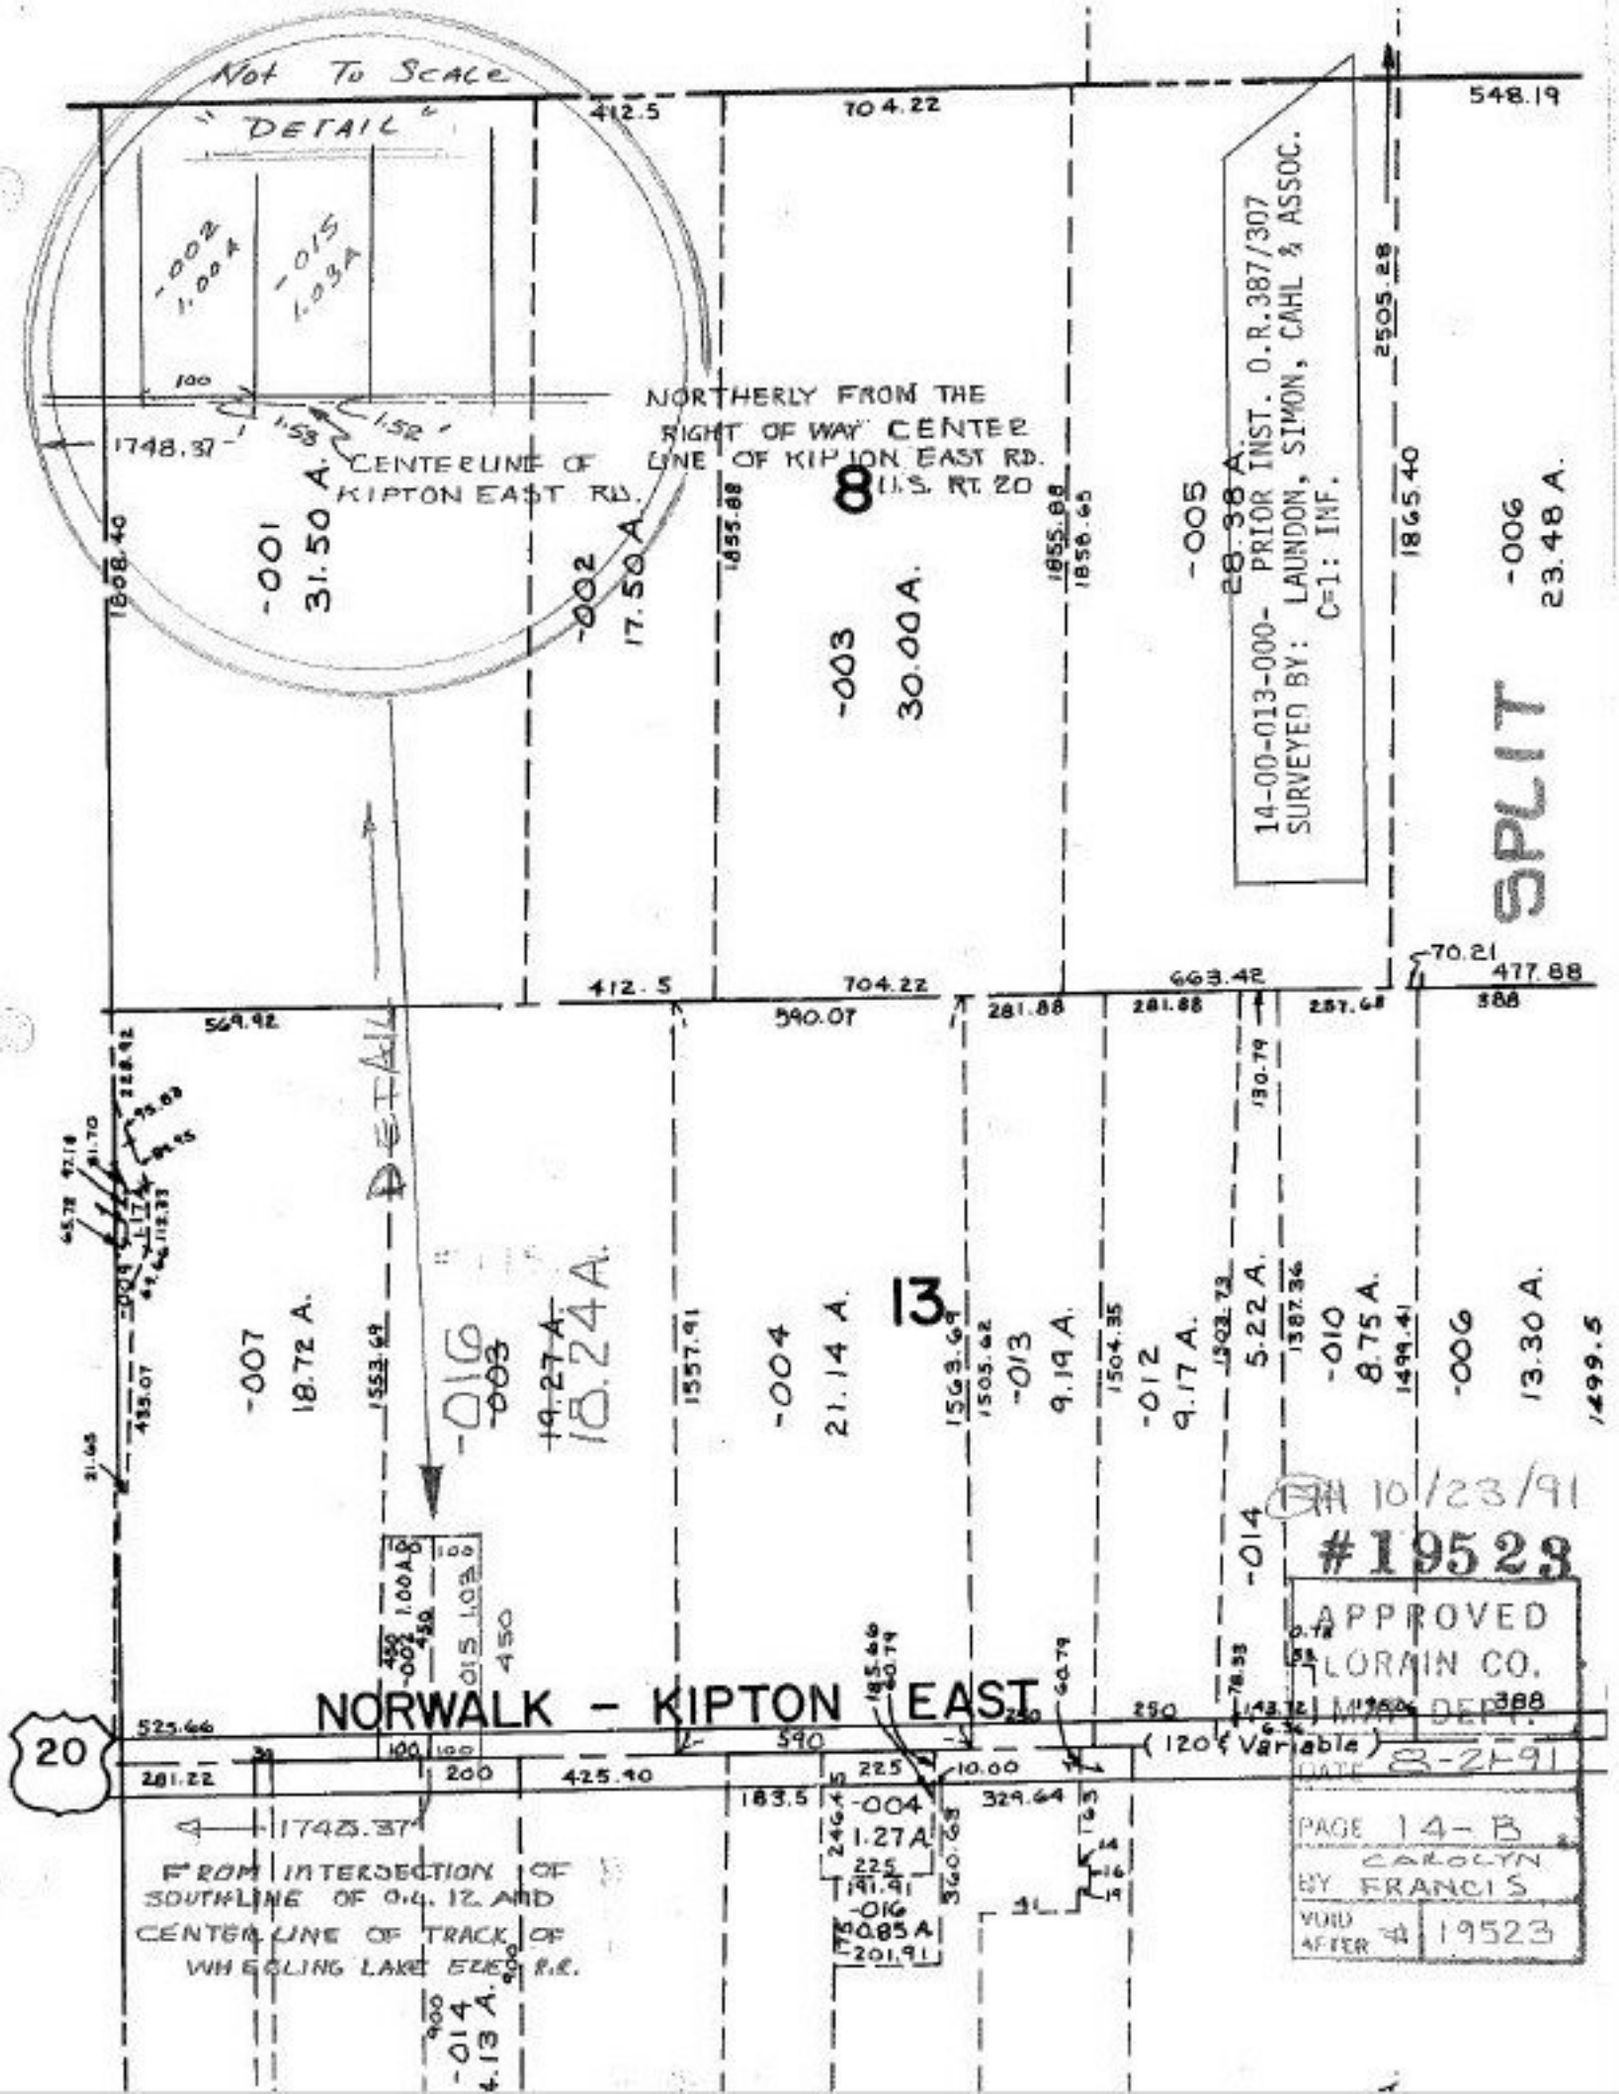

Not To Scale
"DETAIL"
-002 1.00A
-015 1.03A
NORTHERLY FROM THE RIGHT OF WAY CENTER LINE OF KIPTON EAST RD. U.S. RT. 20
CENTERLINE OF KIPTON EAST RD.
8
-001 31.50 A.
-002 17.50 A.
-003 30.00 A.
-005 28.38 A.
-006 23.48 A.
14-00-013-000- PRIOR INST. O.R.387/307
SURVEYED BY: LAUNDON, SIMON, CAHL & ASSOC.
C=1: INF.
SPLIT
DETAIL
13
-007 18.72 A.
-016 -003 19.27 A. 18.24 A.
-004 21.14 A.
-013 9.19 A.
-012 9.17 A.
-014 5.22 A.
-010 8.75 A.
-006 13.30 A.
NORWALK - KIPTON EAST
20
(120' Variable)
-004 1.27 A.
-016 0.85 A.
-014 4.13 A.
FROM INTERSECTION OF SOUTHLINE OF O.L. 12 AND CENTERLINE OF TRACK OF WHEELING LAKE ERIE R.R.
1748.37
1748.37
10/23/91
#19523
APPROVED
LORAIN CO.
MAP DEPT.
DATE 8-21-91
PAGE 14-B
BY CAROLYN FRANCIS
VOID AFTER # 19523