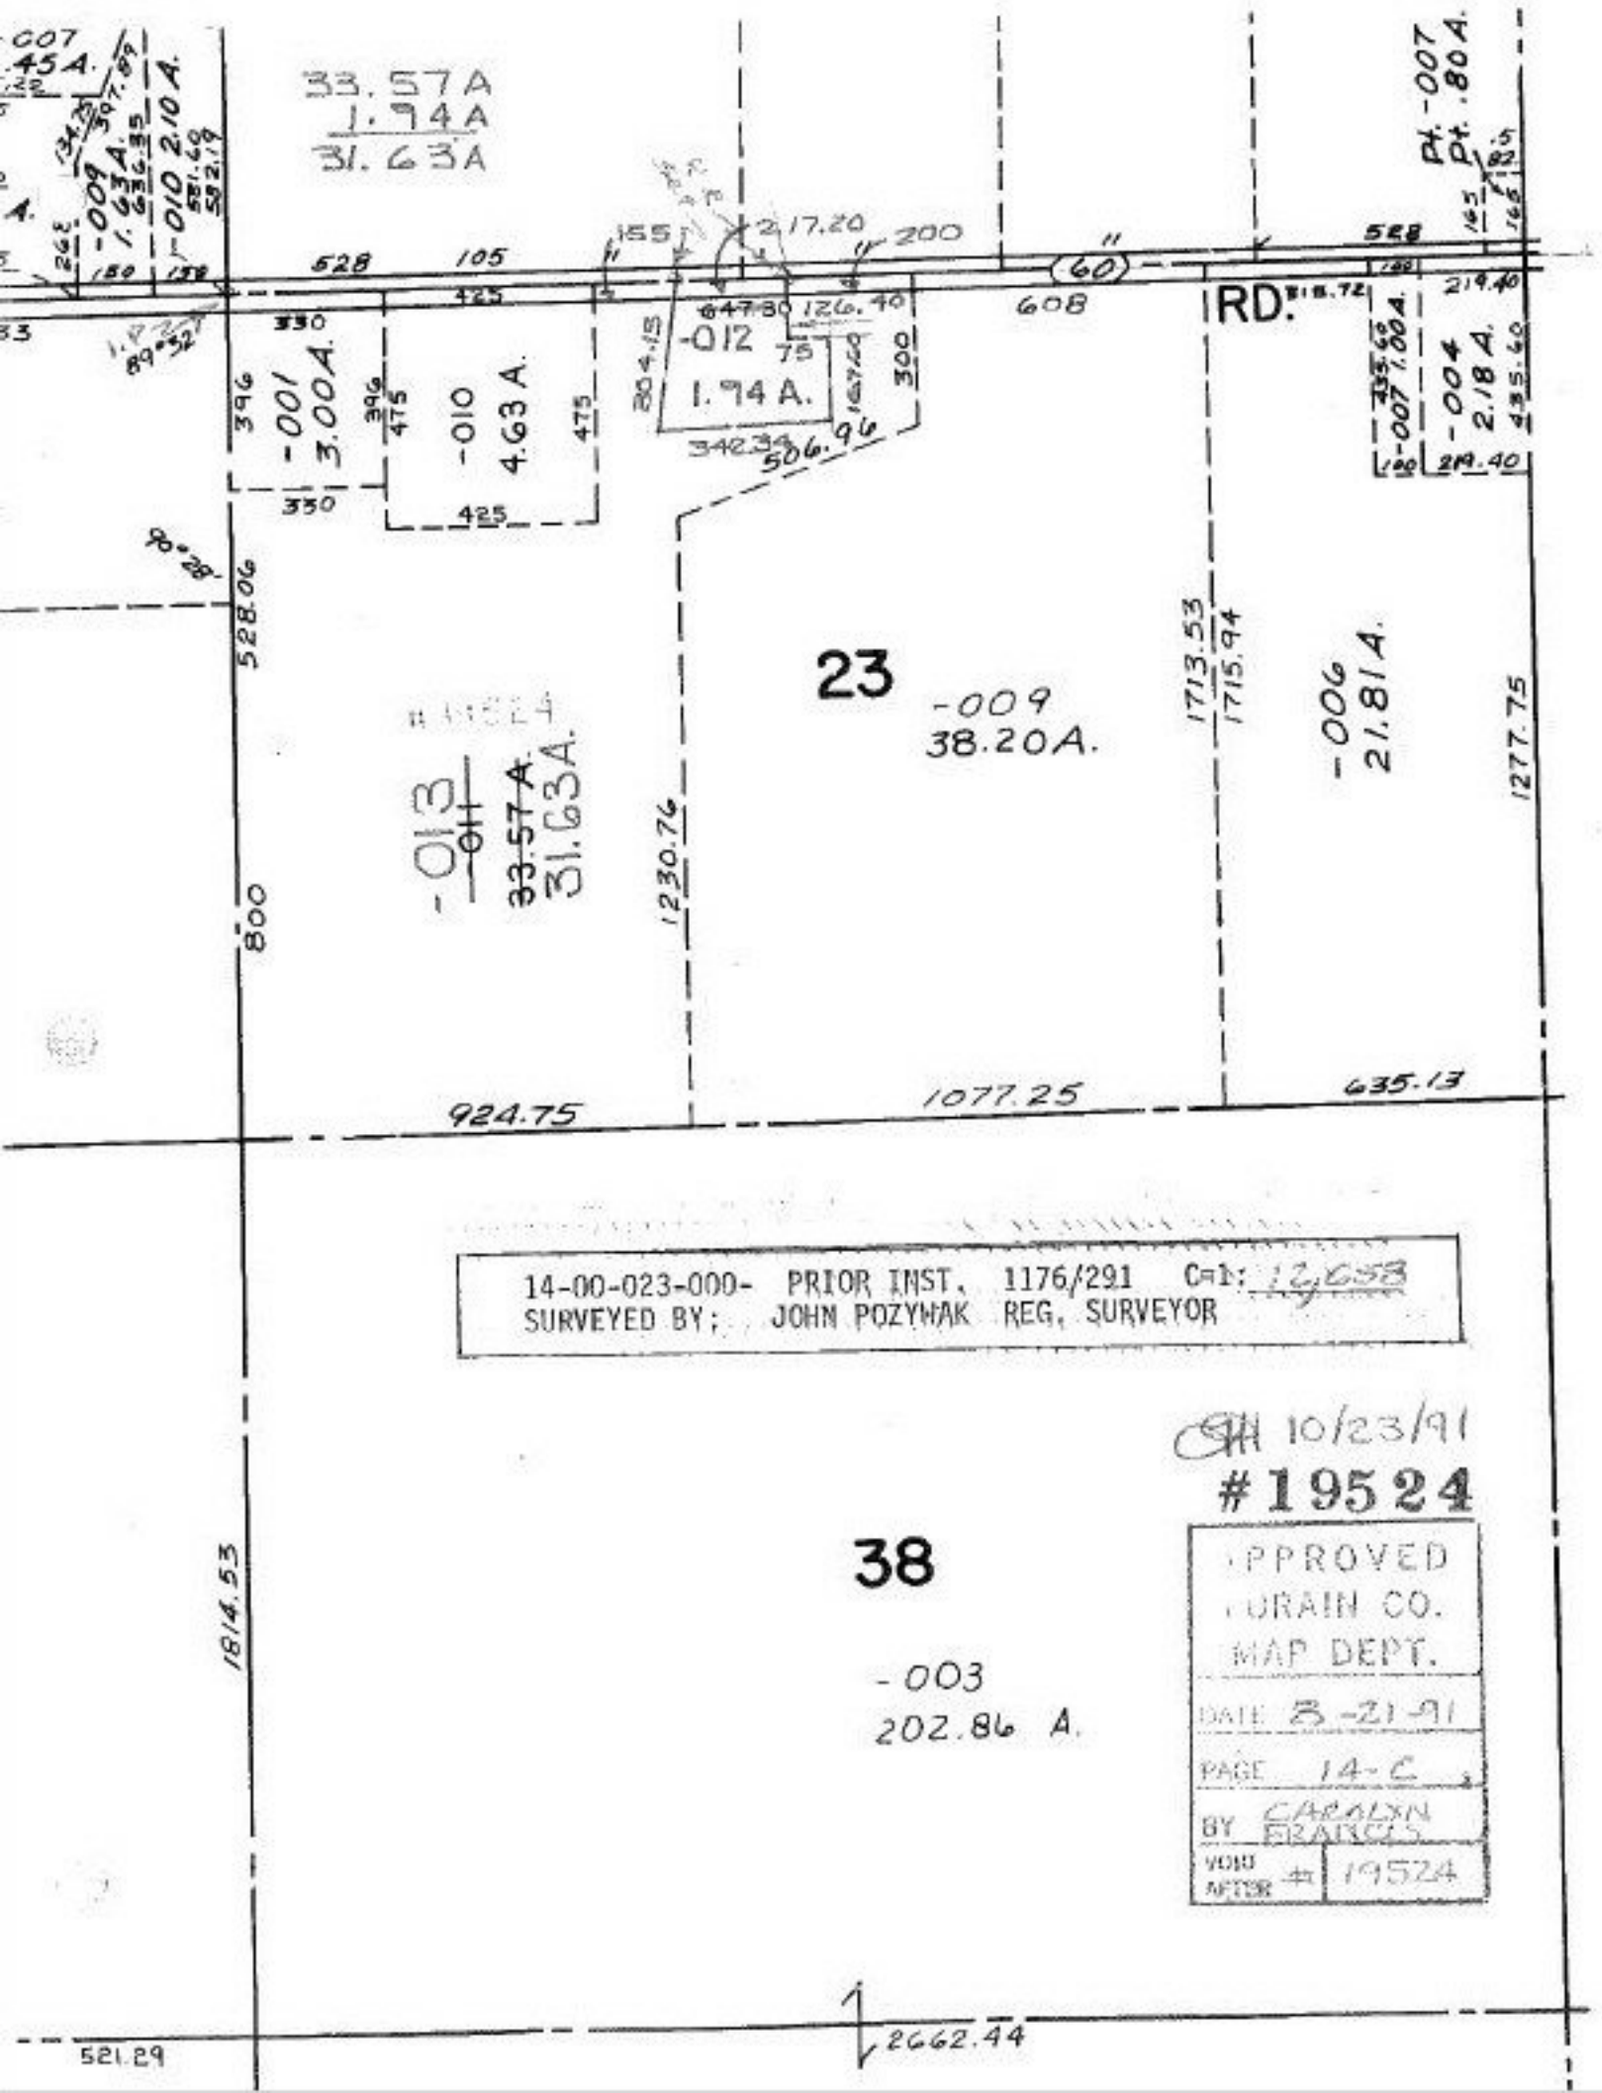
33.57A
1.94A
31.63A
-007
Pt. .80A.
-009
1.63A.
-010 2.10A.
528
105
155
217.20
200
60
RD.
608
-012
1.94 A.
-001
3.004A.
-010
4.63 A.
-004
2.18A.
-007
1.00A.
435.60
219.40
506.96
342.39
528.06
23
-009
38.20A.
1713.53
1715.94
-006
21.81A.
1277.75
-013
~~33.57A.~~
31.63A.
1230.76
800
924.75
1077.25
635.13
14-00-023-000- PRIOR INST. 1176/291 Cnt: 12,658
SURVEYED BY; JOHN POZYWAK REG. SURVEYOR
10/23/91
#19524
APPROVED
MAP DEPT.
DATE 3-21-91
PAGE 14-C
BY CAROLYN FRANCIS
VOID AFTER # 19524
38
-003
202.86 A.
1814.53
521.29
2662.44