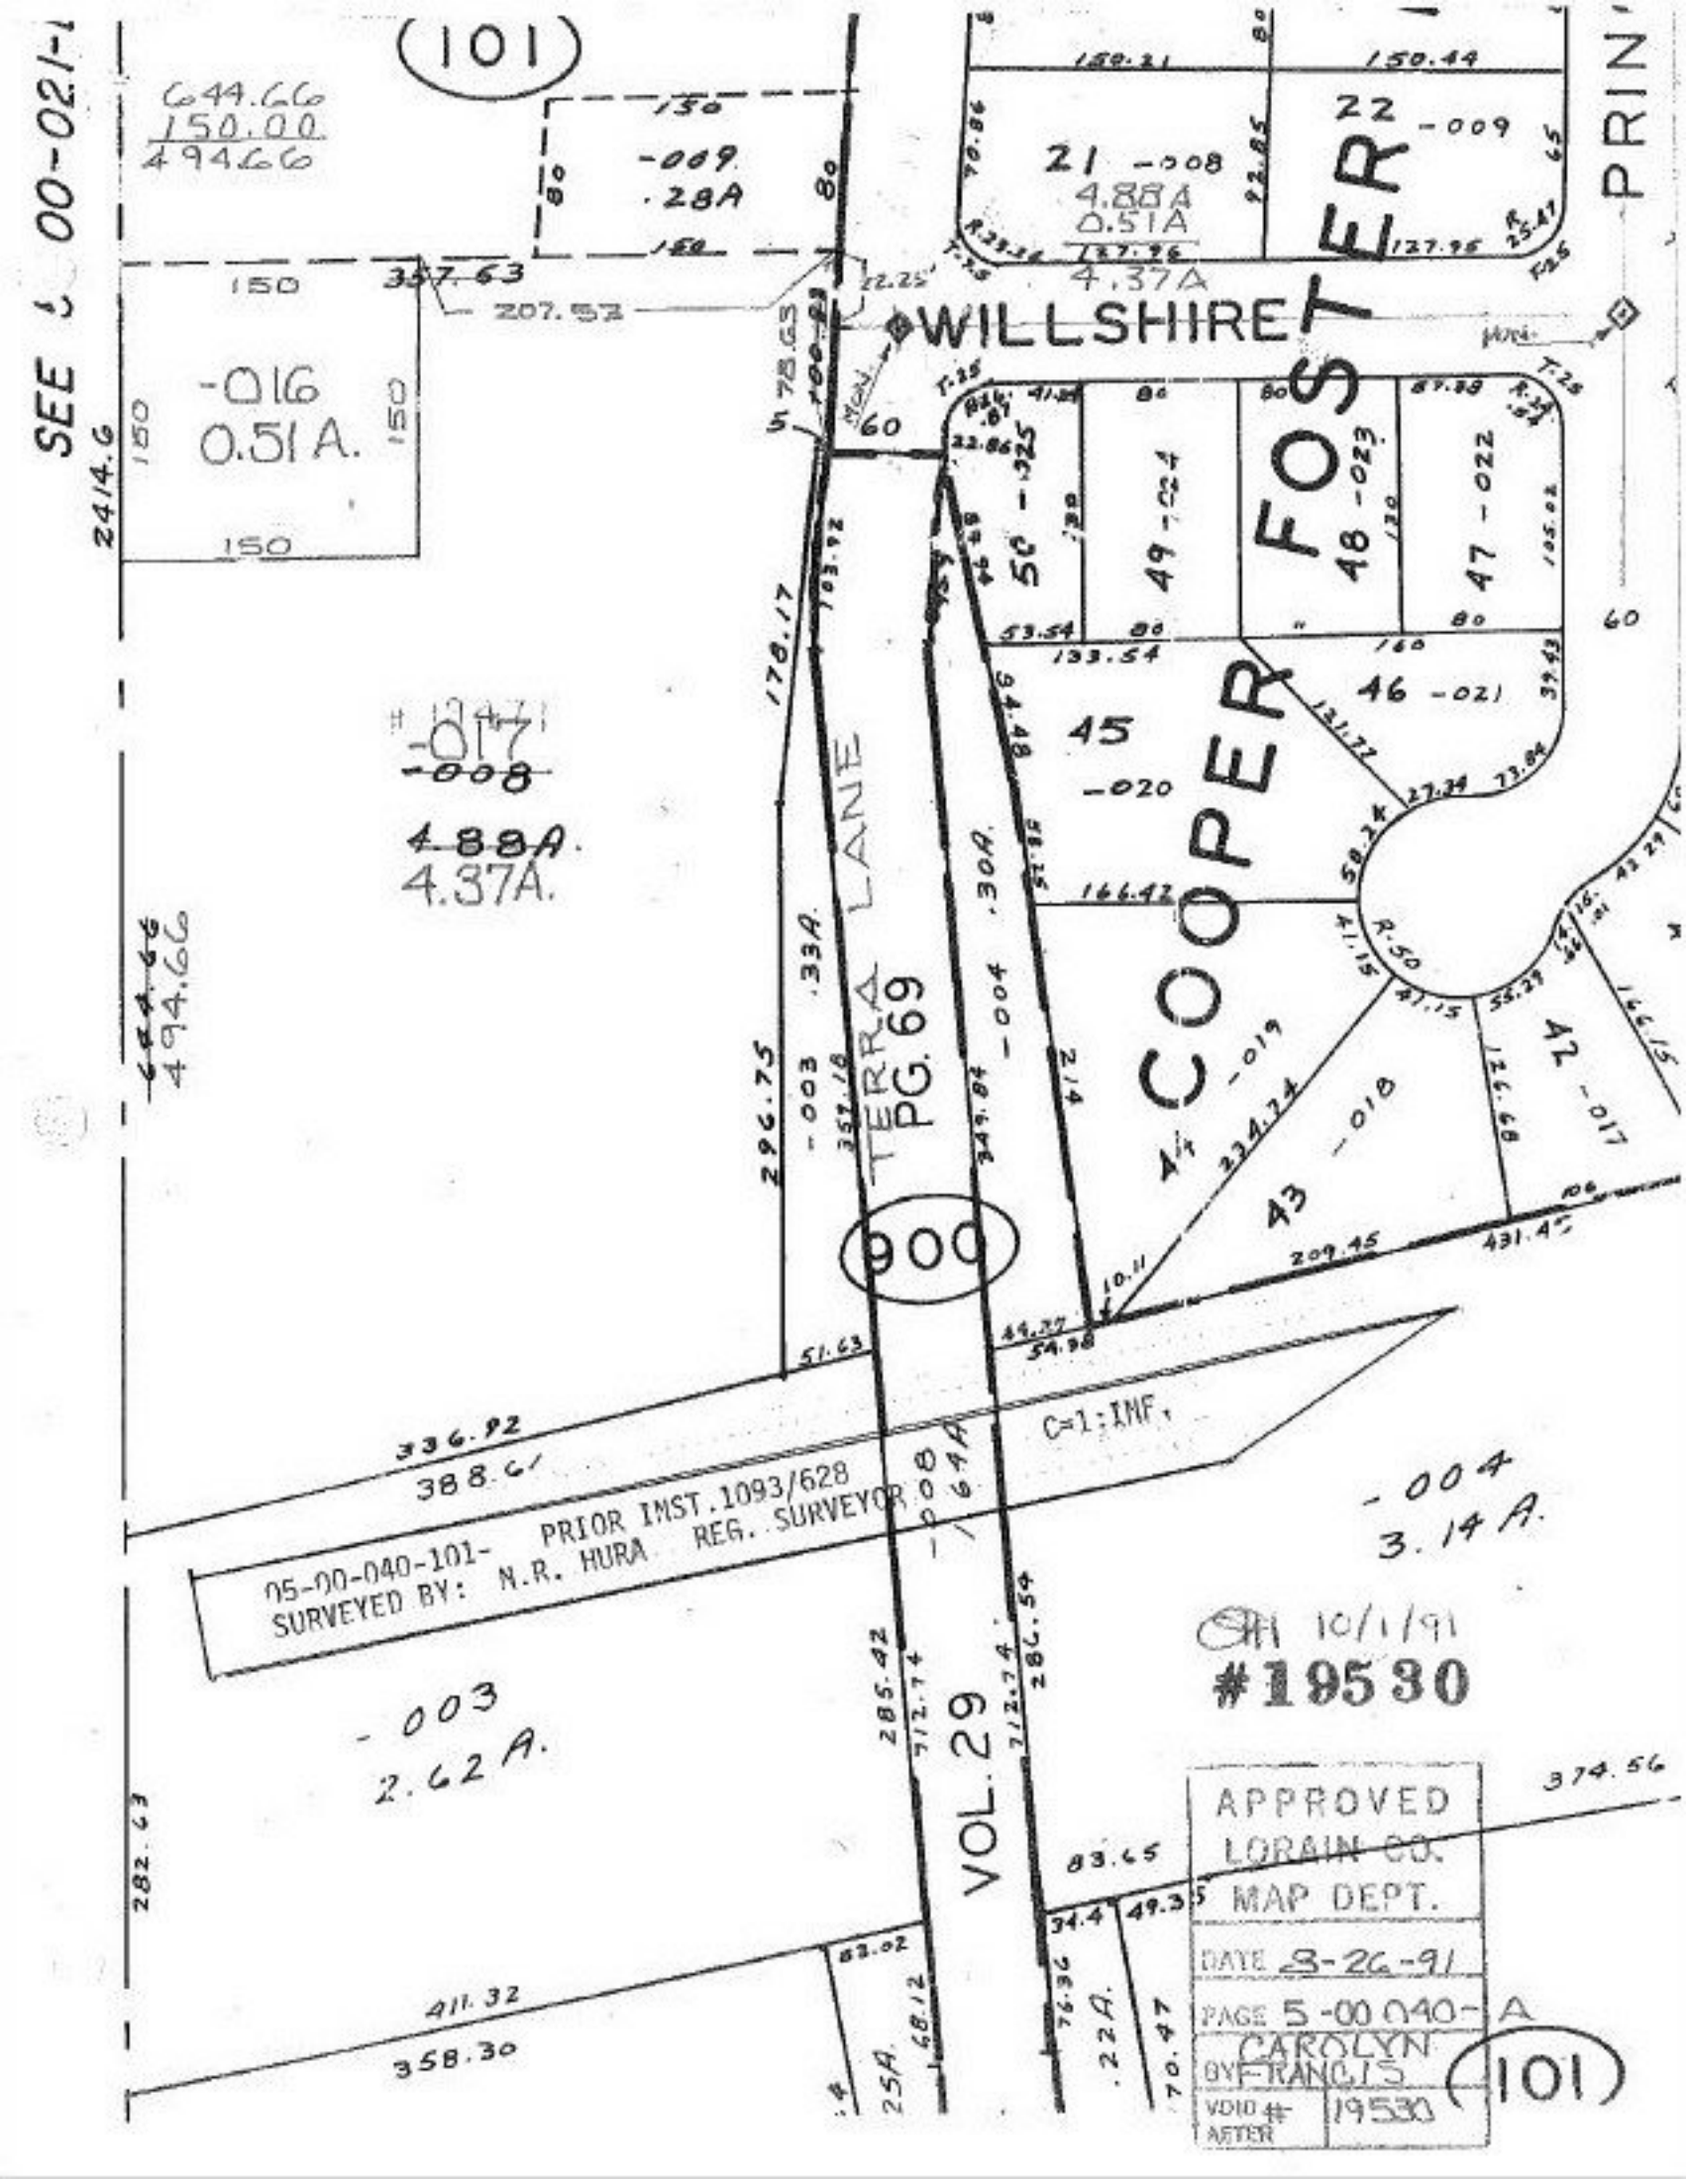

SEE 5 00-021-
101
644.66
150.00
494.66
-009
.28A
-016
0.51 A.
WILLSHIRE
COOPER FOSTER
PRIN
21 -008
4.88A
0.51A
4.37A
22 -009
50 -025
49 -024
48 -023
47 -022
46 -021
45
-020
44 -019
43 -018
42 -017
-017
-008
4.88A
4.37A.
494.66
TERRA LANE
PG. 69
900
-003 .33A.
-004 .30A.
-008 .64A
C=1:INF.
05-00-040-101- PRIOR INST.1093/628
SURVEYED BY: N.R. HURA REG. SURVEYOR
-004
3.14 A.
-003
2.62 A.
VOL. 29
10/1/91
#19530
APPROVED
LORAIN CO.
MAP DEPT.
DATE 8-26-91
PAGE 5-00 040-A
BY CAROLYN FRANCIS
VOID # 19530
AFTER
101