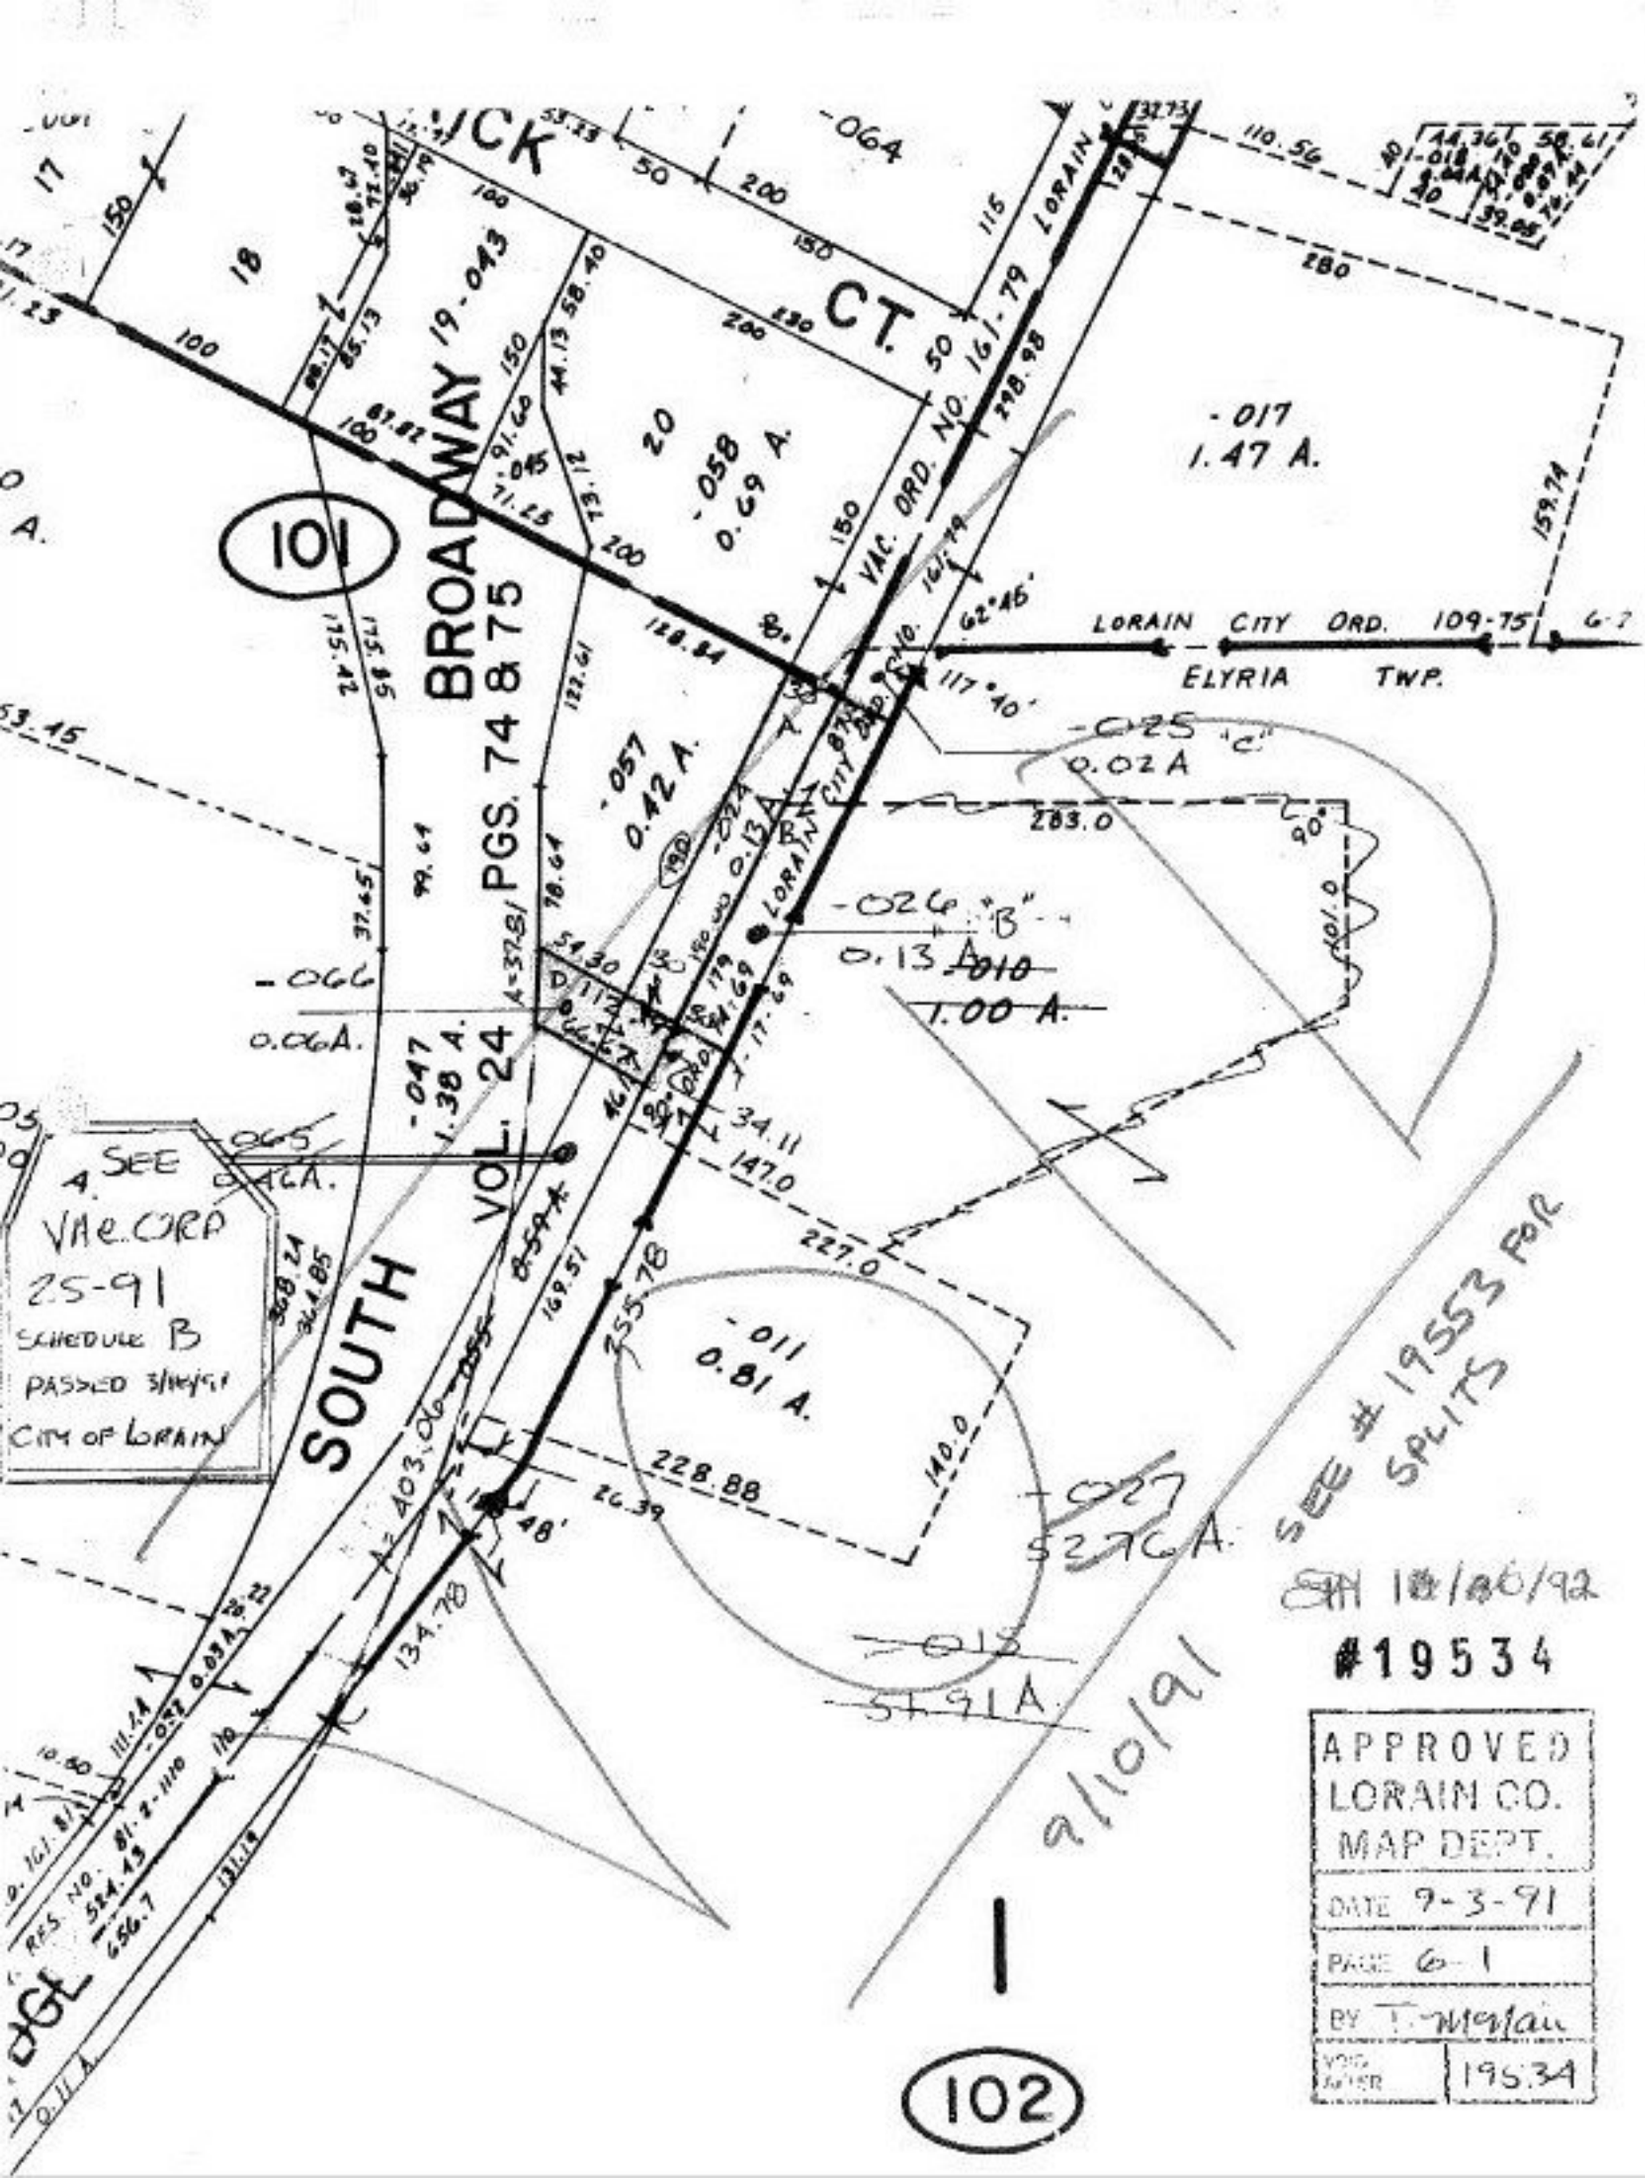

BROADWAY
SOUTH
CT.
PGS. 74 & 75
VOL. 24
VAC. ORD. NO. 161-79
LORAIN
LORAIN CITY ORD. 109-75
ELYRIA TWP.
-017
1.47 A.
-058
0.69 A.
-057
0.42 A.
-047
1.38 A.
-066
0.06A.
-025 "C"
0.02 A
-026 "B"
0.13 A
-010
1.00 A.
-011
0.81 A.
-027
5.76 A.
-018
51.91 A.
SEE VAC. ORD 25-91 SCHEDULE B PASSED 3/16/91 CITY OF LORAIN
SEE #19553 FOR SPLITS
9/10/91
#19534
APPROVED LORAIN CO. MAP DEPT.
DATE 9-3-91
PAGE 6-1
BY T. McNair
VOID AFTER 19534
101
102