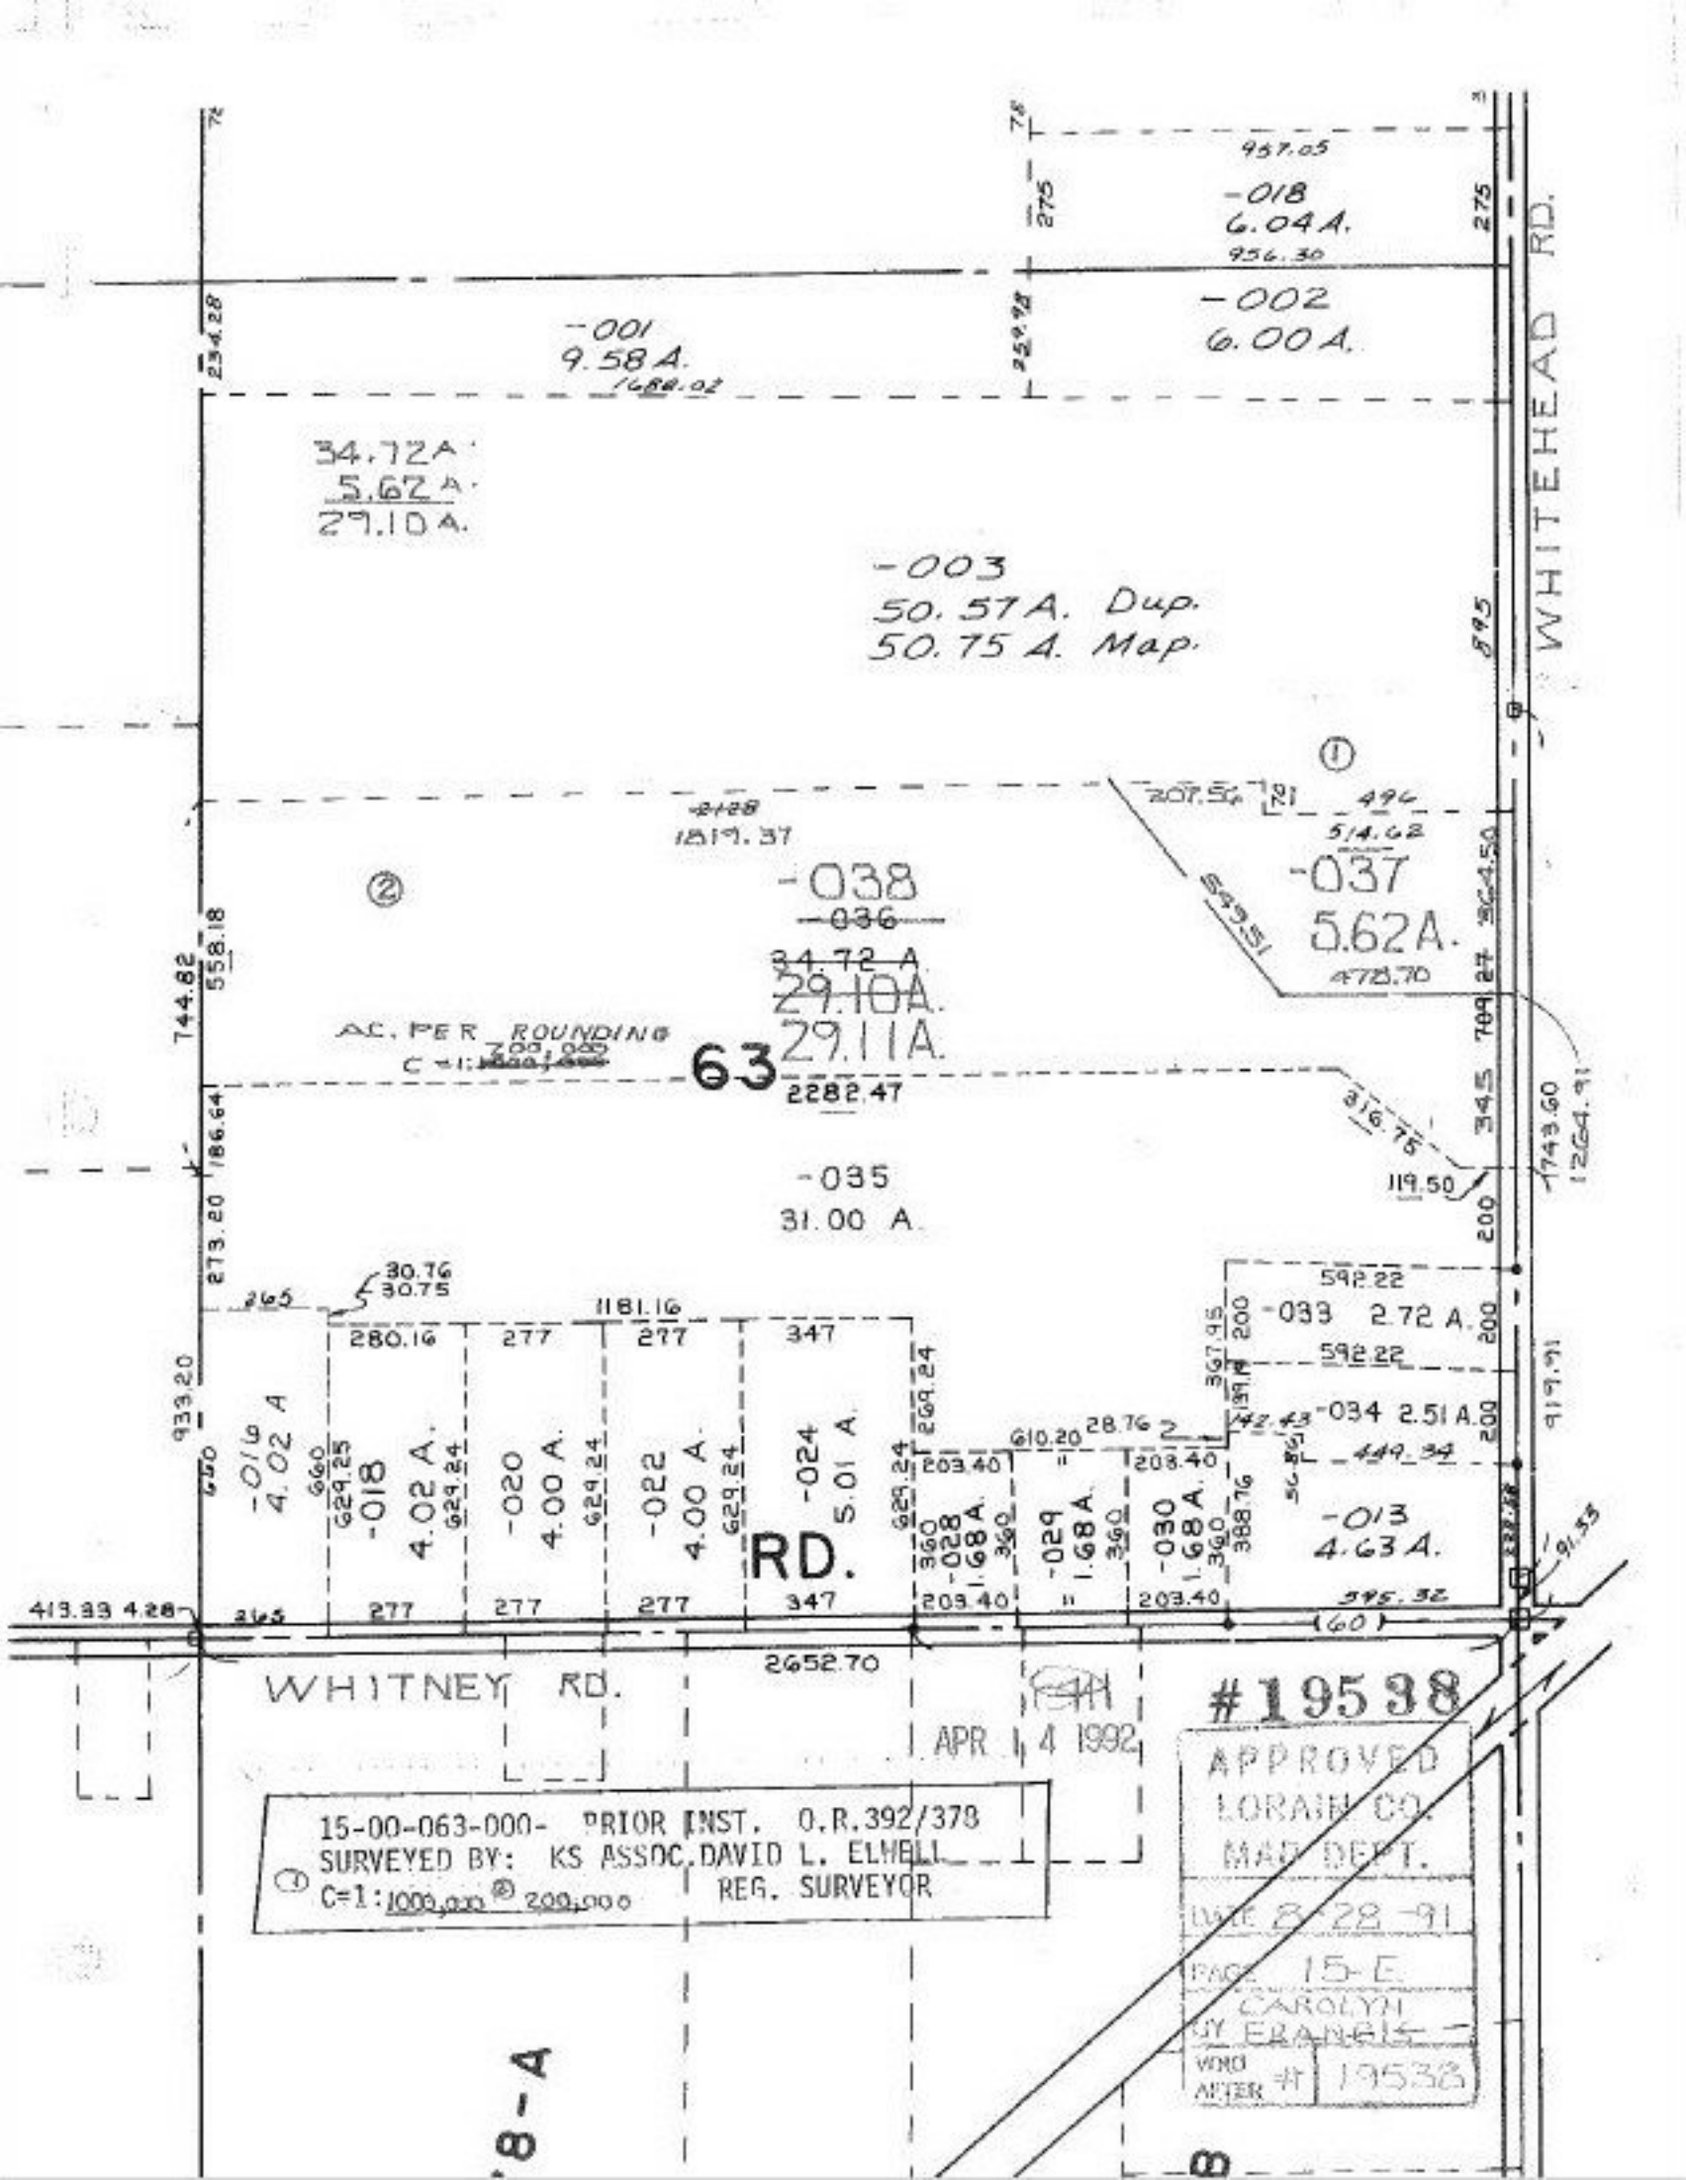
WHITEHEAD RD.
WHITNEY RD.
-001
9.58 A.
-002
6.00 A.
-018
6.04 A.
34.72 A.
5.62 A.
29.10 A.
-003
50.57 A. Dup.
50.75 A. Map.
-038
-036
34.72 A
29.10A.
29.11A.
63
-037
5.62A.
-035
31.00 A.
-033 2.72 A.
-034 2.51 A.
-013
4.63 A.
-016
4.02 A.
-018
4.02 A.
-020
4.00 A.
-022
4.00 A.
-024
5.01 A.
RD.
-028
1.68 A.
-029
1.68 A.
-030
1.68 A.
15-00-063-000- PRIOR INST. O.R.392/378
SURVEYED BY: KS ASSOC. DAVID L. ELWELL
C=1:1000.00 @ 200.00 REG. SURVEYOR
APR 14 1992
#19538
APPROVED
LORAIN CO.
MAP DEPT.
DATE 8-28-91
PAGE 15-E
BY CAROLYN
WHO AFTER # 19538