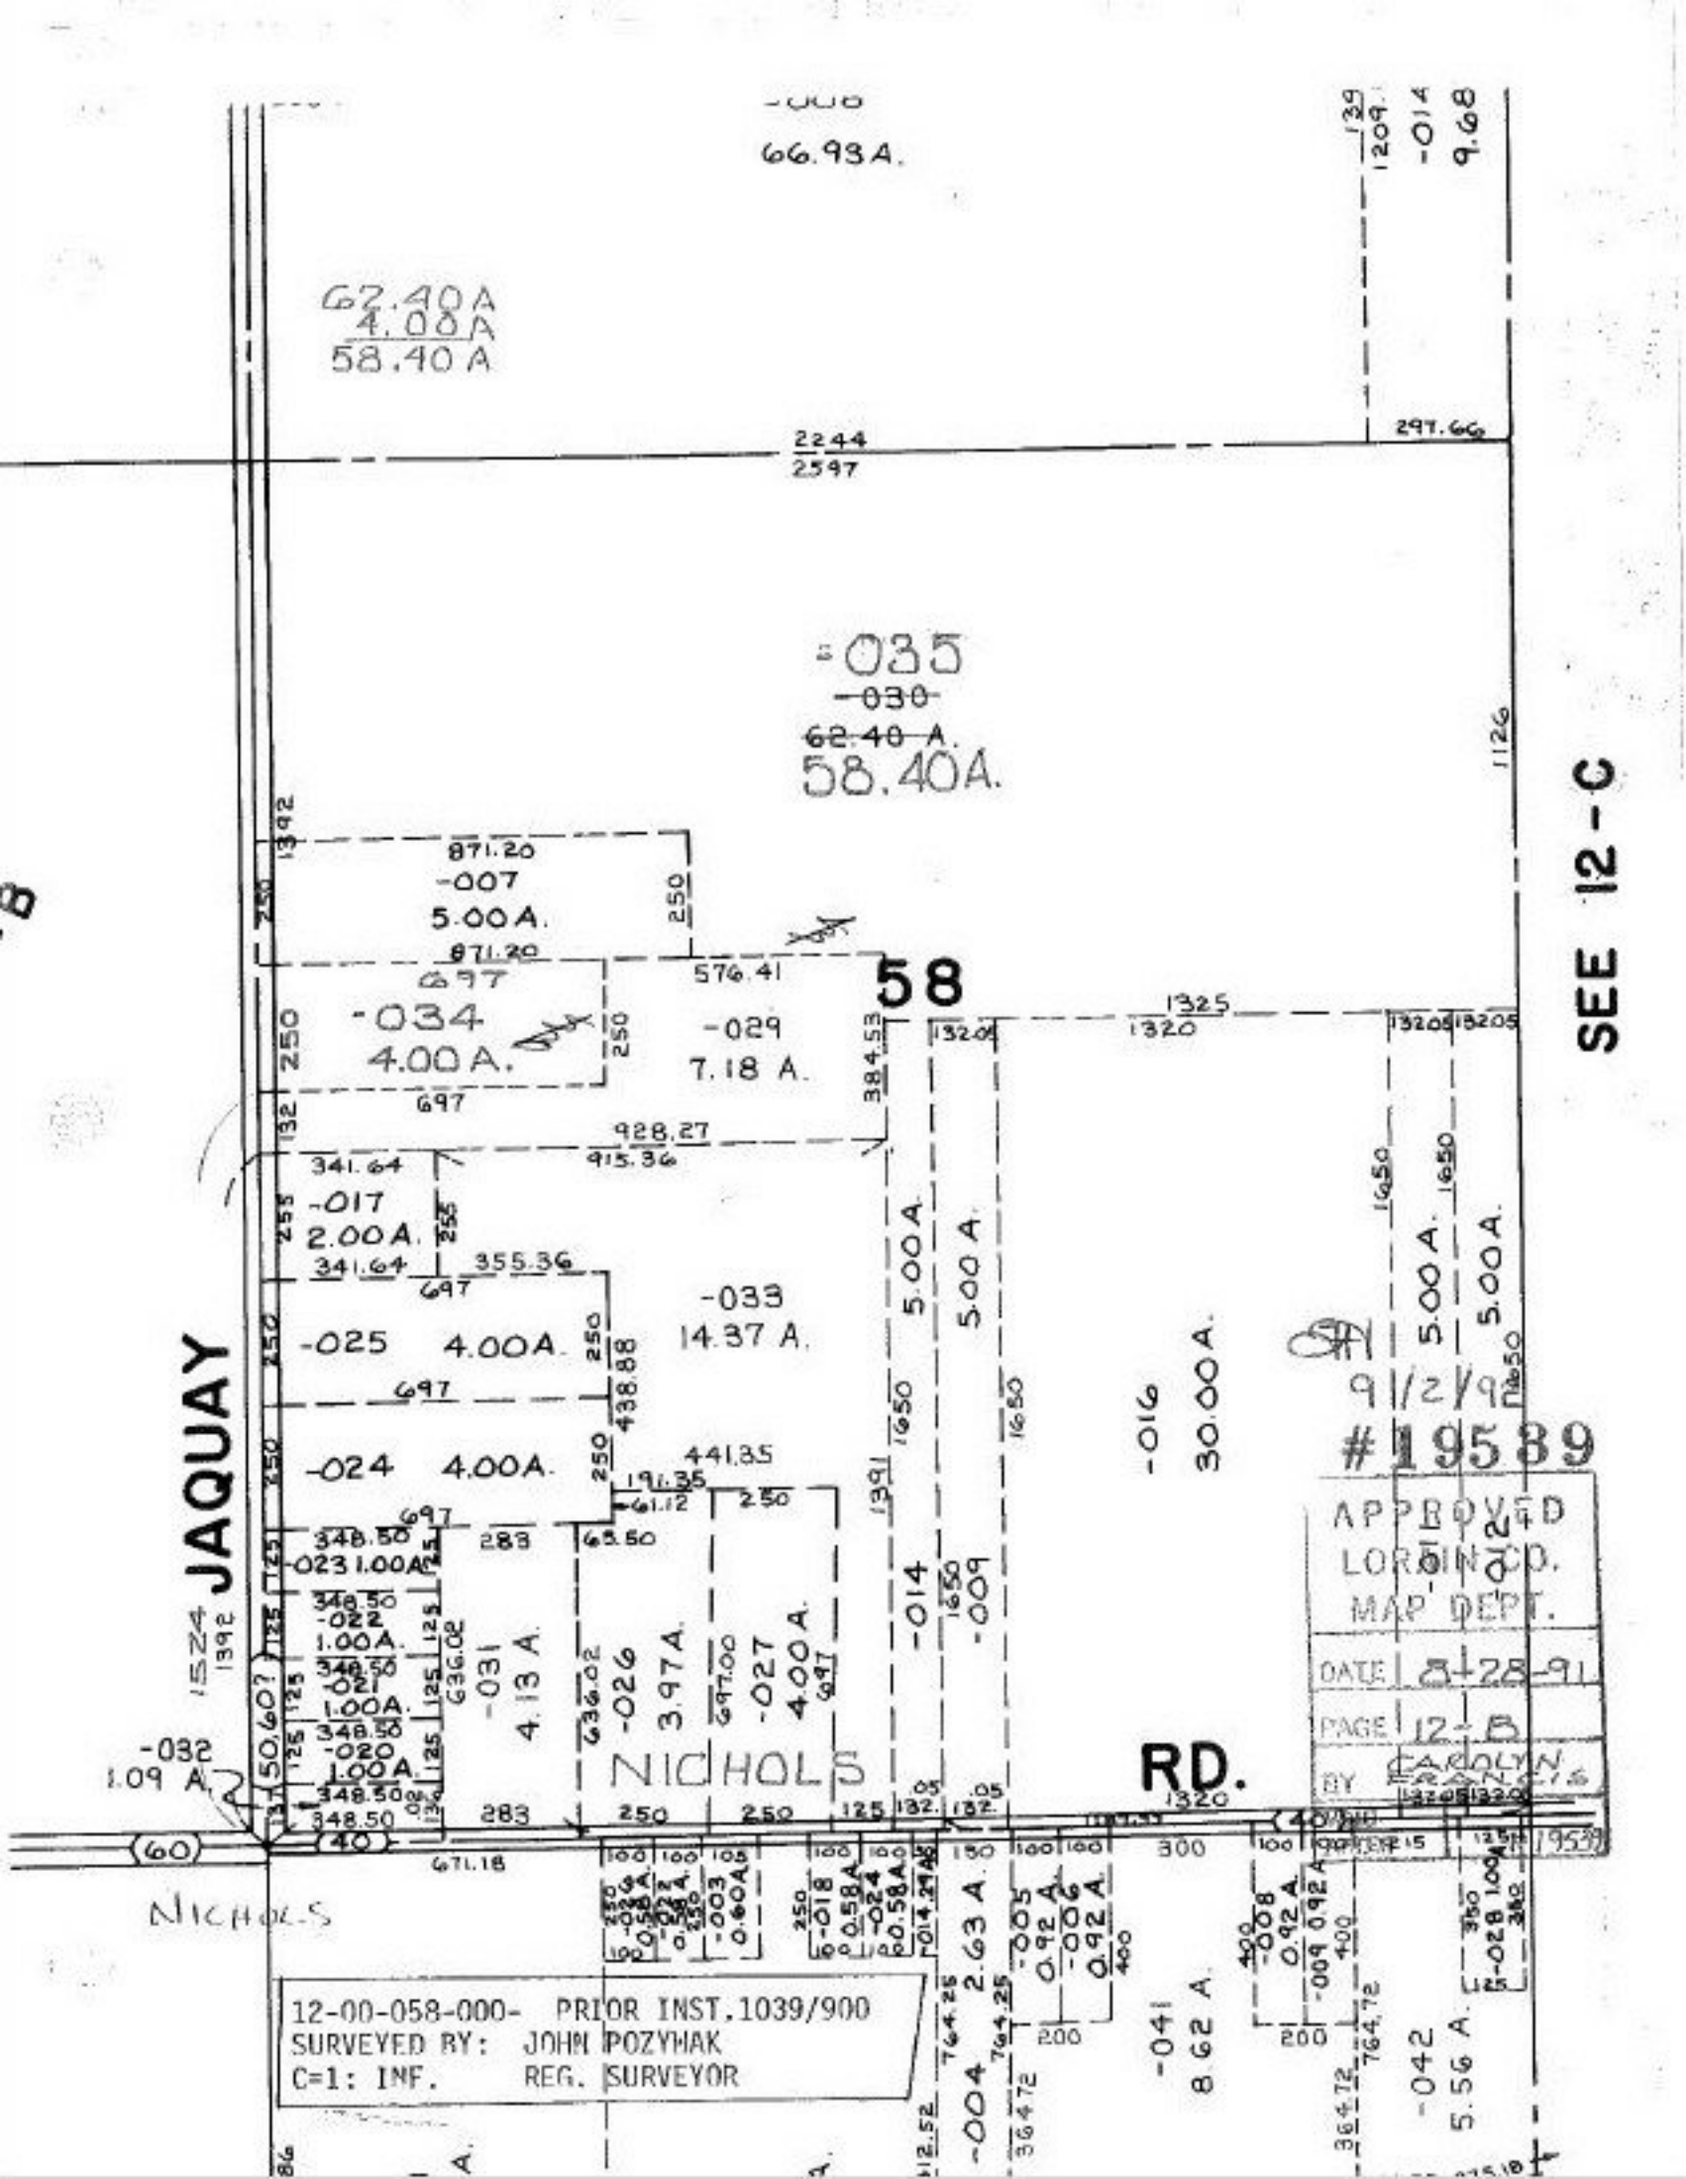
66.93A.
62.40A
4.00A
58.40A
-035
-030
62.40 A.
58.40A.
SEE 12-C
-007
5.00A.
-034
4.00A.
-029
7.18 A.
58
-017
2.00A.
-033
14.37 A.
-025 4.00A.
-024 4.00A.
-023 1.00A.
-022
1.00A.
-021
1.00A.
-020
1.00A.
-032
1.09 A.
-031
4.13 A.
-026
3.97A.
-027
4.00A.
-014
5.00A.
-009
5.00A.
-016
30.00A.
5.00A.
5.00A.
JAQUAY
NICHOLS
RD.
NICHOLS
APPROVED
LORAIN CO.
MAP DEPT.
DATE 8-28-91
PAGE 12-B
BY CAROLYN
9/2/91
#19539
12-00-058-000- PRIOR INST. 1039/900
SURVEYED BY: JOHN POZYWAK
C=1: INF. REG. SURVEYOR