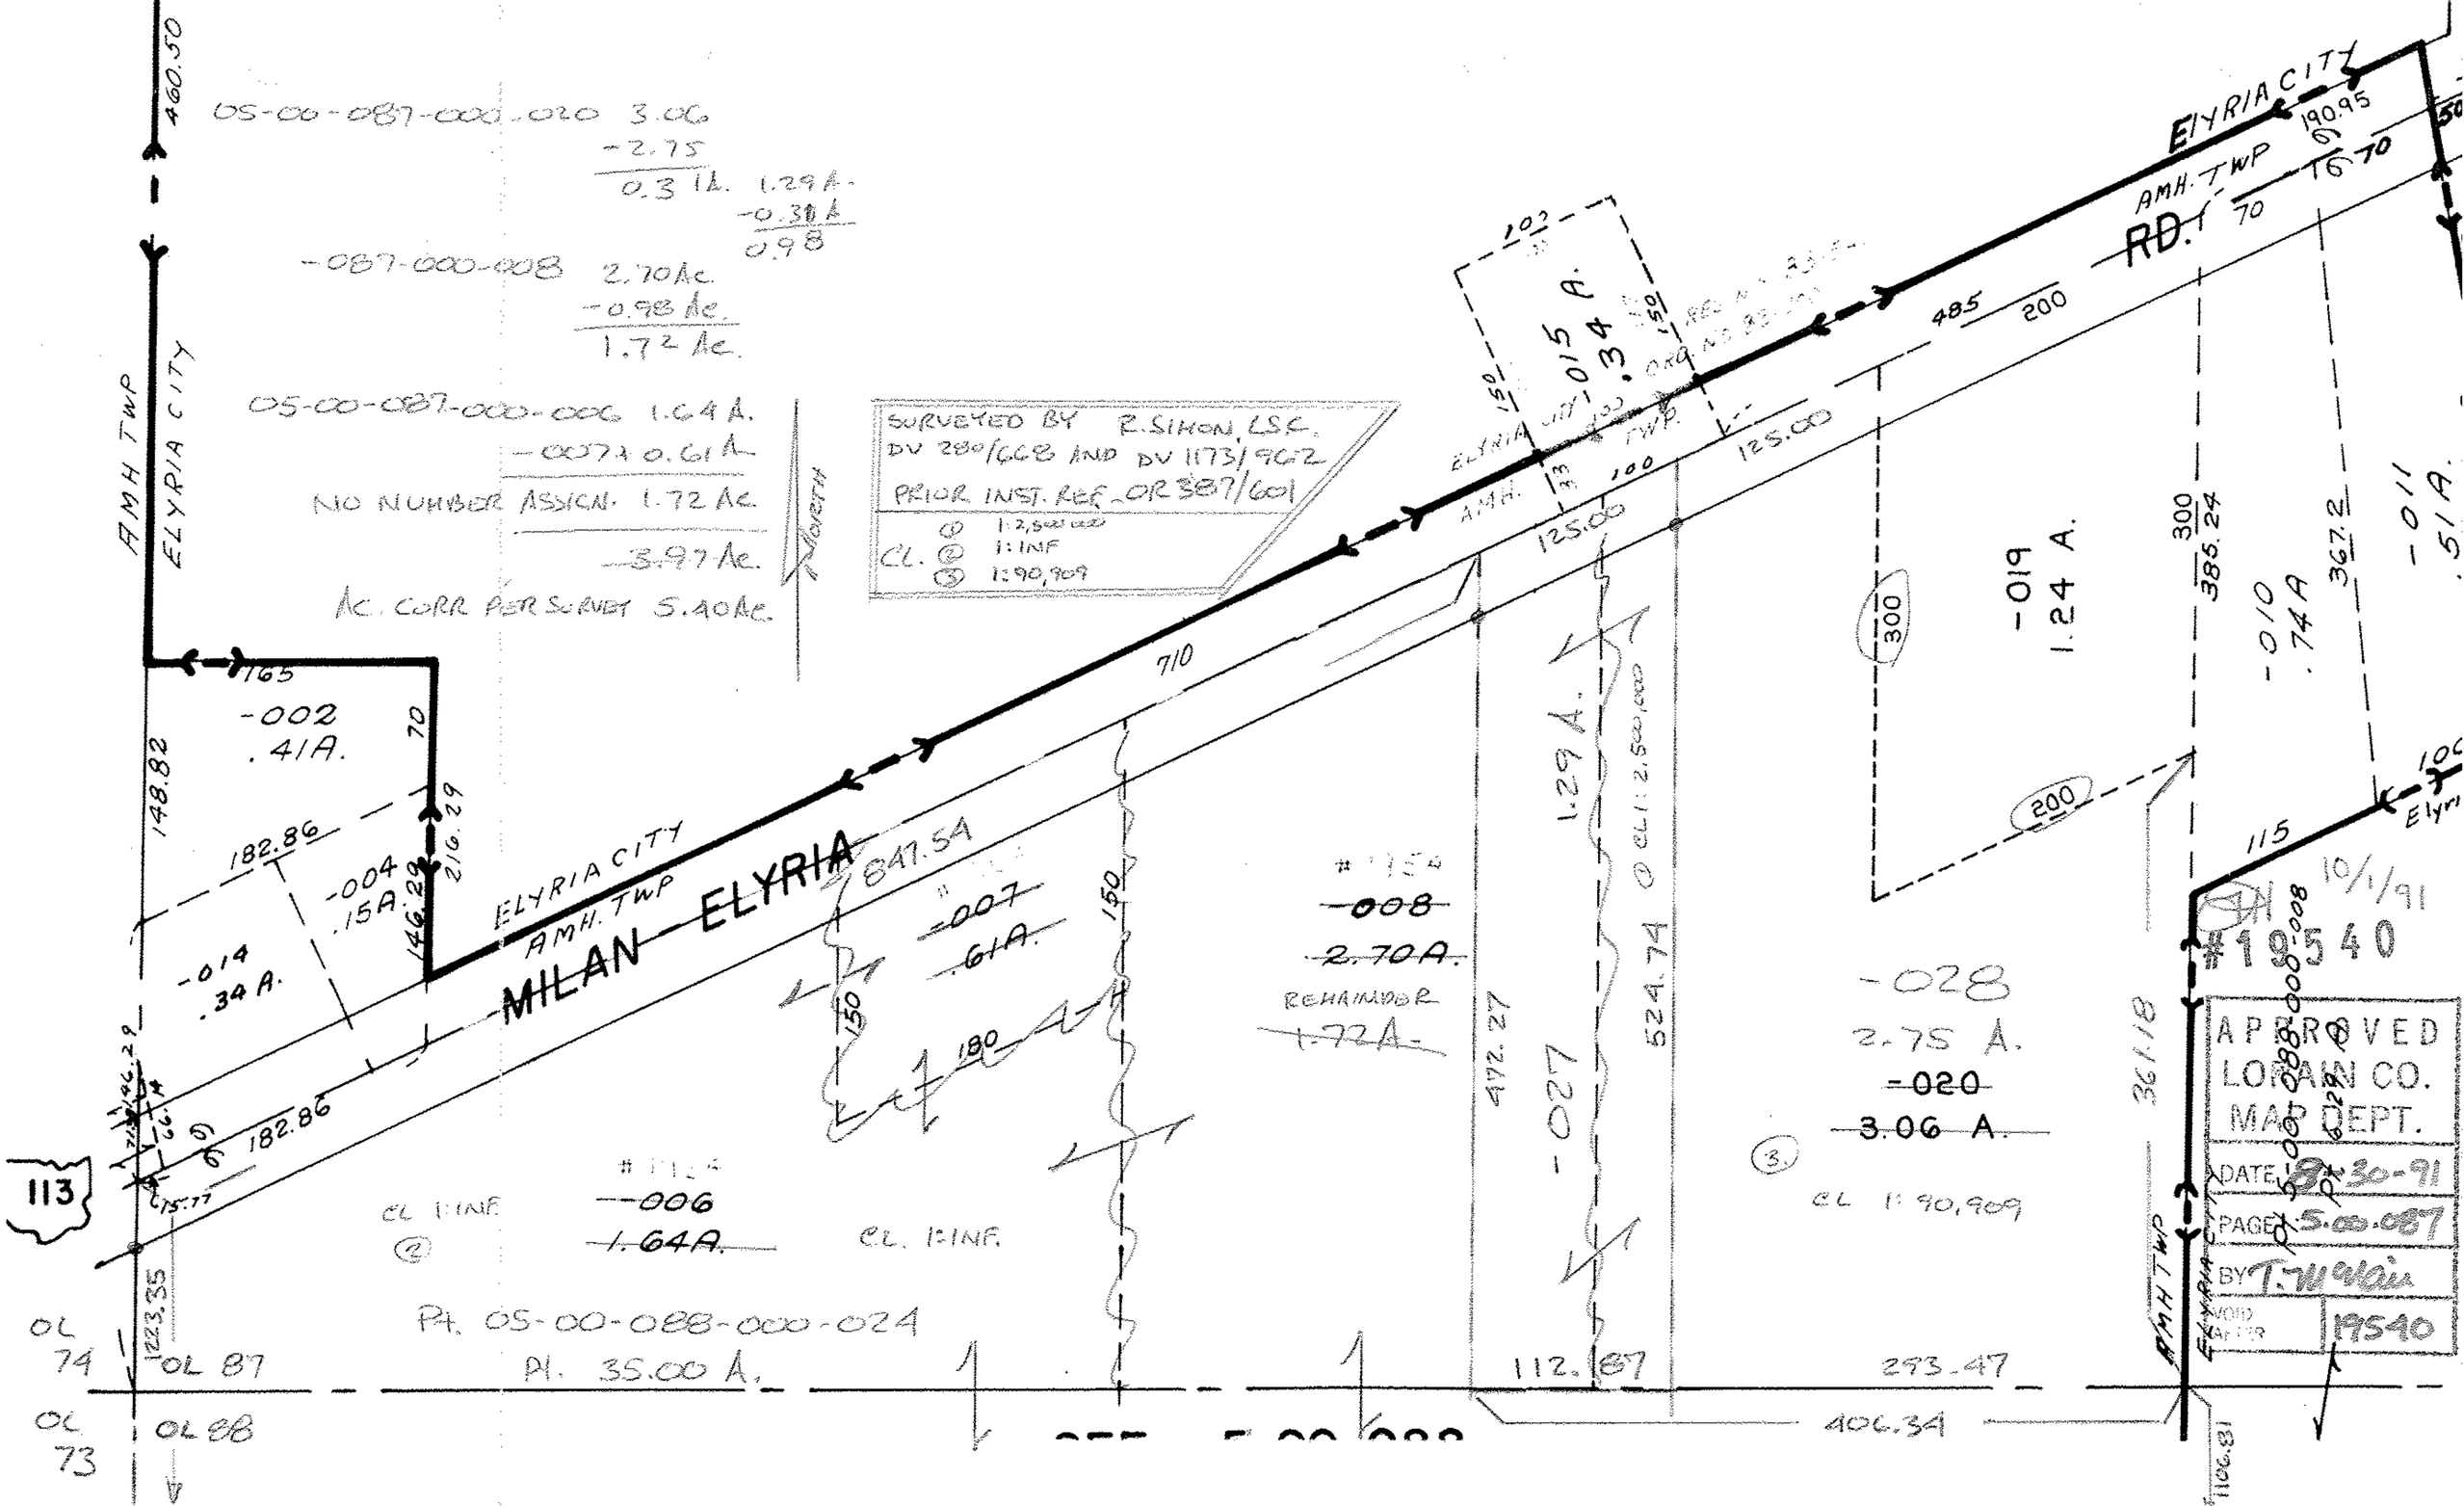

05-00-087-000-020 3.06
-2.75
0.31A. 1.29A.
-0.31A
0.98
-087-000-008 2.70Ac.
-0.98 Ac.
1.72 Ac.
05-00-087-000-006 1.64 A.
-007 + 0.61 A.
NO NUMBER ASSIGN. 1.72 Ac.
3.97 Ac.
AC. CORR PER SURVEY 5.40Ac.
SURVEYED BY R. SIMON, LSC.
DV 280/668 AND DV 1173/962
PRIOR INST. REF. OR 387/601
CL. ① 1:2,500,000
② 1:INF
③ 1:90,909
AMH TWP
ELYRIA CITY
MILAN - ELYRIA
ELYRIA CITY
AMH. TWP
RD.
-002
.41A.
-004
.15A.
-014
.34 A.
-007
.61A.
-008
2.70A.
REMAINDER
1.72A.
-006
1.64A.
CL 1:INF.
CL. 1:INF.
-015
.34 A.
-019
1.24 A.
-010
.74 A
-011
.51 A.
-028
2.75 A.
-020
3.06 A.
CL 1:90,909
-027
1.29 A.
Pt. 05-00-088-000-024
Pt. 35.00 A.
OL 74
OL 87
OL 73
OL 88
113
#19540
10/1/91
APPROVED
LORAIN CO.
MAP DEPT.
DATE 8-30-91
PAGE 5.00.087
BY T. McVain
VOID AFTER 19540