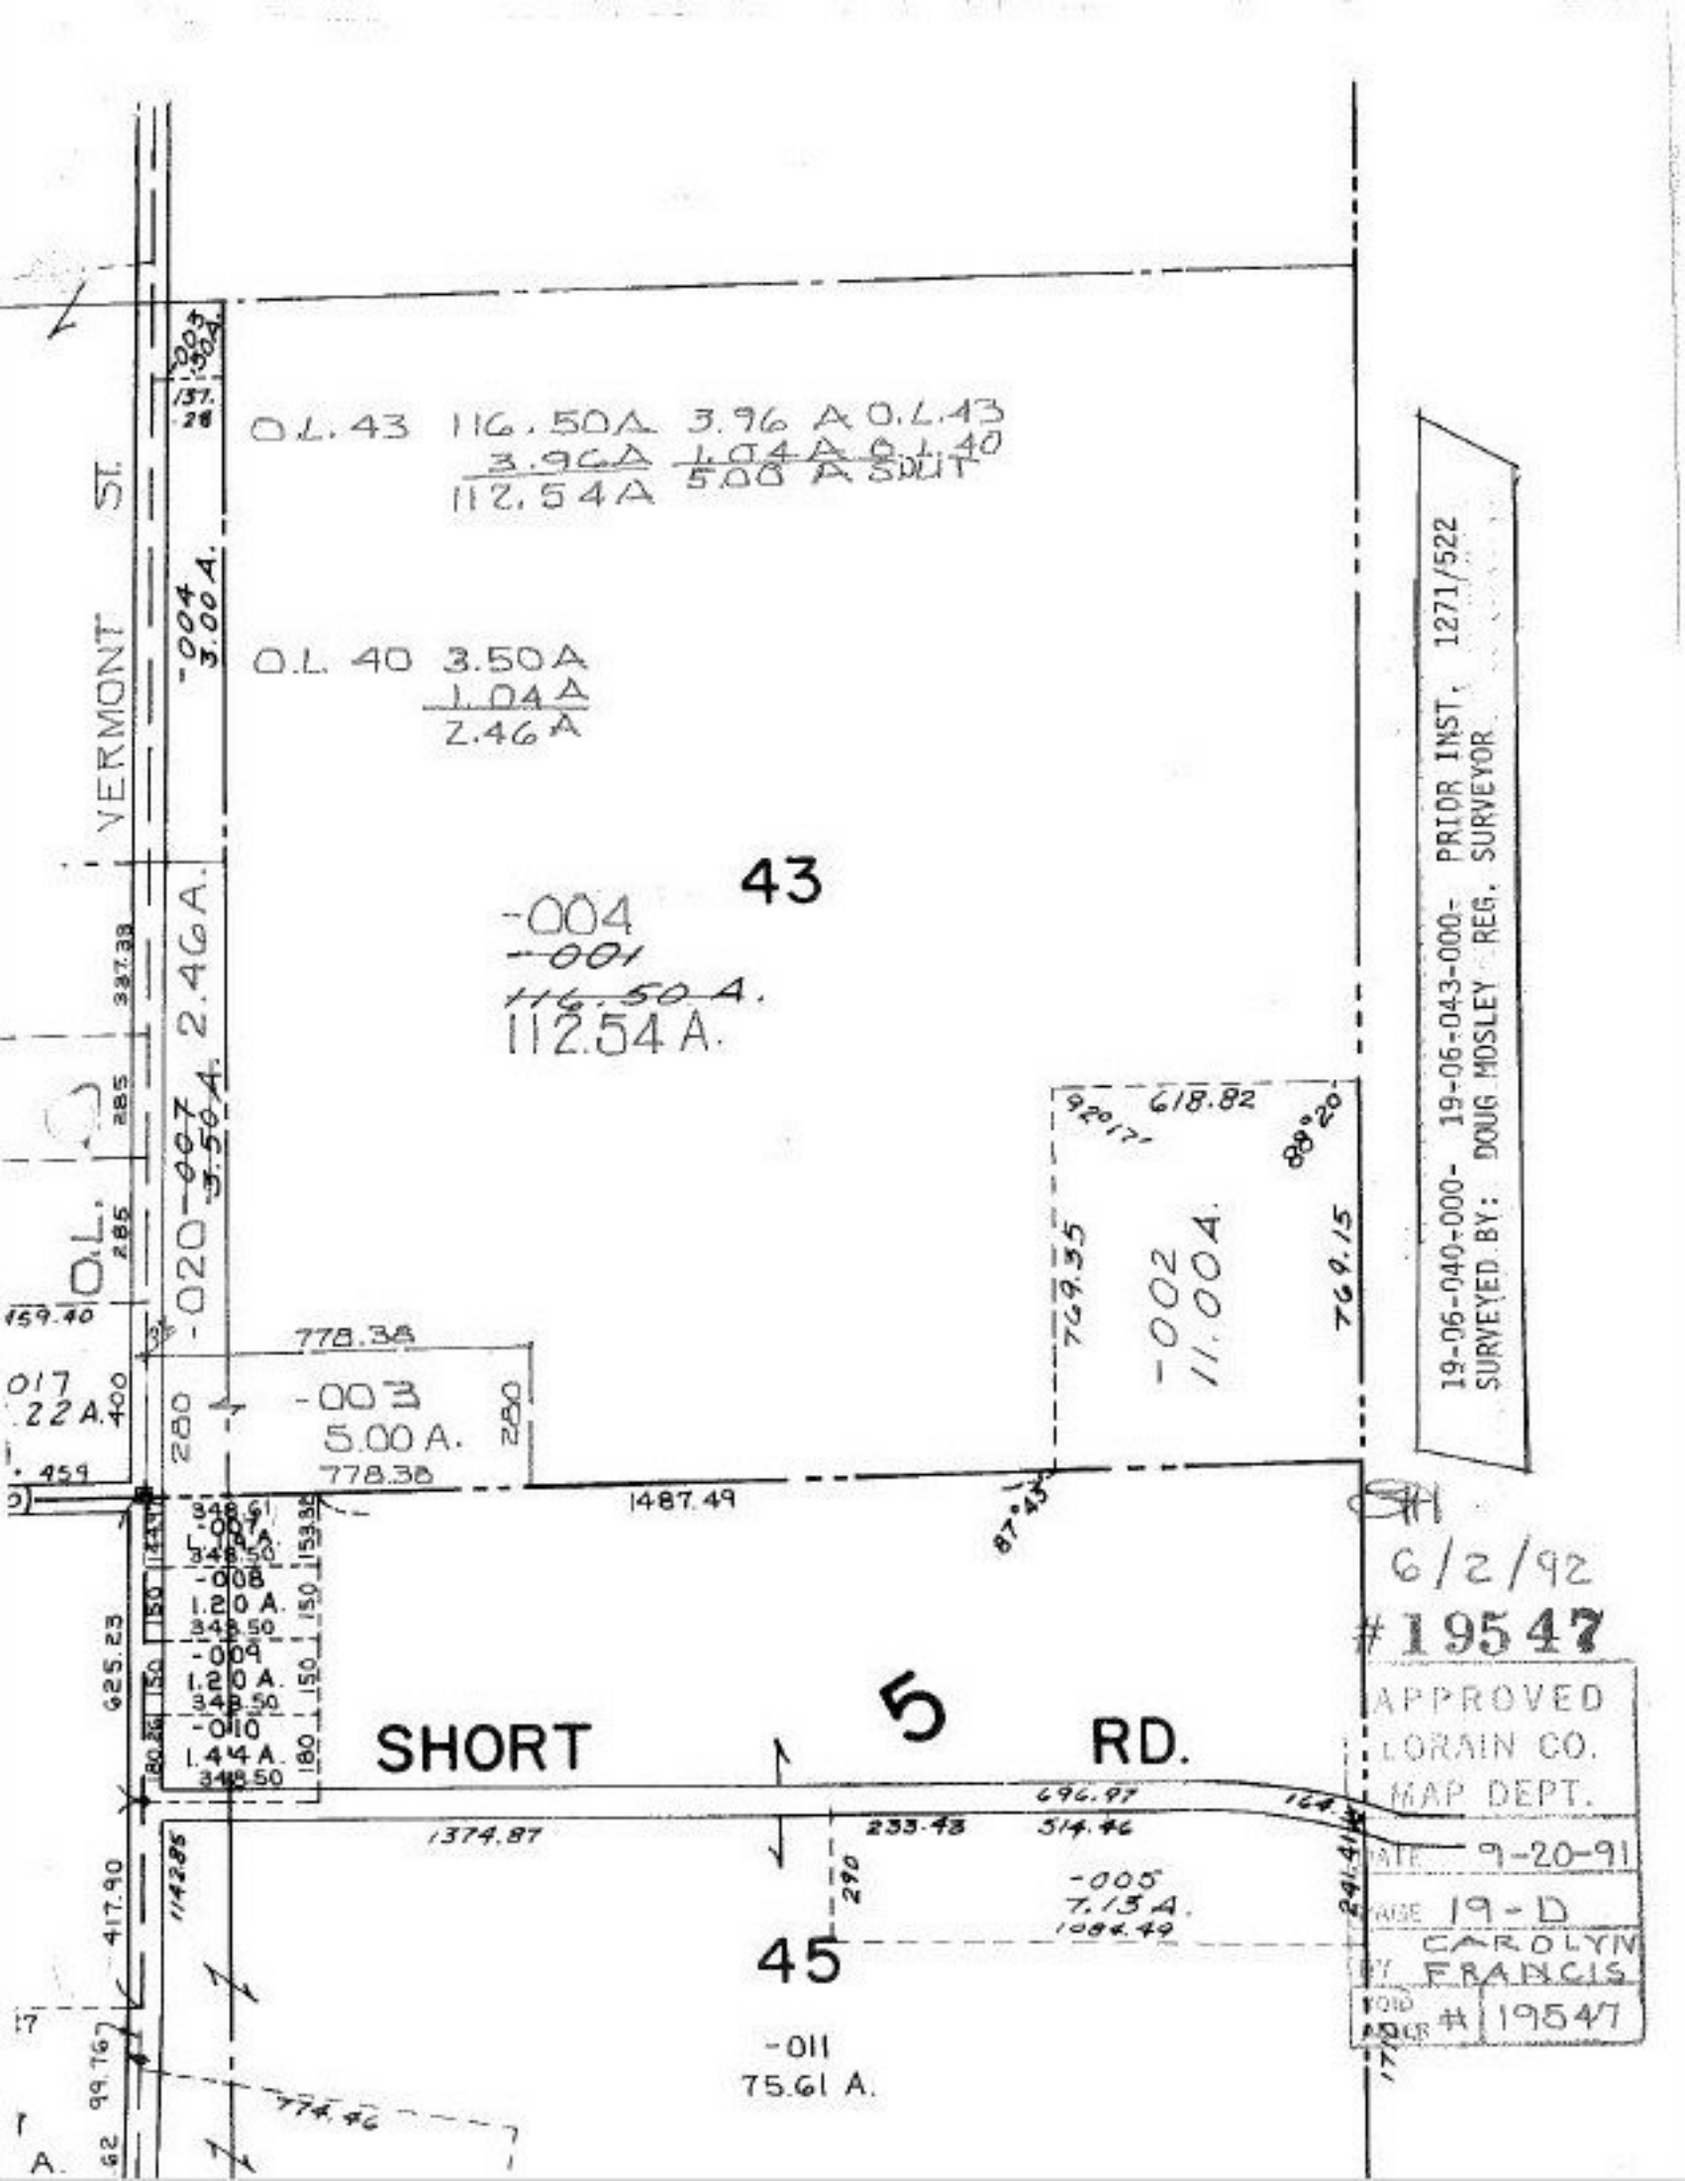
O.L. 43 116.50A 3.96 A O.L.43
3.96A 1.04 A O.L.40
112.54A 5.00 A SPLIT
O.L. 40 3.50A
1.04A
2.46A
VERMONT ST.
-004 3.00A.
-020 -007 3.50A. 2.46A.
43
-004
-001
116.50A.
112.54A.
-002
11.004.
-003
5.00A.
778.38
280
1487.49
618.82
769.35
769.15
88°20'
87°43'
19-06-040-000- 19-06-043-000- PRIOR INST. 1271/522
SURVEYED BY: DOUG MOSLEY REG. SURVEYOR
6/2/92
#19547
APPROVED
LORAIN CO.
MAP DEPT.
DATE 9-20-91
PAGE 19-D
BY CAROLYN FRANCIS
FOLD MAPS # 19547
SHORT 5 RD.
-008 1.20A.
-009 1.20A.
-010 1.44A.
625.23
417.90
1374.87
233.48
514.46
696.97
-005 7.13A. 1084.49
45
-011
75.61 A.
774.46