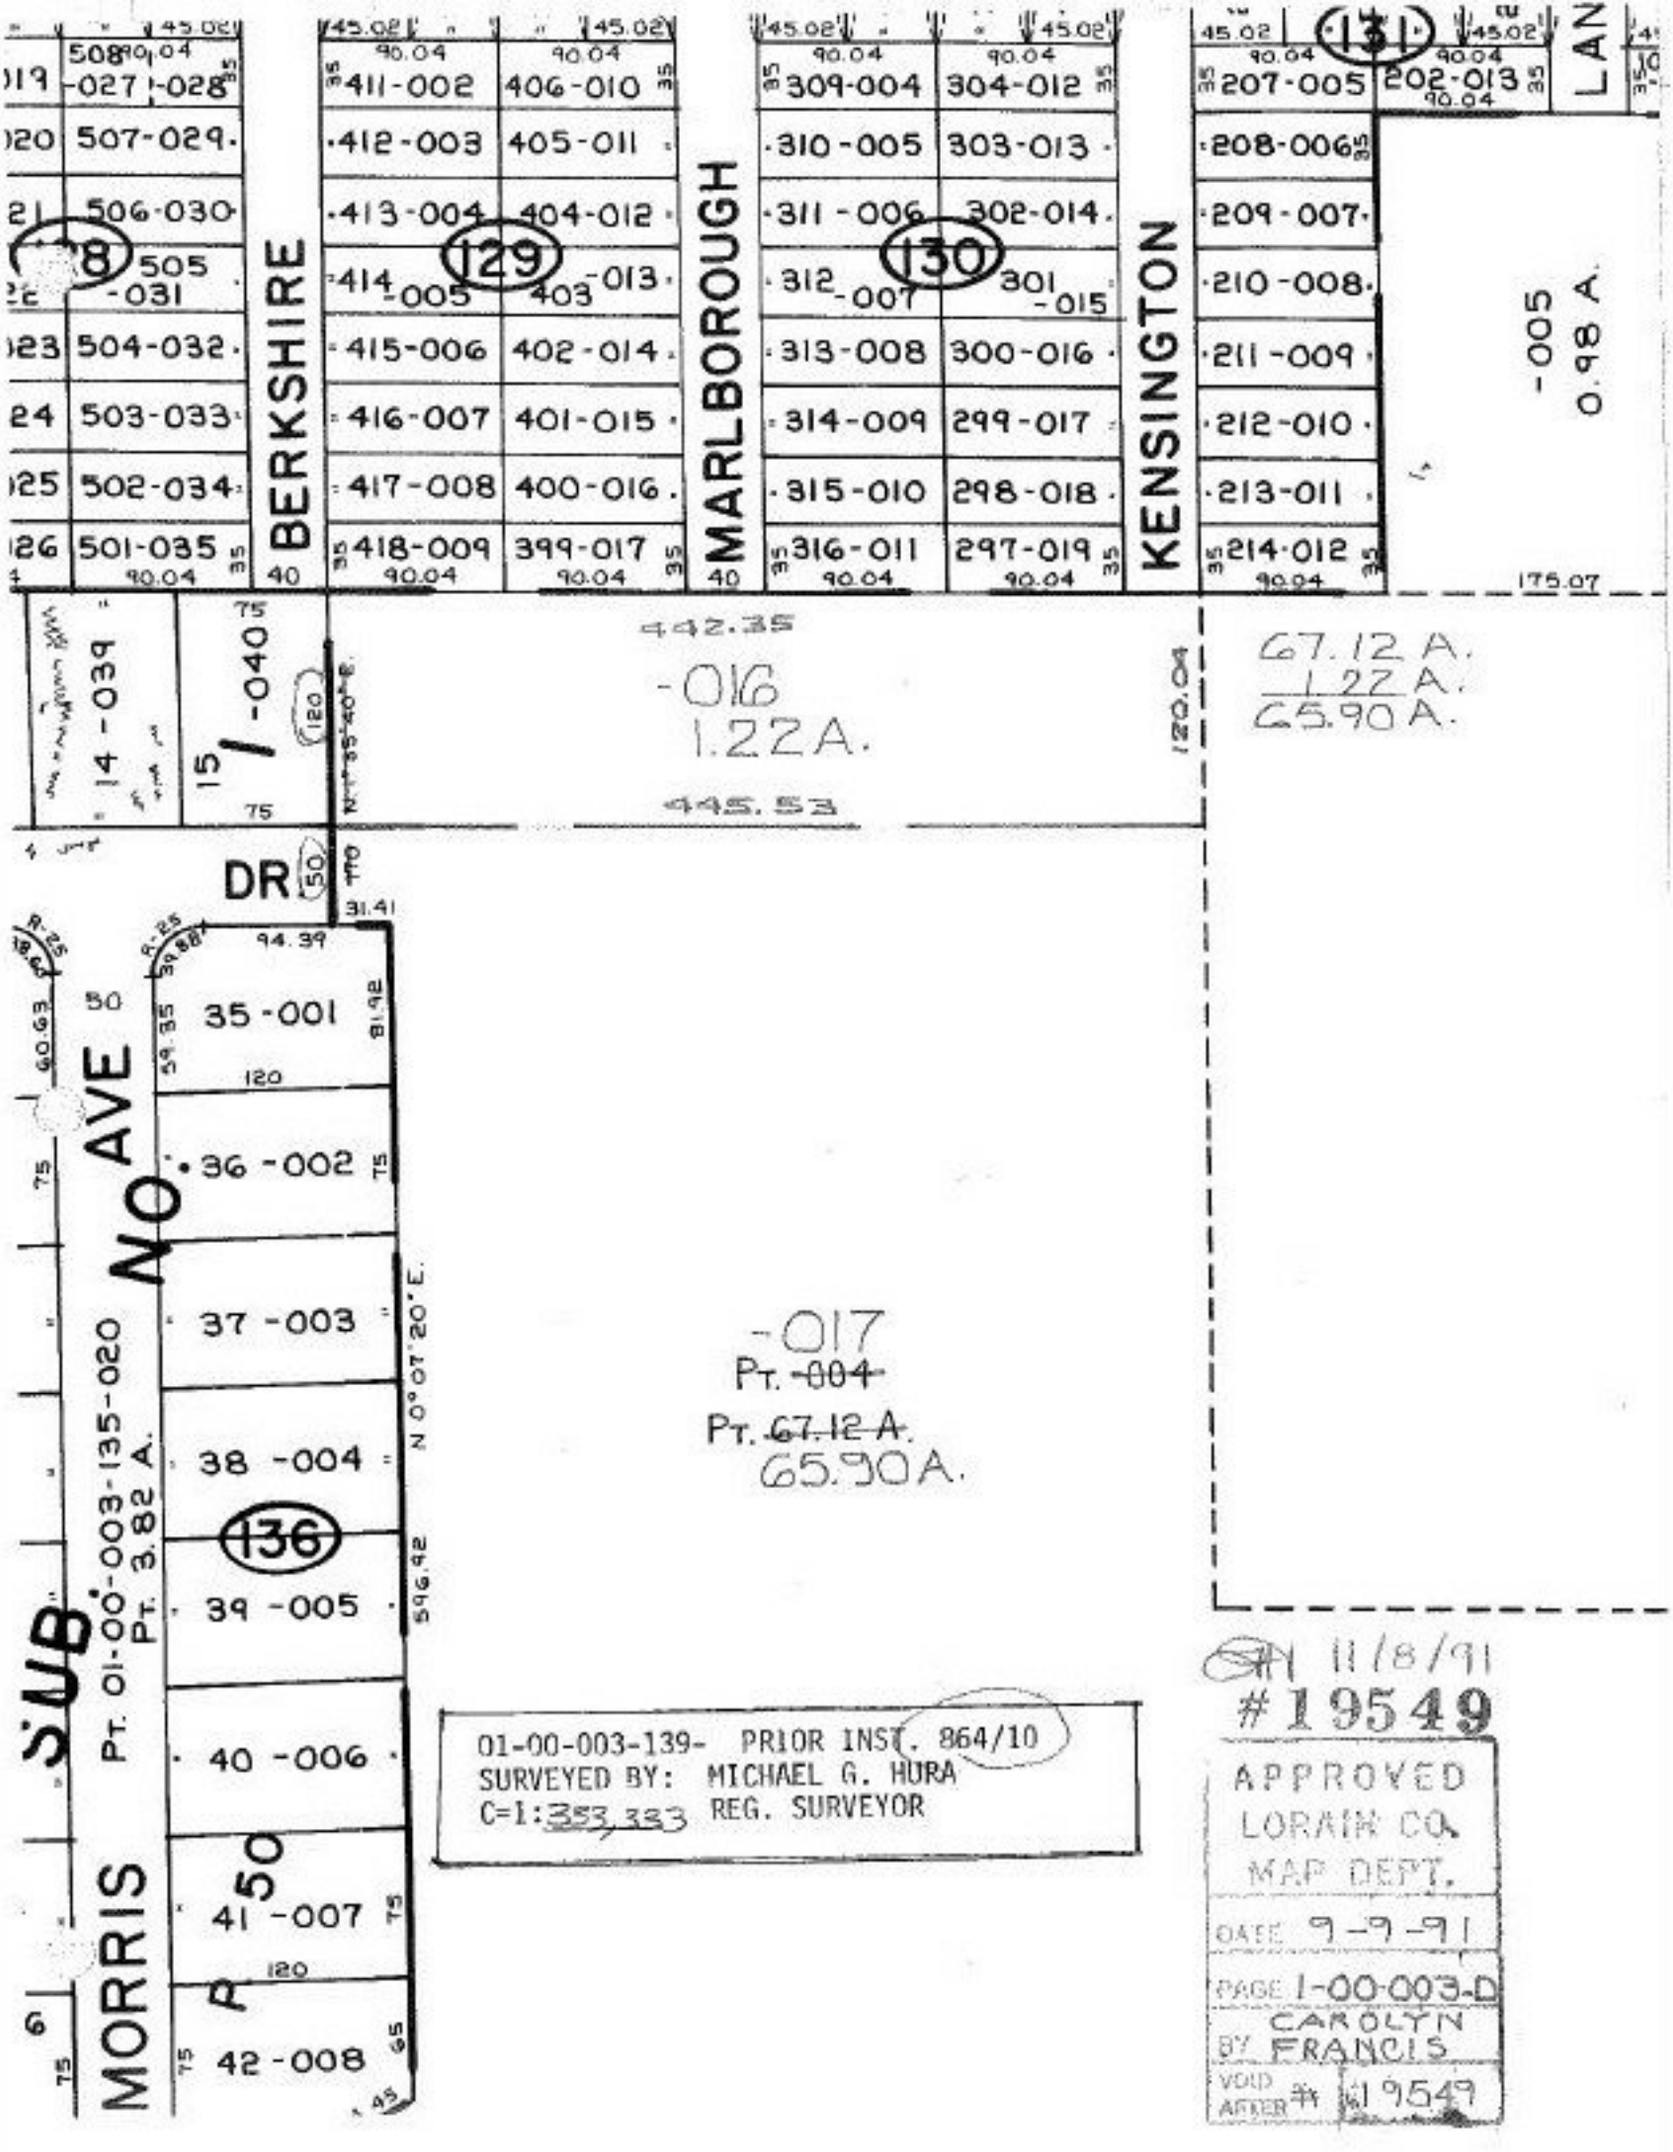
BERKSHIRE
MARLBOROUGH
KENSINGTON
LAN
DR
AVE
NO
SUB
MORRIS
128
129
130
131
136
508-027
-028
507-029
506-030
505-031
504-032
503-033
502-034
501-035
411-002
412-003
413-004
414-005
415-006
416-007
417-008
418-009
406-010
405-011
404-012
403-013
402-014
401-015
400-016
399-017
309-004
310-005
311-006
312-007
313-008
314-009
315-010
316-011
304-012
303-013
302-014
301-015
300-016
299-017
298-018
297-019
207-005
208-006
209-007
210-008
211-009
212-010
213-011
214-012
202-013
-005
0.98 A.
175.07
14-039
15
1-040
120
N 35°40'E
442.35
-016
1.22A.
445.53
120.04
67.12 A.
1.22 A.
65.90 A.
-017
Pt. -004
Pt. 67.12 A.
65.90A.
35-001
36-002
37-003
38-004
39-005
40-006
41-007
42-008
94.39
81.92
59.35
120
75
596.92
N 0°07'20"E
Pt. 01-00-003-135-020
Pt. 3.82 A.
01-00-003-139- PRIOR INST. 864/10
SURVEYED BY: MICHAEL G. HURA
C=1: 353,333 REG. SURVEYOR
11/8/91
#19549
APPROVED
LORAIN CO.
MAP DEPT.
DATE 9-9-91
PAGE 1-00-003-D
CAROLYN
BY FRANCIS
VOID
AFTER # 19549