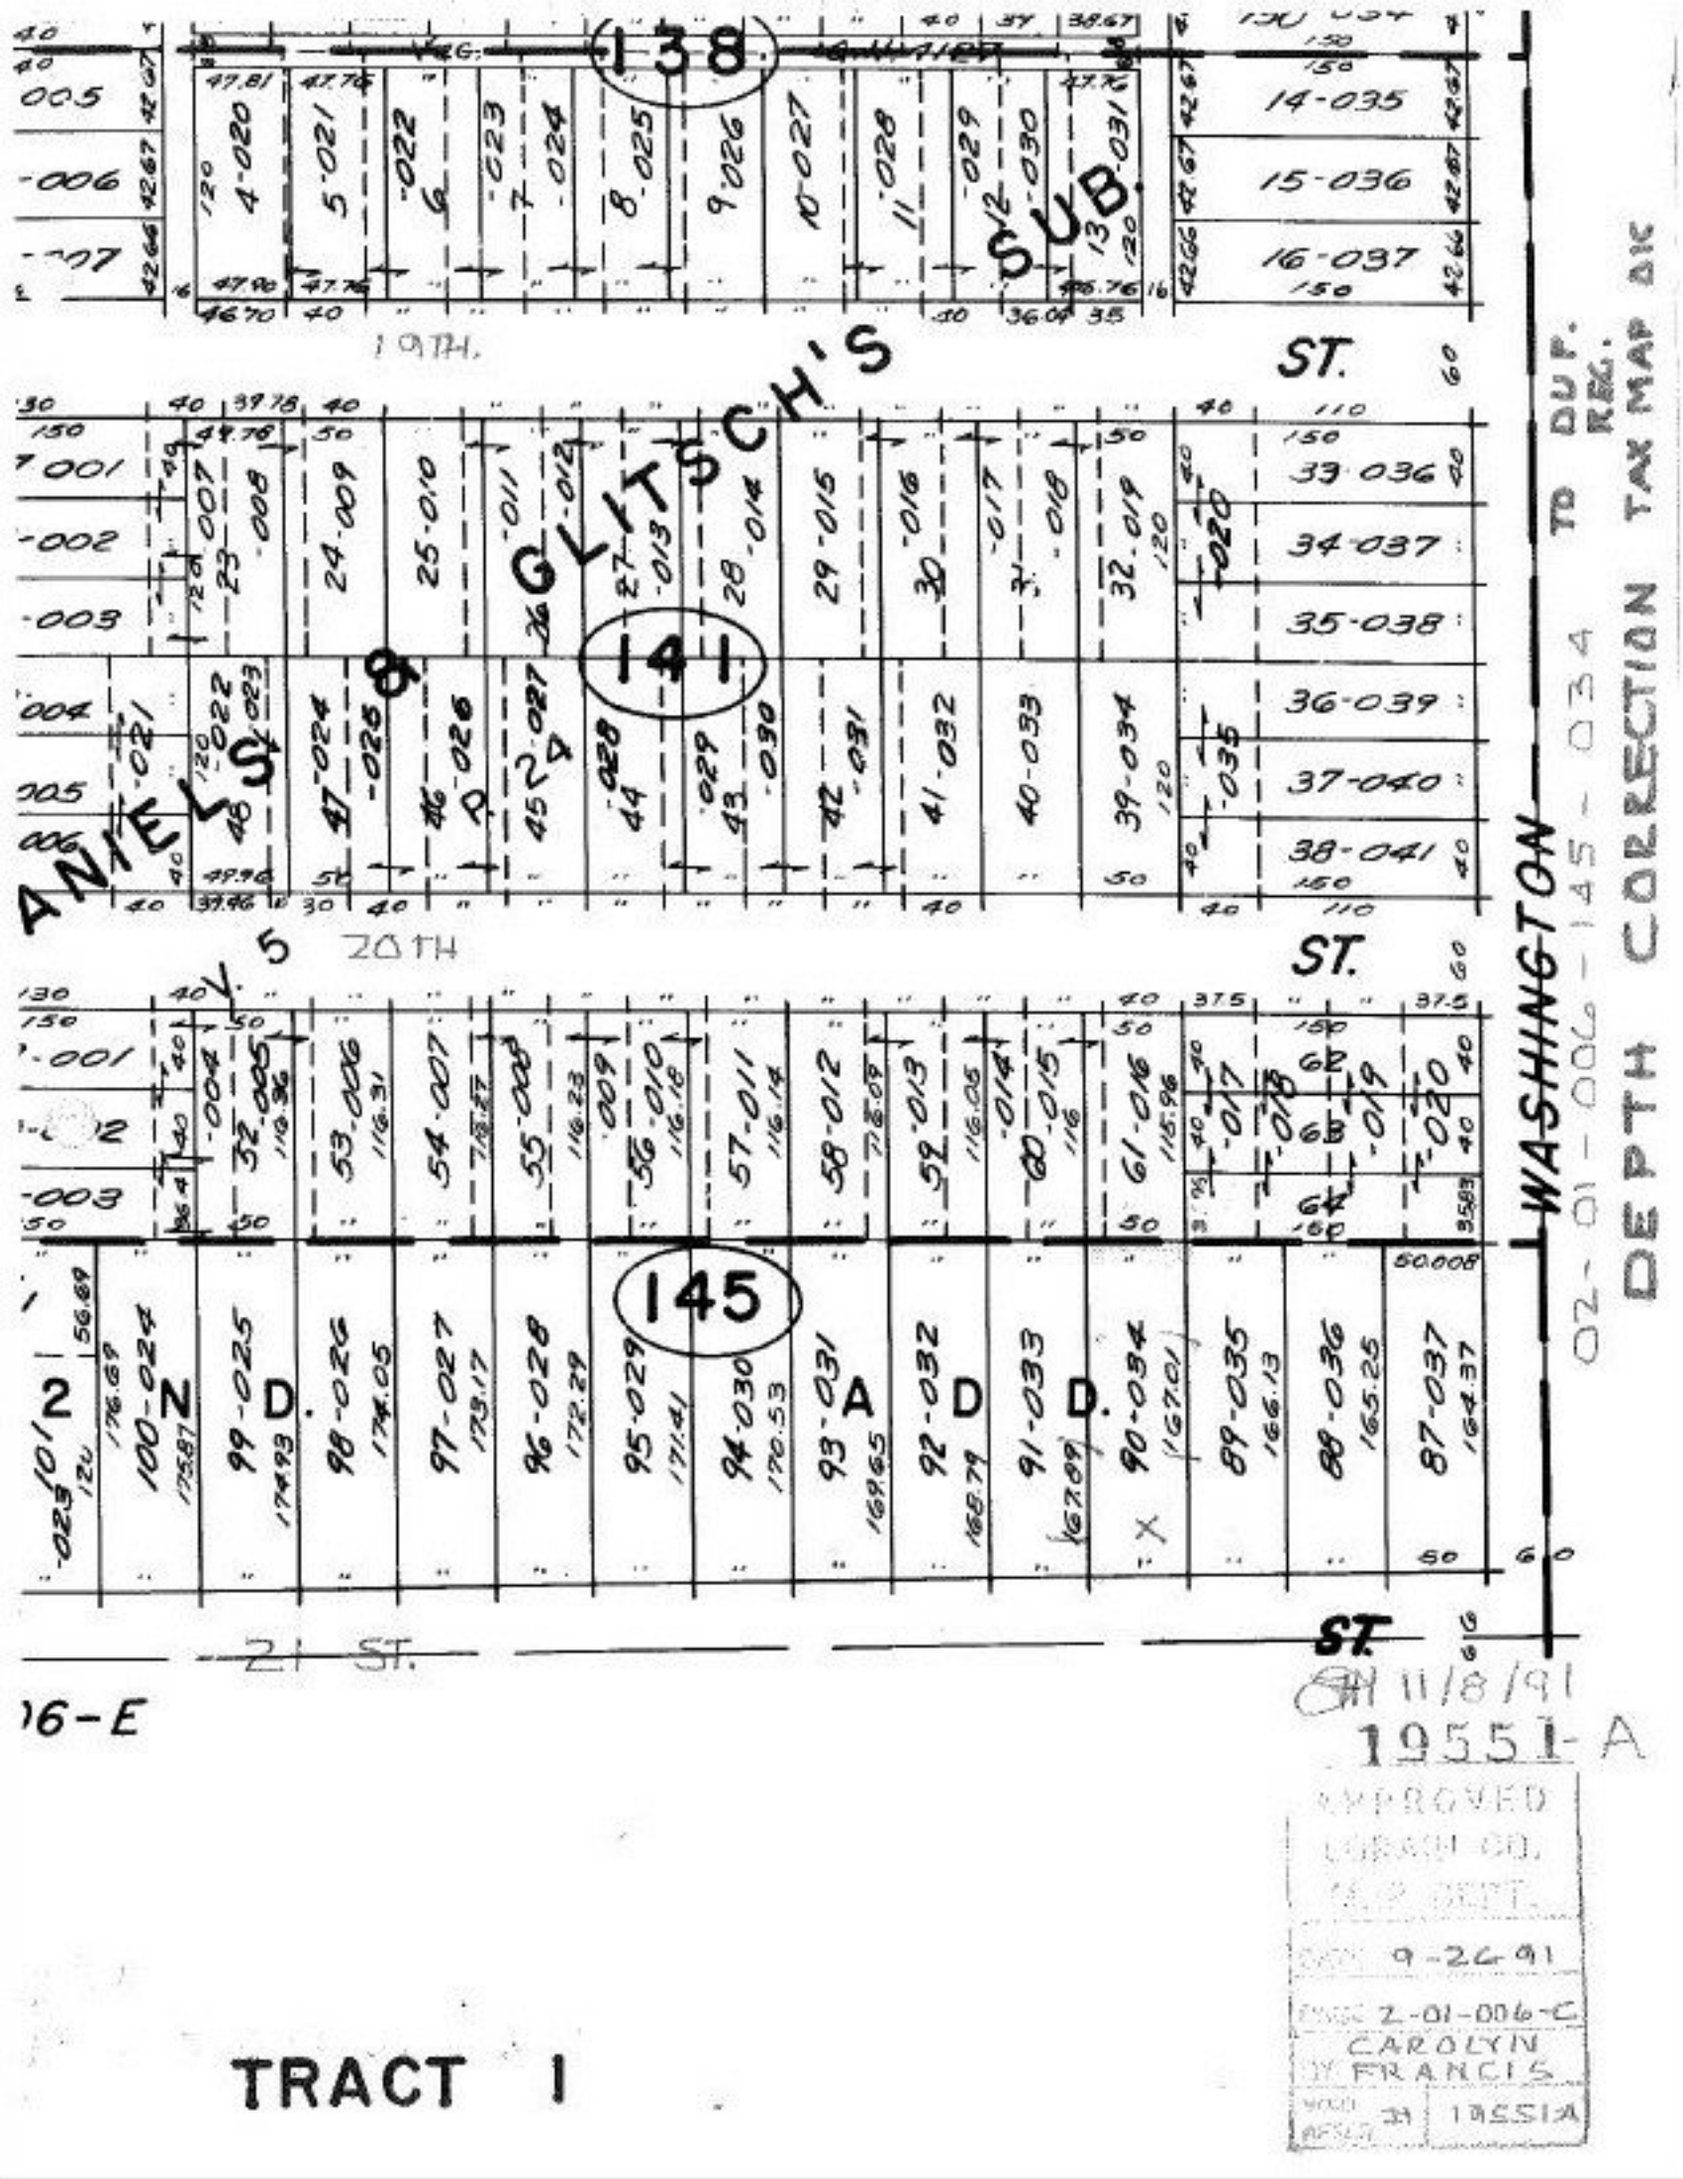
138
145
19TH.
ST.
S 20TH
ST.
21 ST.
WASHINGTON
TD DUF.
REG.
02-01-006-145-034
DEPTH CORRECTION TAX MAP DIC
16-E
11/8/91
19551-A
TRACT 1
APPROVED
DATE 9-24-91
PARCEL 2-01-006-C
CAROLYN
BY FRANCIS