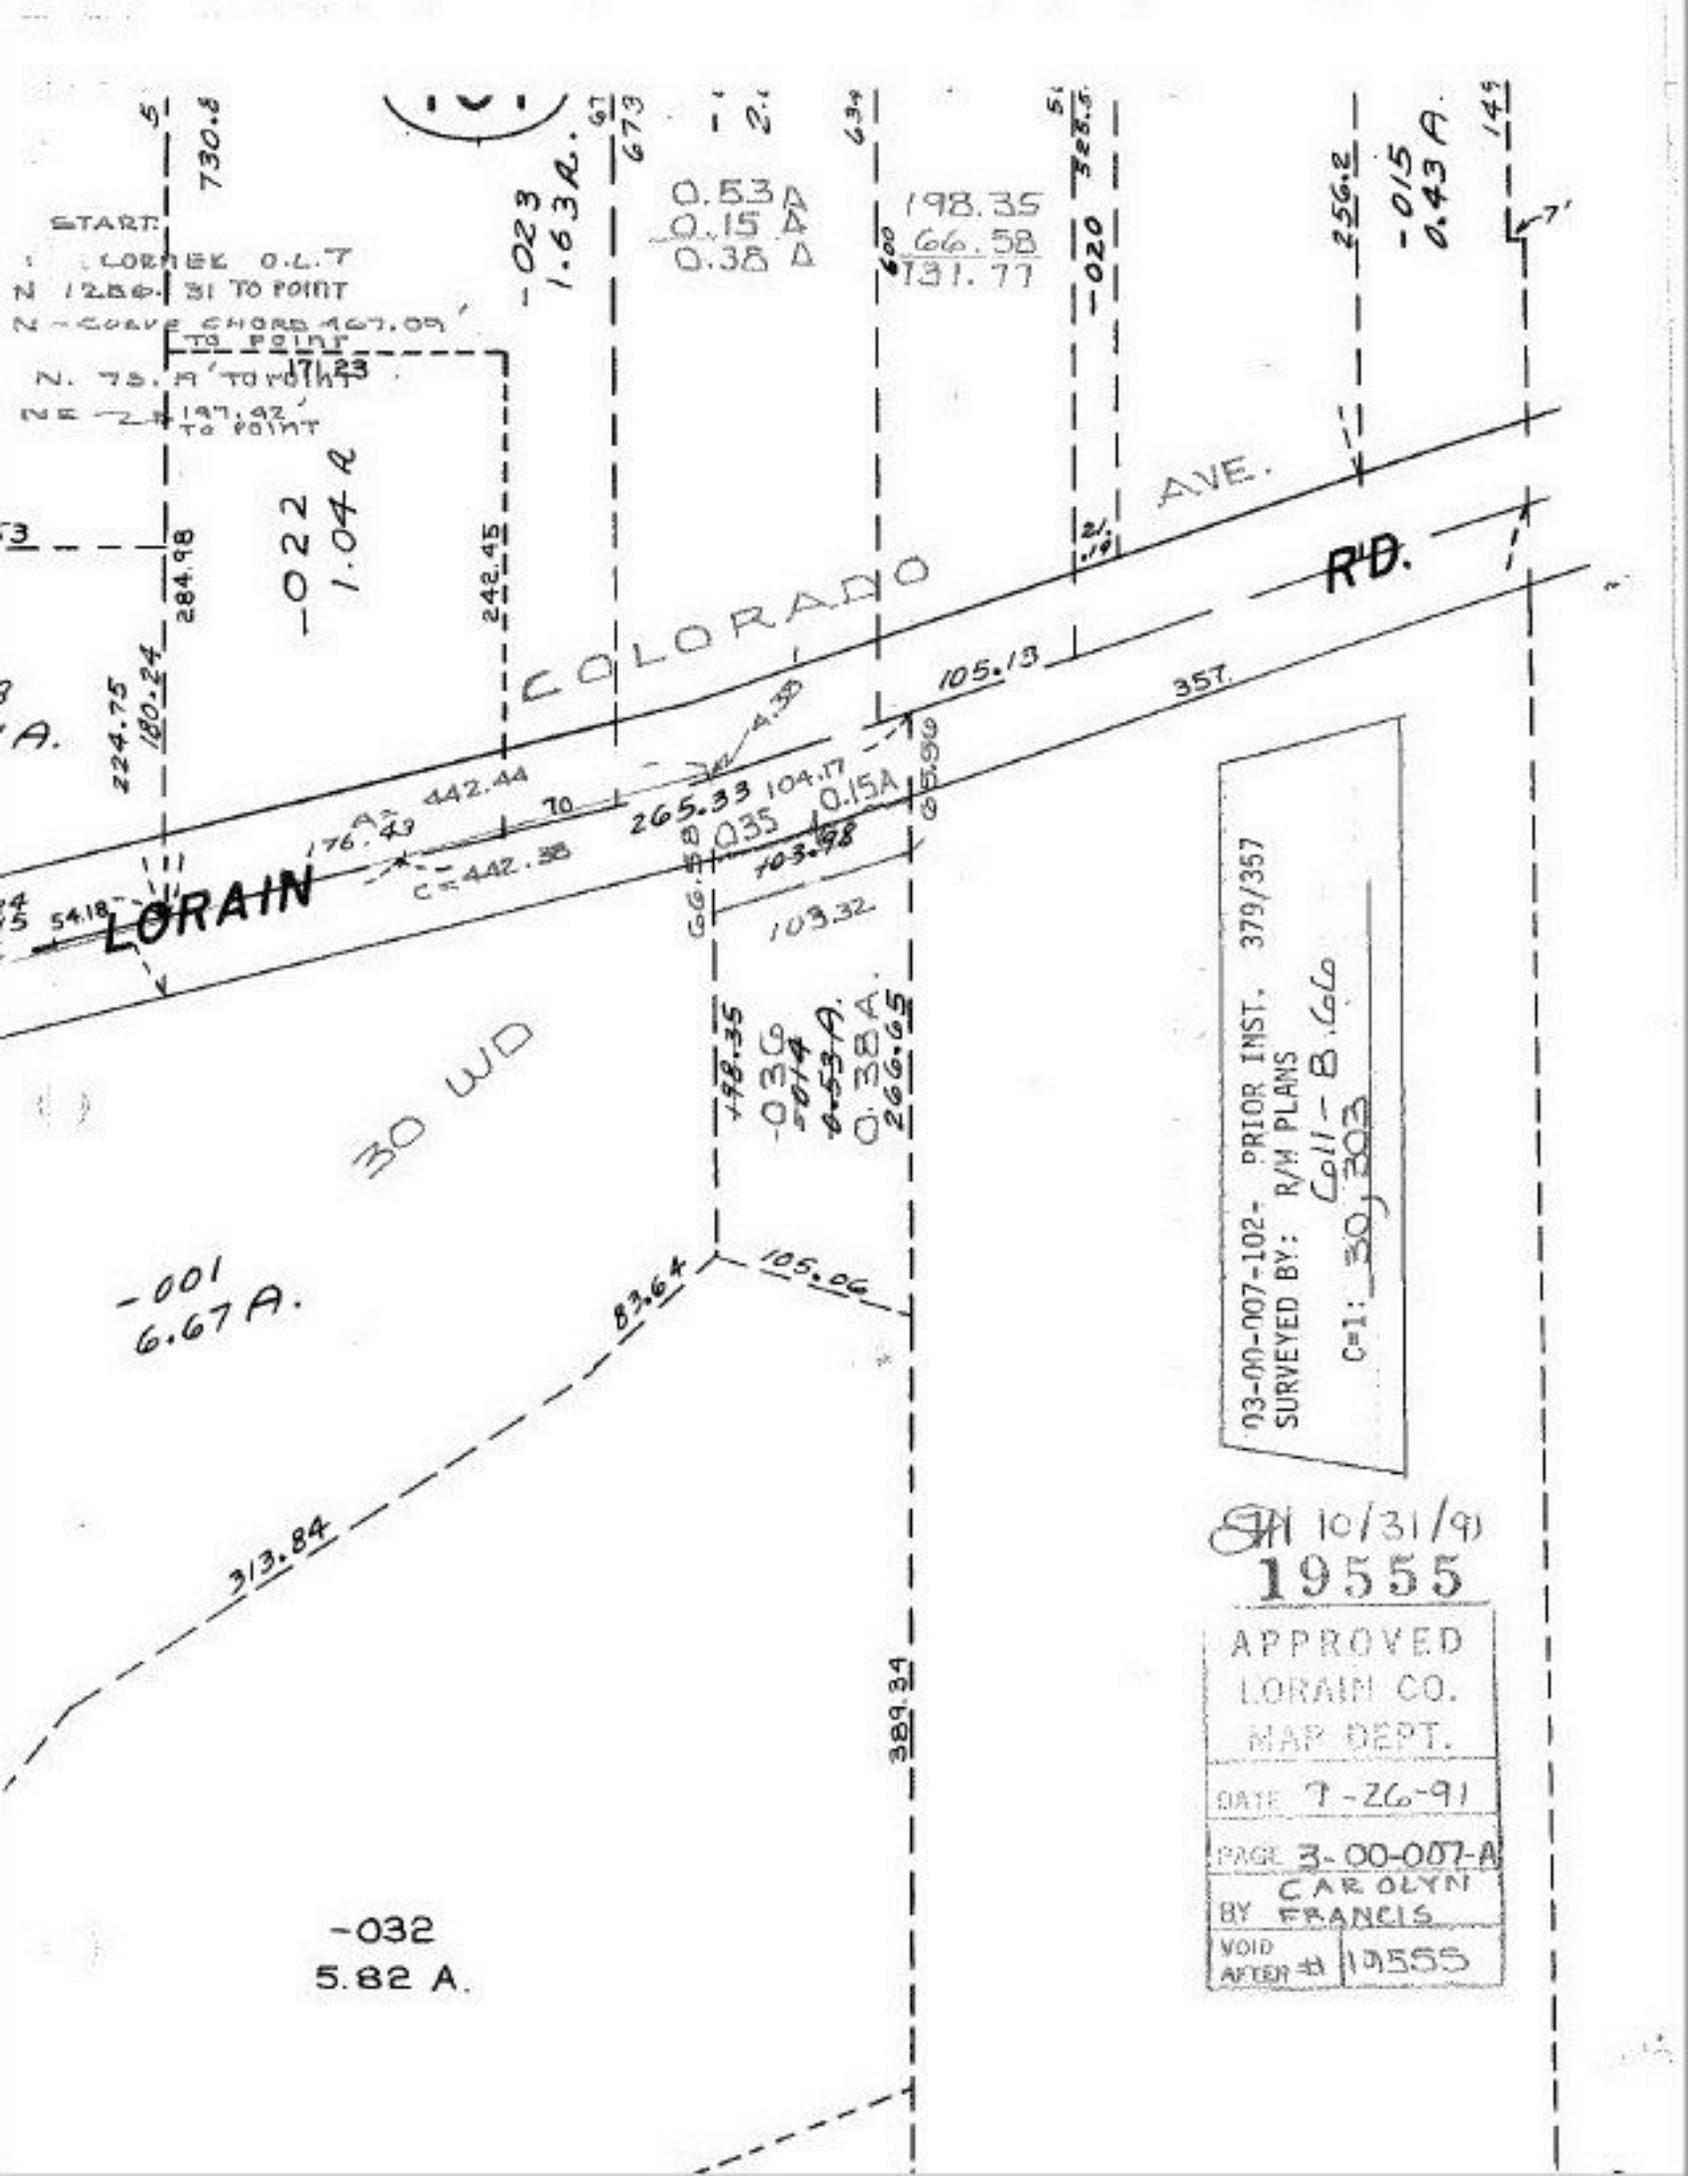
START:
LORMEK O.L.T
N 1286.31 TO POINT
N - CURVE CHORD 467.09' TO POINT
N. 75.19' TO POINT
NE - 197.92' TO POINT
-023
1.63 A.
0.53 A
0.15 A
0.38 A
198.35
66.58
131.77
-020
-015
0.43 A.
-022
1.04 A
COLORADO AVE.
R'D.
LORAIN
105.13
357
442.44
265.33
104.17
0.15A
103.98
103.32
C=442.38
30 WD
-036
0.38A.
266.65
-001
6.67 A.
105.06
83.64
313.84
389.34
-032
5.82 A.
03-00-007-102- PRIOR INST. 379/357
SURVEYED BY: R/W PLANS
Coll - B.Co
C=1: 30,303
10/31/91
19555
APPROVED
LORAIN CO.
MAP DEPT.
DATE 7-26-91
PAGE 3-00-007-A
BY CAROLYN FRANCIS
VOID AFTER # 19555