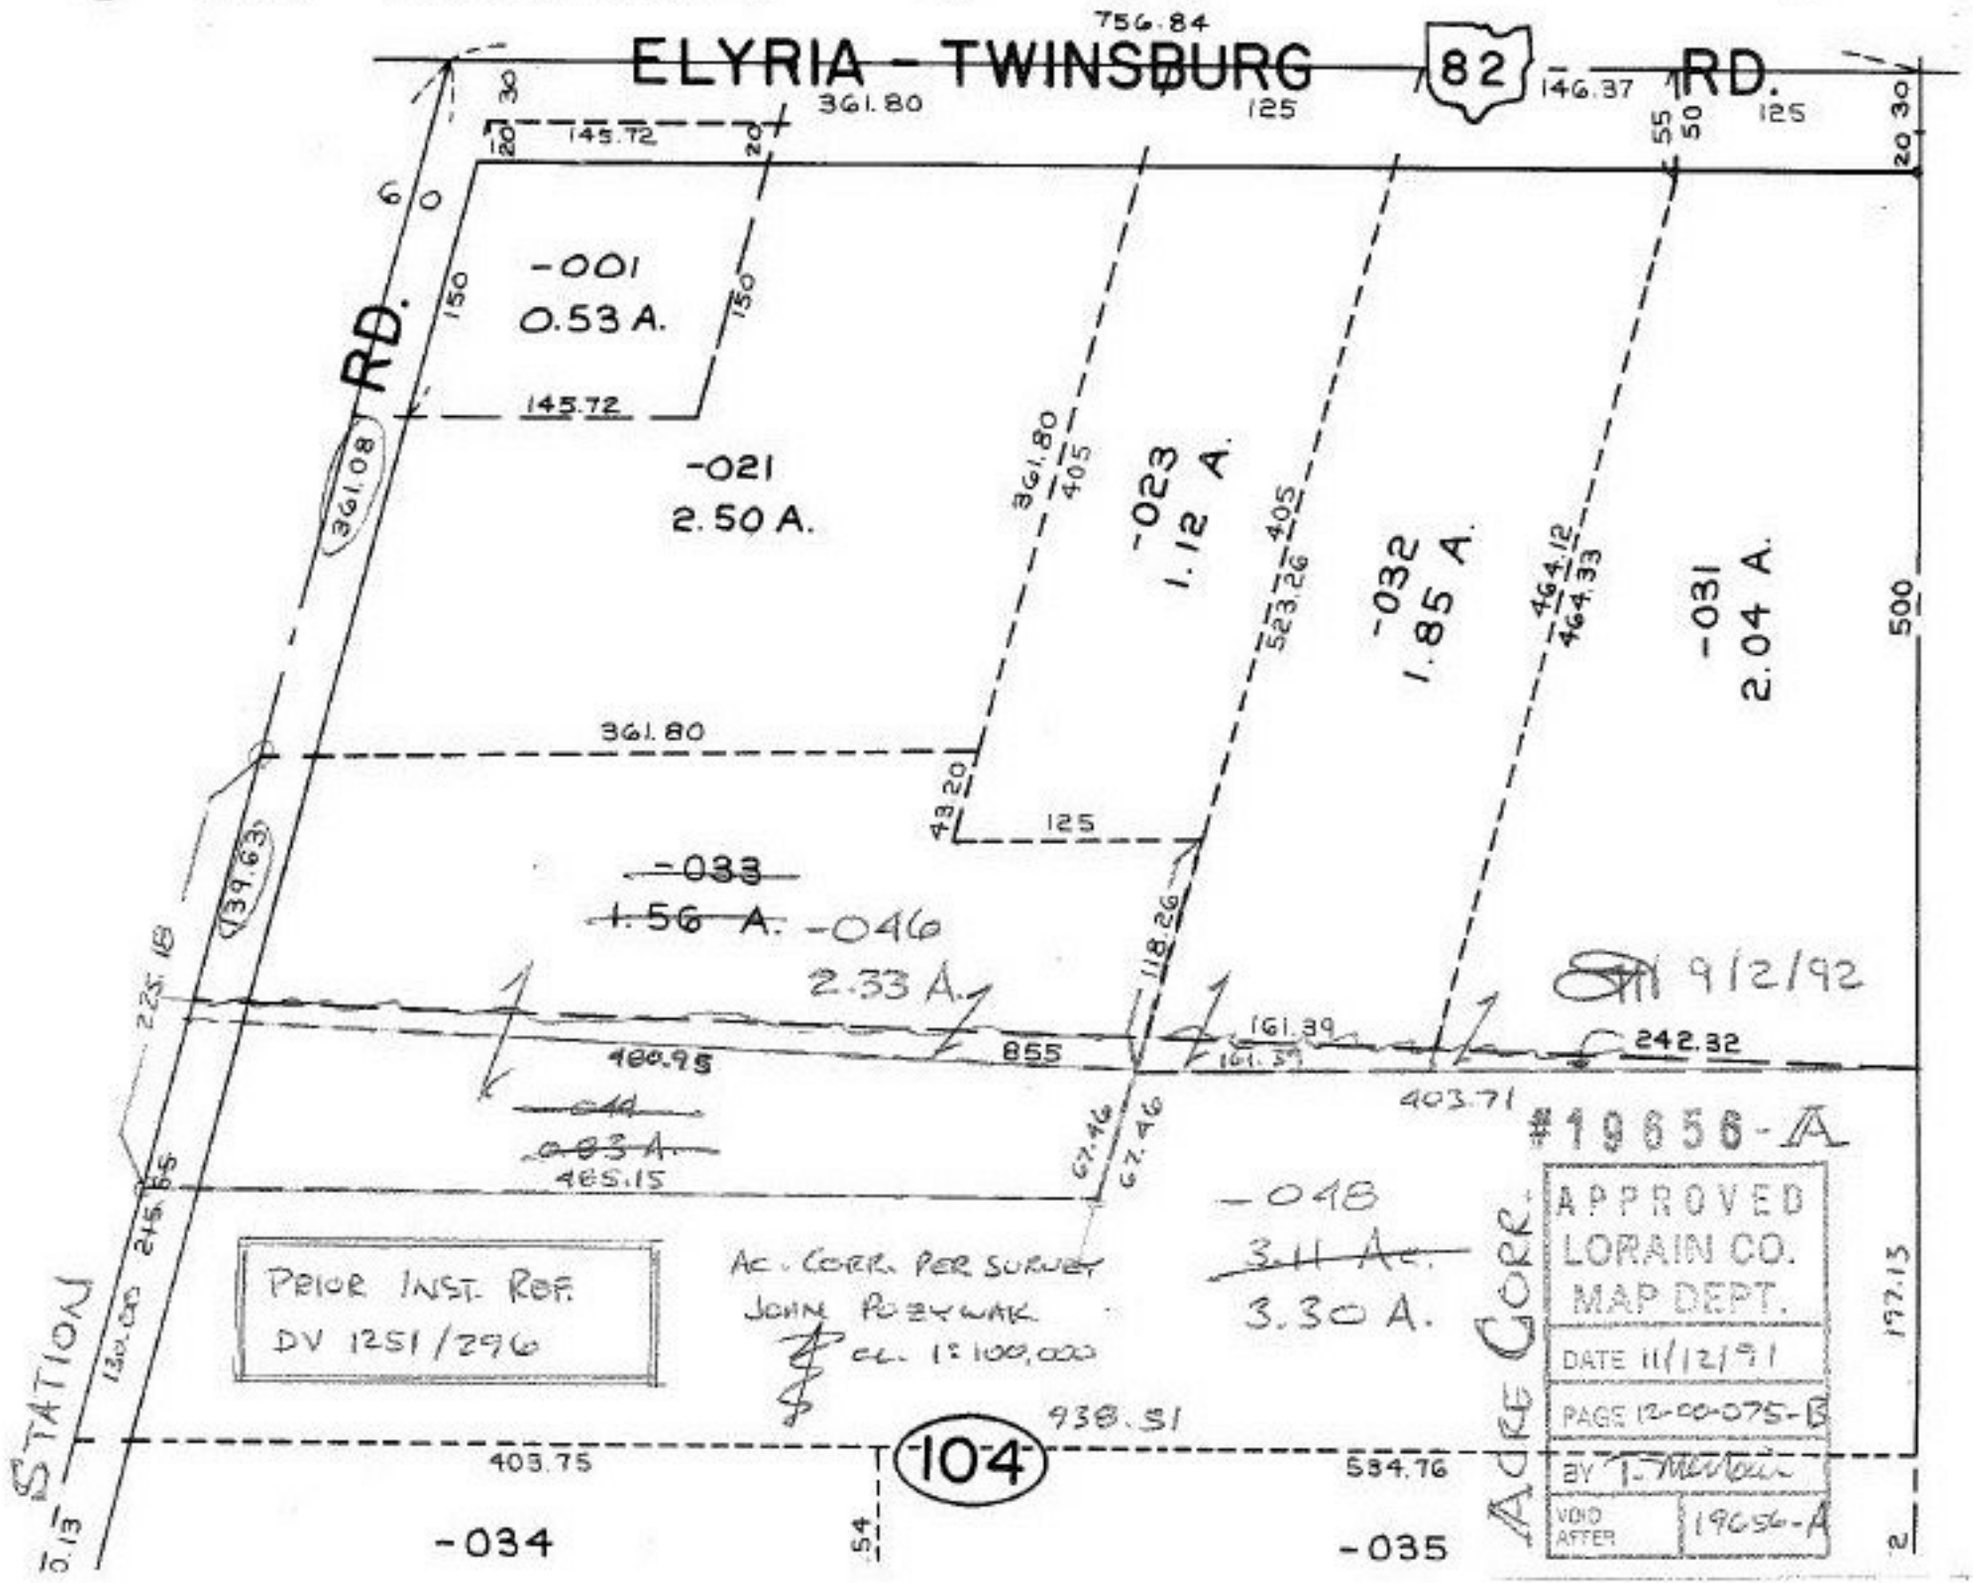SEE 12-00-076-B