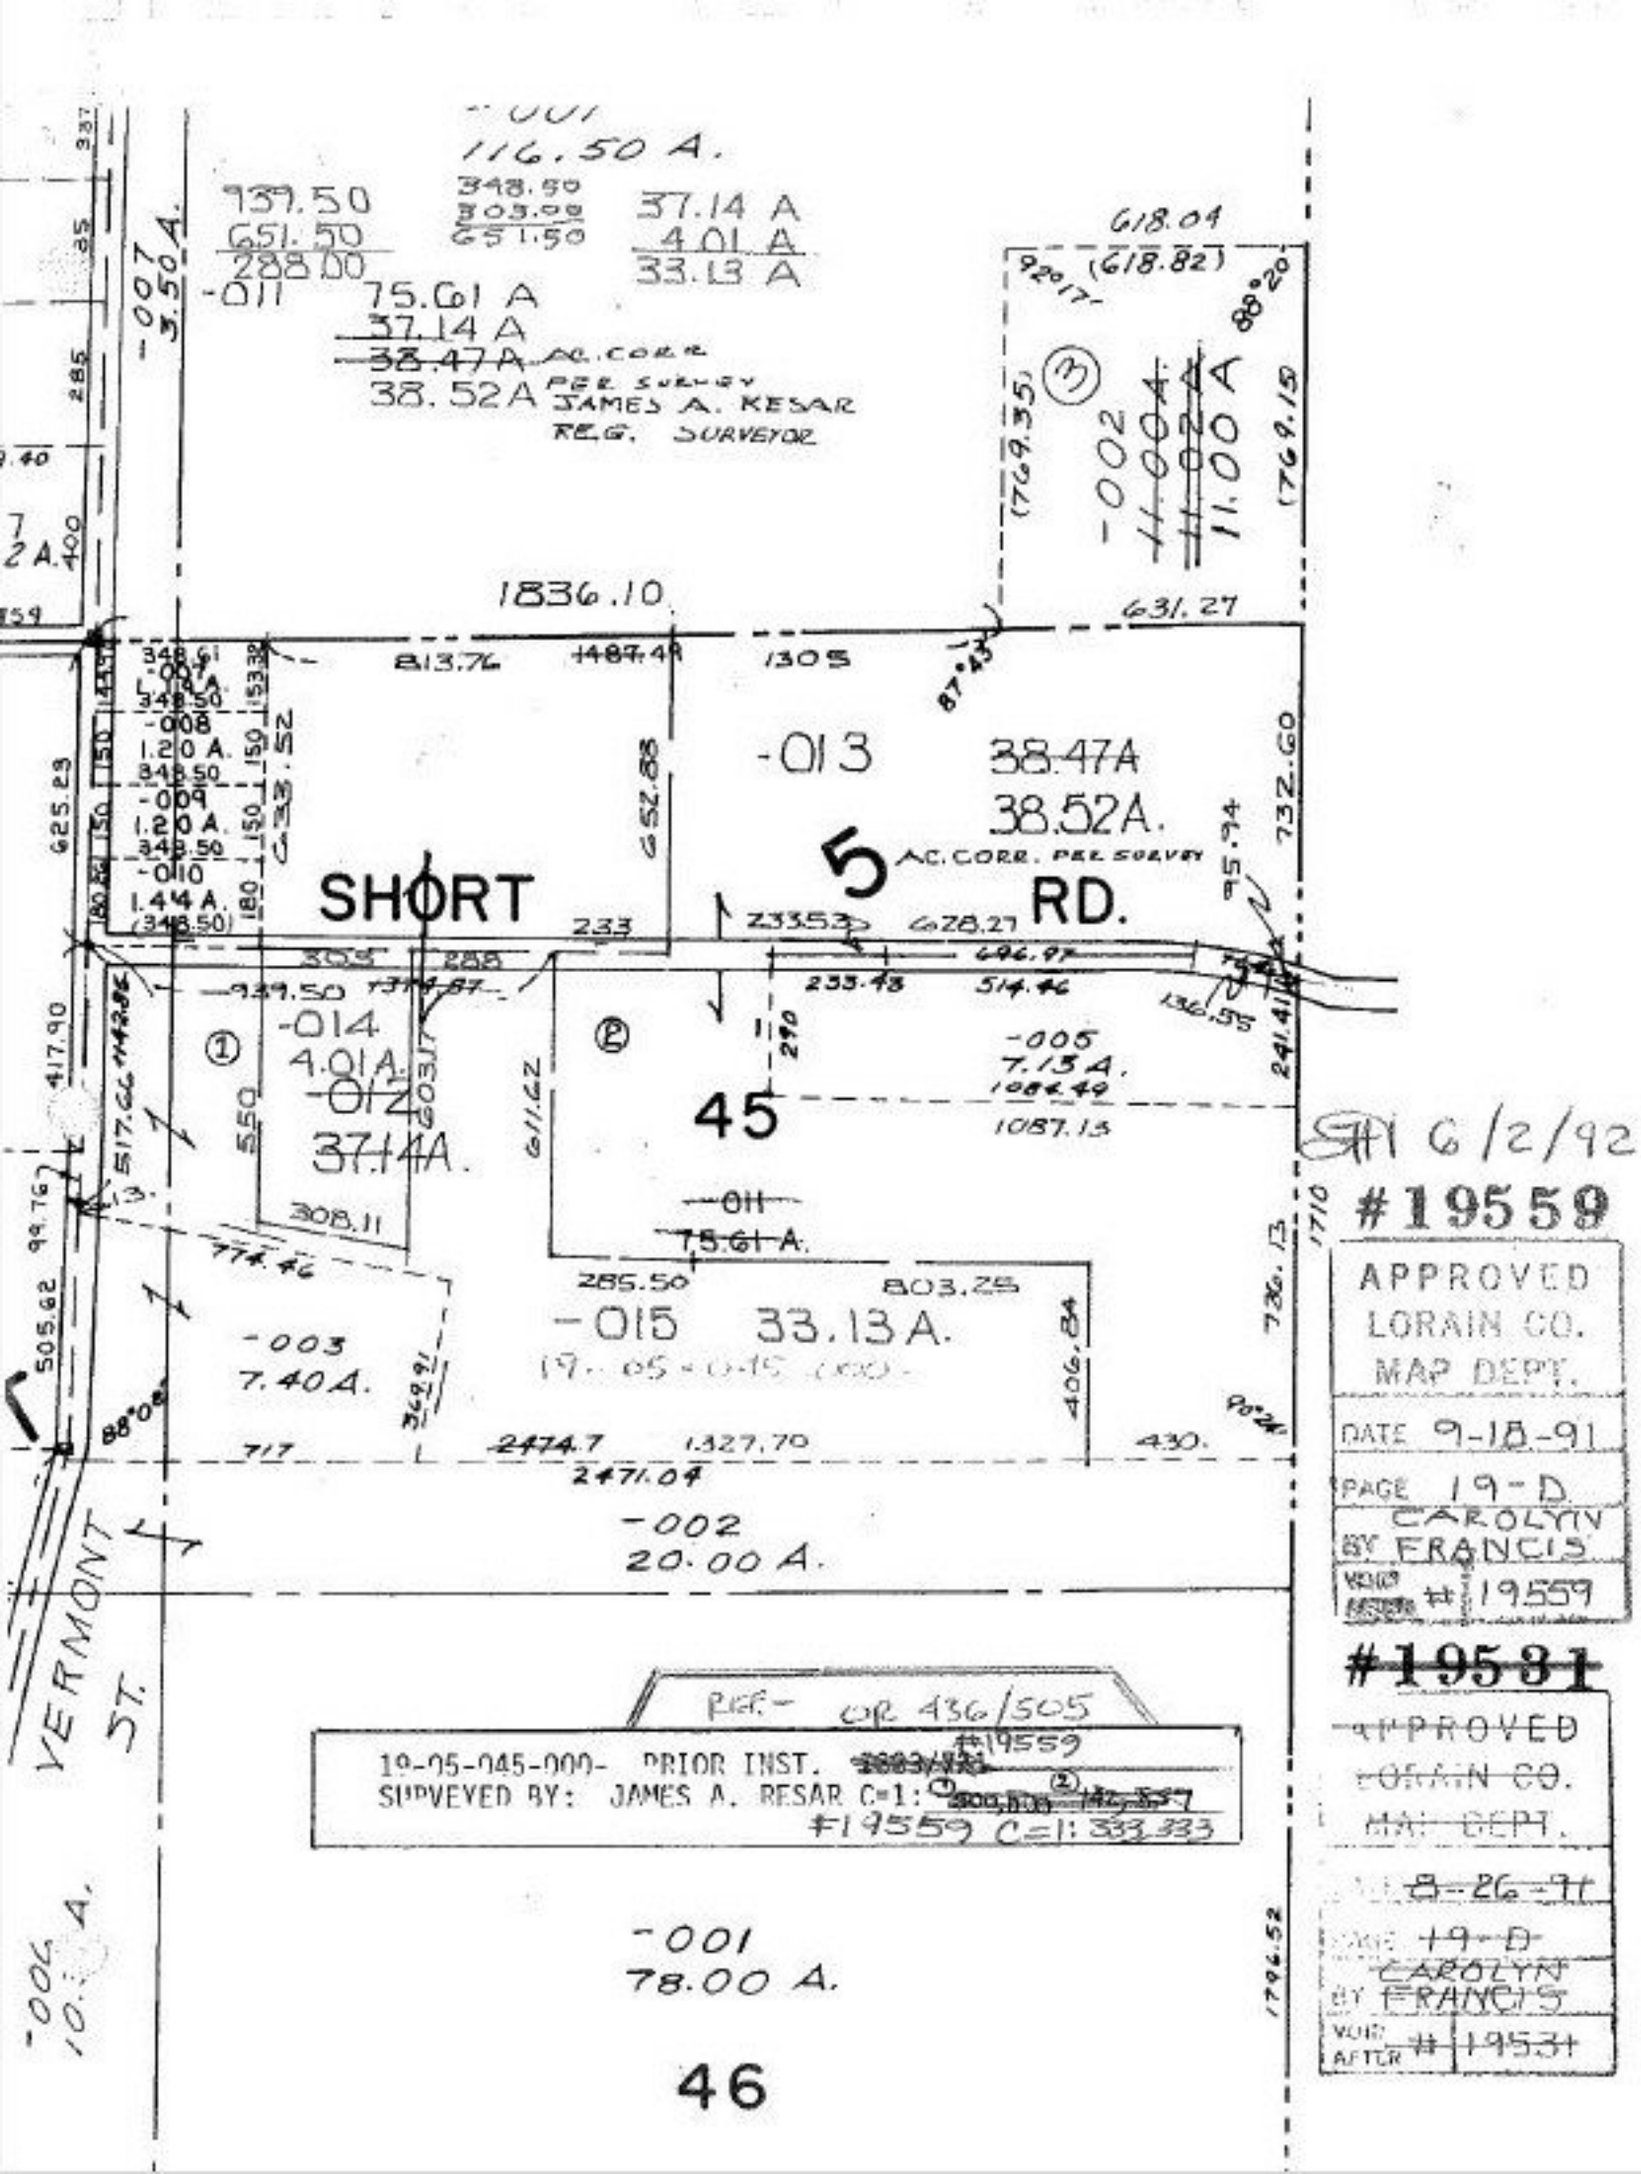
116.50 A.
348.50
803.00
651.50
937.50
651.50
288.00
-011
75.61 A
37.14 A
38.47A AC. CORR
38.52A PER SURVEY
JAMES A. RESAR
REG. SURVEYOR
37.14 A
4.01 A
33.13 A
618.04
(618.82)
(769.35)
-002
11.00A
(769.15)
1836.10
631.27
813.76
1487.48
1305
-013
38.47A
38.52A.
AC. CORR. PER SURVEY
SHORT
5
RD.
732.60
625.23
-014
4.01A.
-012
37.14A.
45
-005
7.13A.
1084.49
1087.13
-011
75.61 A.
285.50
803.25
-015 33.13A.
-003
7.40A.
2474.7
1327.70
2471.09
430.
-002
20.00 A.
VERMONT ST.
-001
78.00 A.
46
6/2/92
#19559
APPROVED
LORAIN CO.
MAP DEPT.
DATE 9-18-91
PAGE 19-D
CAROLYN
BY FRANCIS
VOID # 19559
#19581
APPROVED
LORAIN CO.
MAP DEPT.
DATE 8-26-91
PAGE 19-D
CAROLYN
BY FRANCIS
AFTER
REF- OR 436/505
#19559
19-05-045-000- PRIOR INST.
SURVEYED BY: JAMES A. RESAR C=1:
#19559 C=1: 333.333