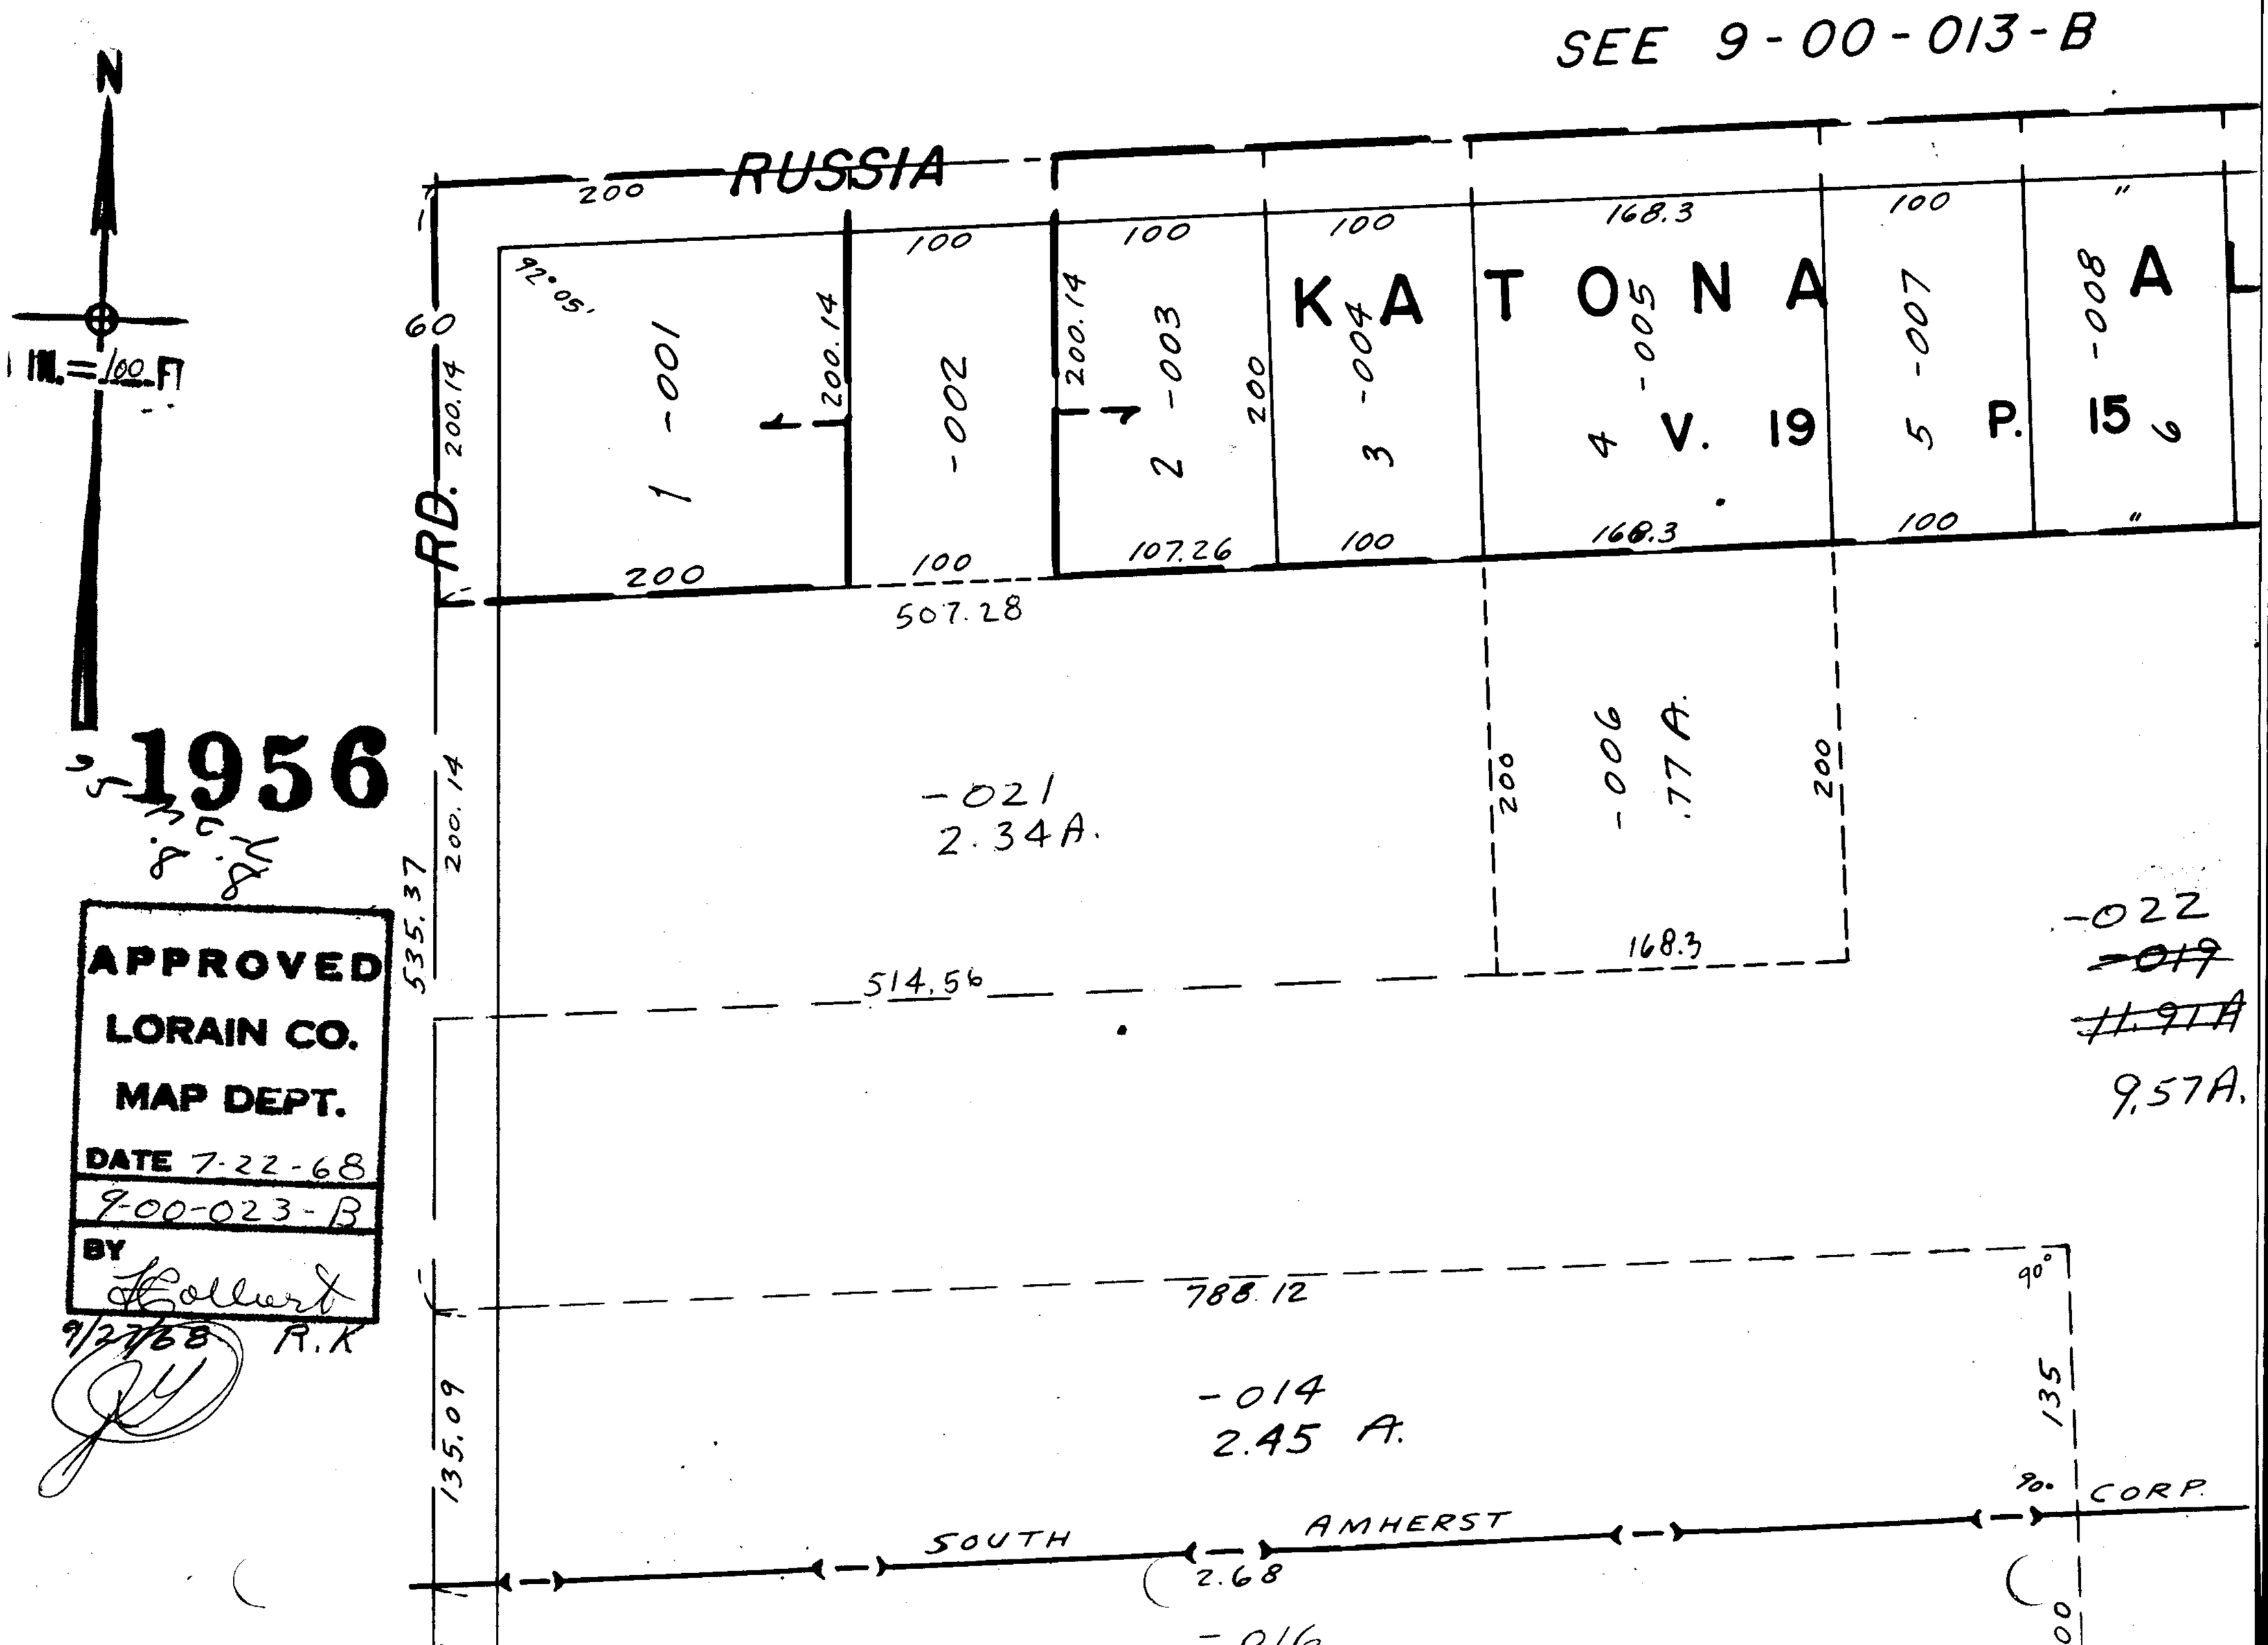

SEE 9-00-013-B
N
1 IN. = 100 FT
1956
APPROVED
LORAIN CO.
MAP DEPT.
DATE 7-22-68
9-00-023-B
BY
9/27/68 R.K
RUSSIA
RD.
KATONA
V. 19
P. 15
1 -001
-002
2 -003
3 -004
4 -005
5 -007
6 -008
-006
.77 A.
-021
2.34A.
-022
~~-019~~
~~11.91A~~
9.57A.
-014
2.45 A.
SOUTH AMHERST CORP.
92°05'
507.28
514.56
788.12
535.37
135.09
168.3
107.26
200.14