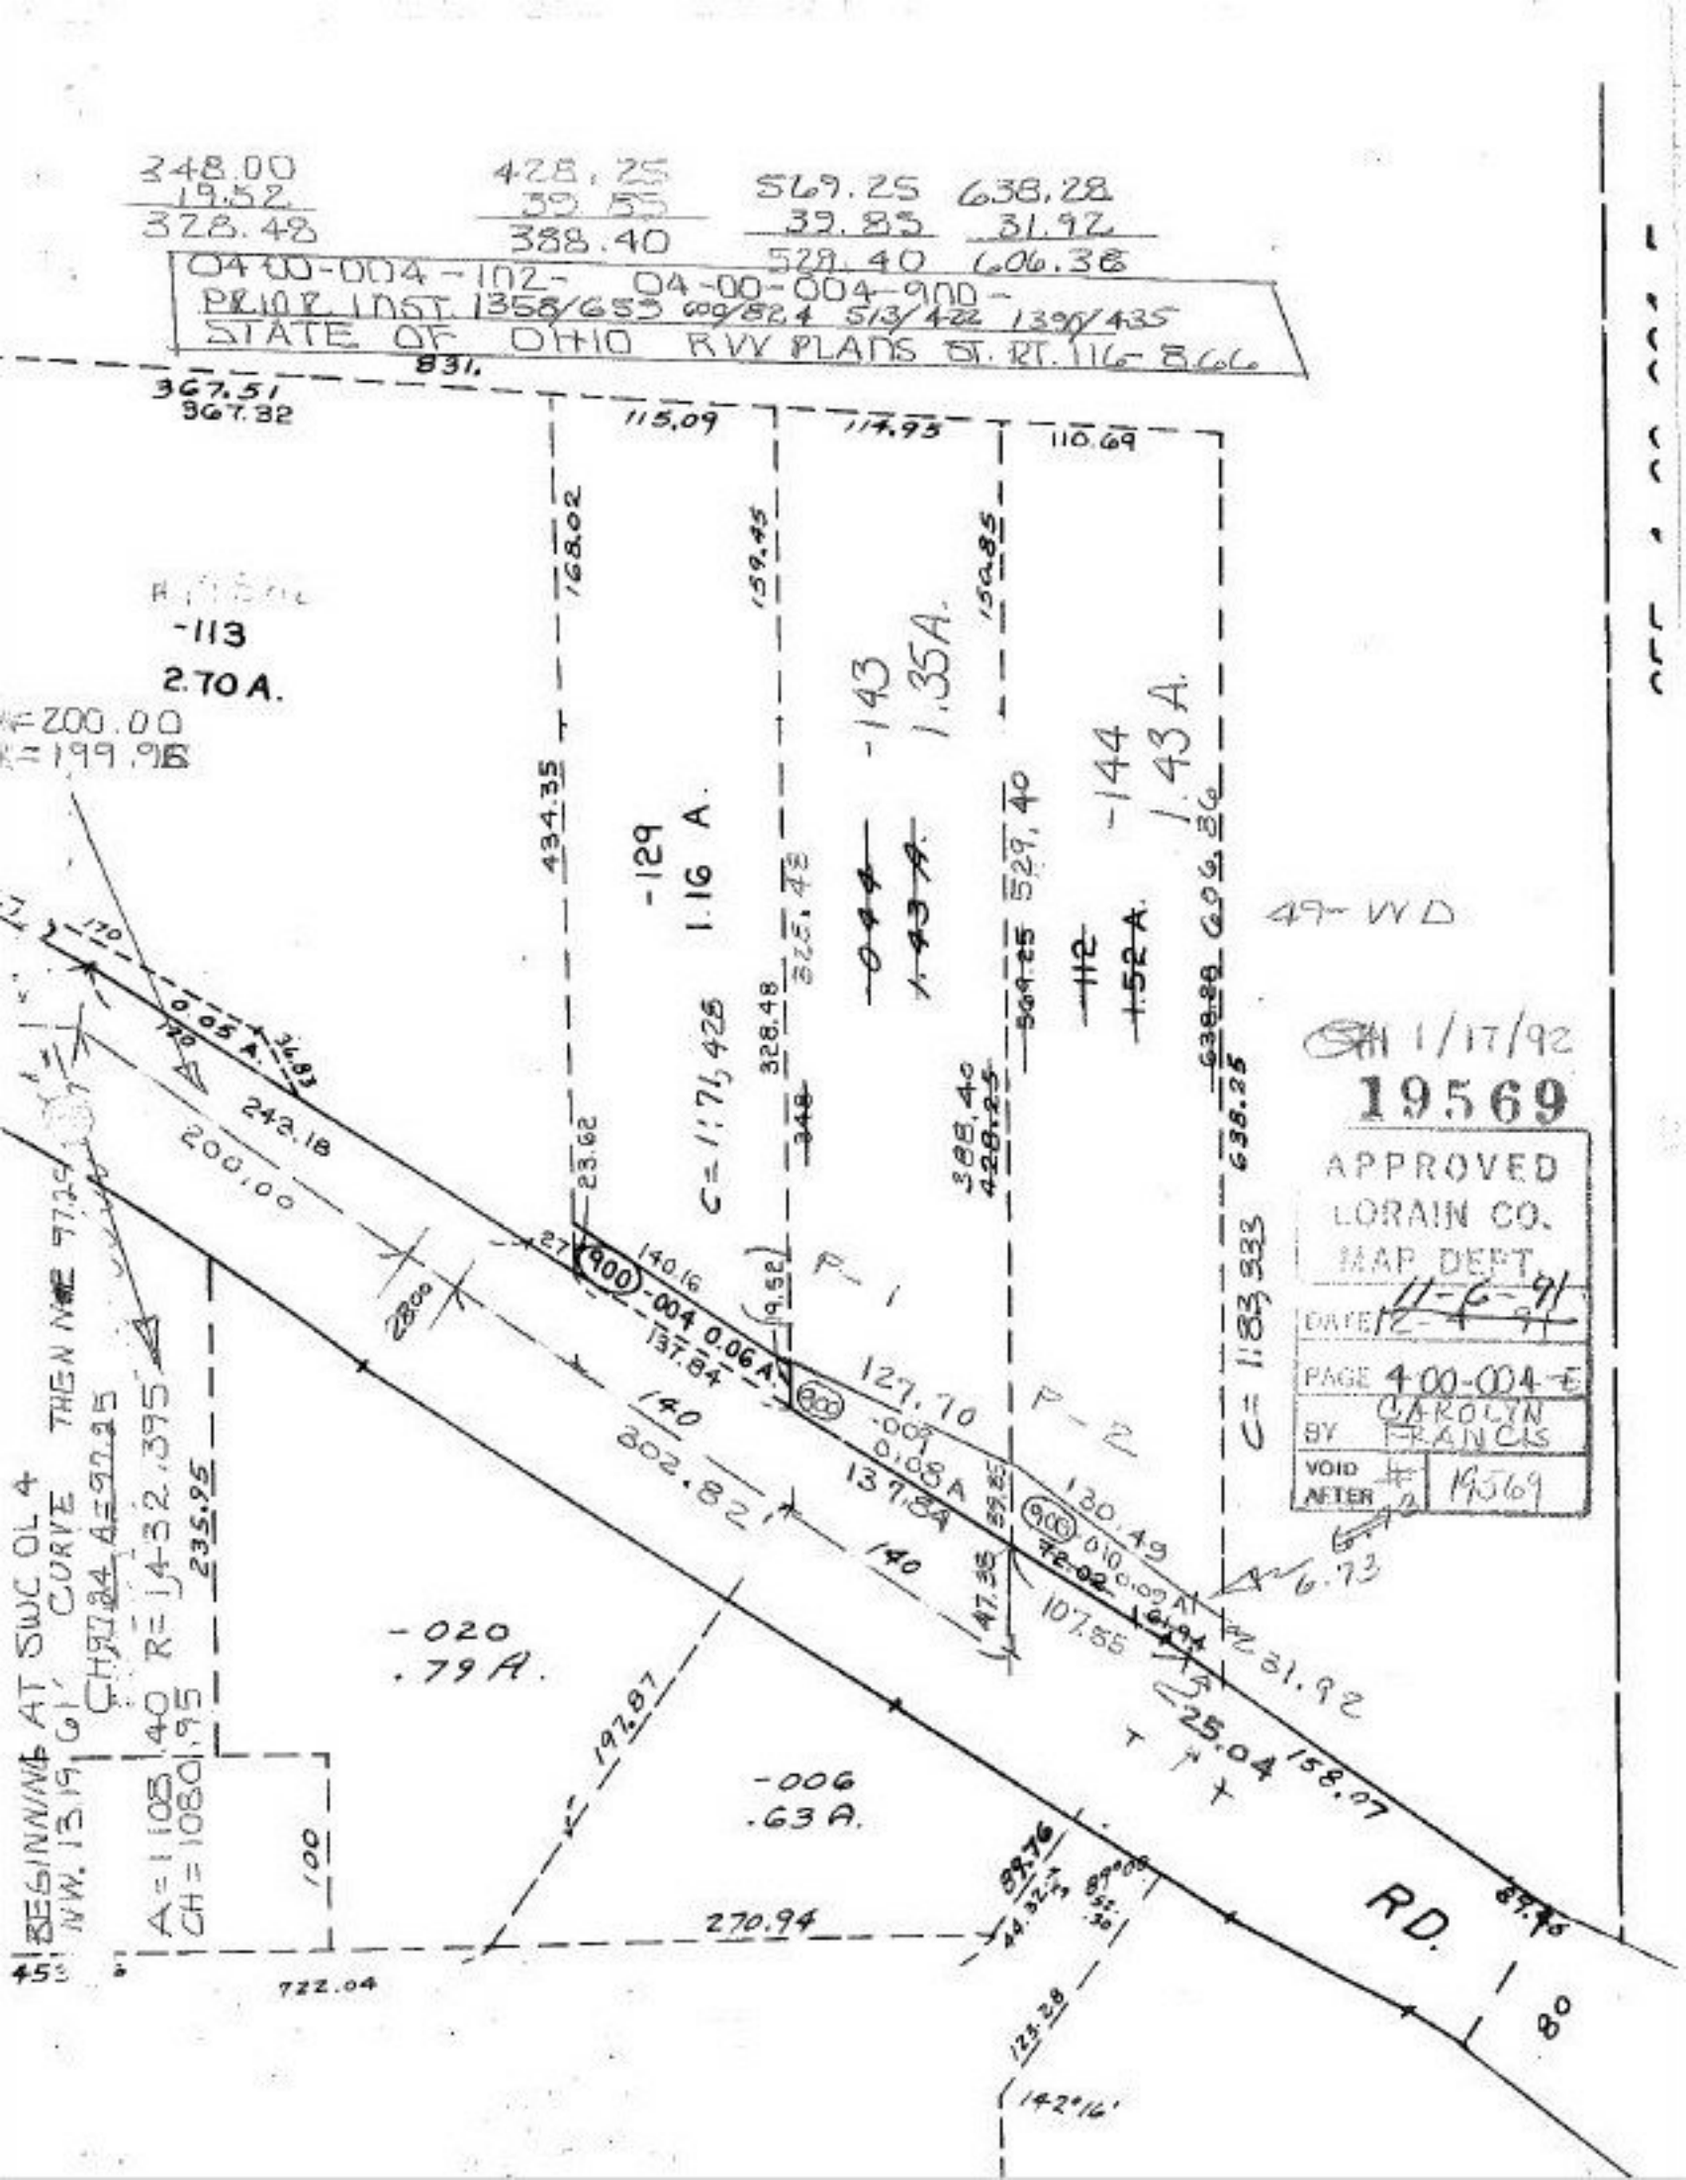
248.00
19.52
328.48
428.25
39.85
388.40
569.25
39.85
528.40
638.28
31.92
606.36
0400-004-102-
PRIOR INST. 1358/653
04-00-004-900
609/824 513/422 1390/435
STATE OF OHIO RVV PLANS ST. RT. 116-8.66
831.
367.51
367.32
115.09
114.93
110.69
168.02
159.45
154.85
434.35
-129
1.16 A.
C=1171.425
-143
1.35A.
-144
1.43 A.
49-WD
328.48
325.43
529.40
638.25
606.36
-112
1.52 A.
-113
2.70 A.
0.05 A.
242.18
200.00
140.16
137.84
0.06 A.
127.70
0.08 A.
137.84
130.49
0.10
0.09 A.
107.85
C=1183.933
638.25
1/17/92
19569
APPROVED
LORAIN CO.
MAP DEPT.
DATE 11-6-91
PAGE 400-004-E
BY CAROLYN FRANCIS
VOID AFTER #2
19569
-020
.79 A.
-006
.63 A.
270.94
192.87
235.95
BEGINNING AT SWC OL 4
NW. 13.19
CURVE
CH 324.A=90.15
A=1105.40 R=14321.395
CH=1080.95
722.04
RD.
80