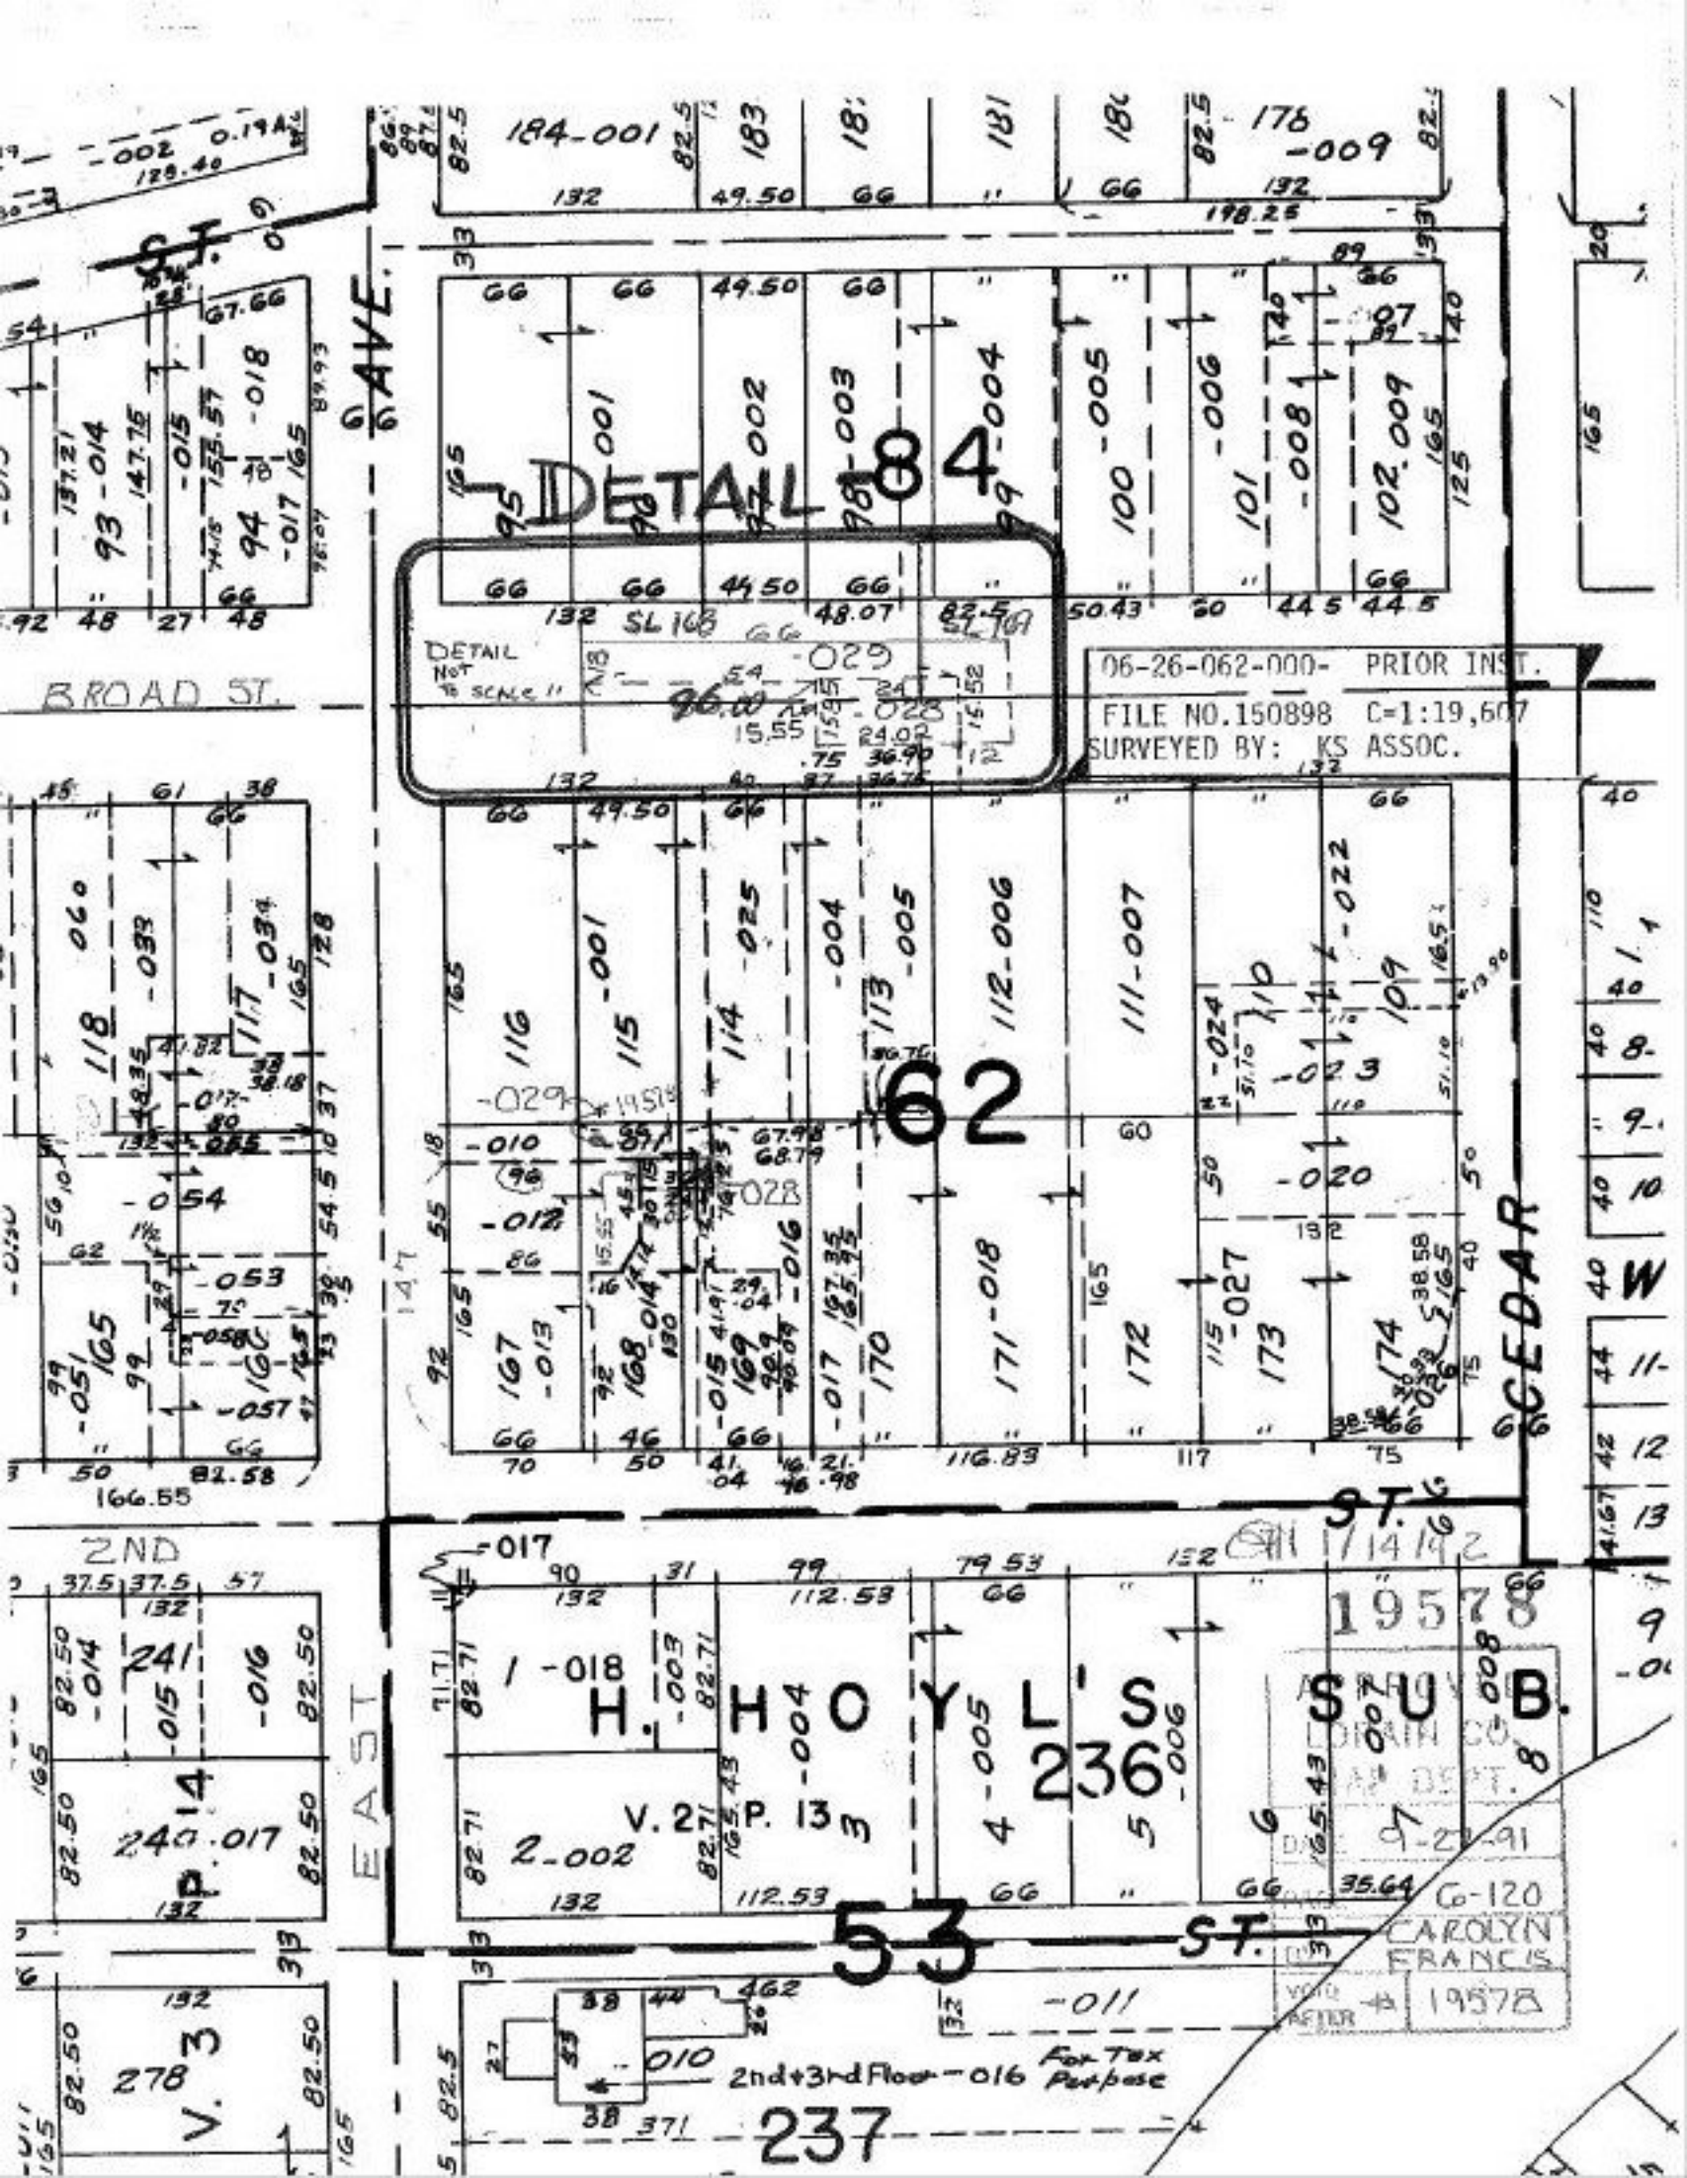

DETAIL 84
DETAIL NOT TO SCALE
06-26-062-000- PRIOR INST.
FILE NO.150898 C=1:19,607
SURVEYED BY: KS ASSOC.
BROAD ST.
CEDAR
ST.
EAST
2ND
H. HOYL'S SUB.
236
V. 2 P. 13
53
237
2nd+3rd Floor -016 For Tax Purpose
19578
APPROVED
LORAIN CO.
MAP DEPT.
DATE 9-27-91
6-120
CAROLYN FRANCIS
VOID AFTER 19578