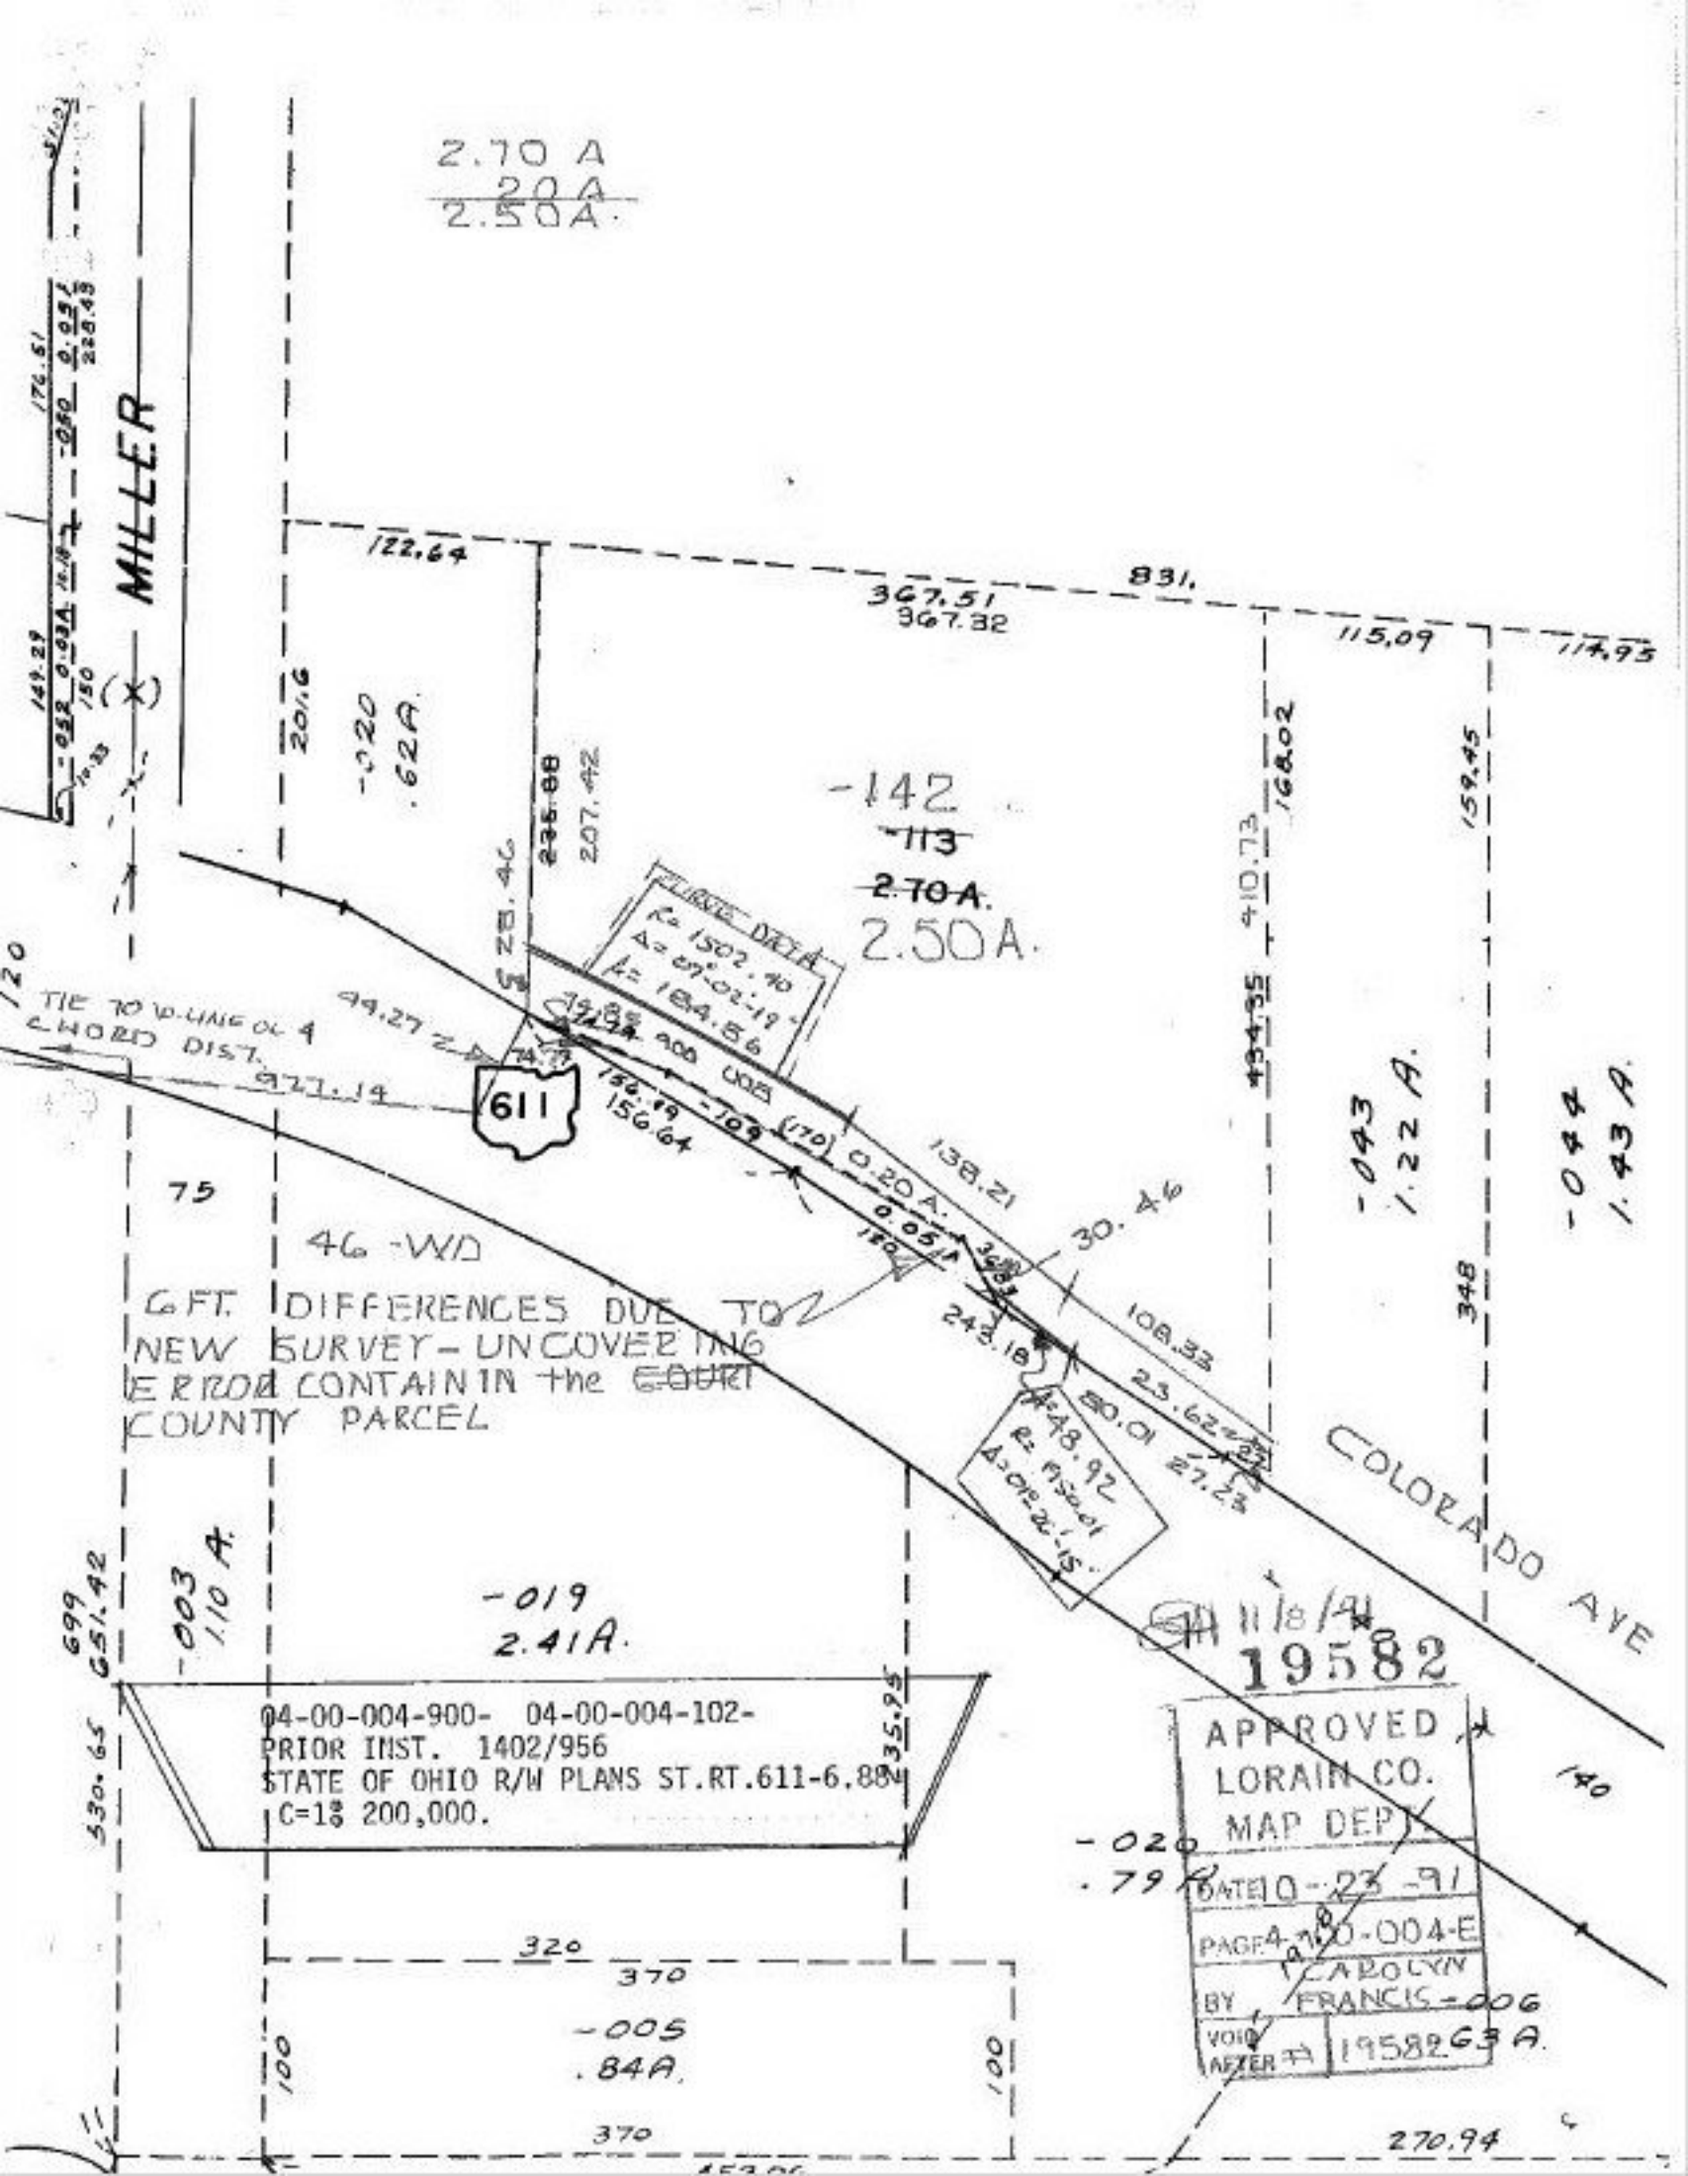
2.70 A
20A
2.50A.
MILLER
122.64
831.
367.51
367.82
115.09
114.93
20.16
-020
.62A.
-142
-113
2.70A.
2.50A.
207.42
235.88
228.46
S 28.46
410.73
168.02
134.35
159.45
TIE TO W-LINE OF 4 CHORD DIST. 971.14
99.27
611
156.64
156.19
-109
(170)
0.20 A.
0.05A
138.21
30.46
108.33
243.18
23.62
27.23
80.01
348.92
R= 1530.41
Δ=07°-26'-15"
75
46 -WD
6 FT. DIFFERENCES DUE TO NEW SURVEY - UNCOVERING ERROR CONTAIN IN the EARLIER COUNTY PARCEL
-043
1.22 A.
-044
1.43 A.
348
140
COLORADO AVE
-003
1.10 A.
699
651.42
-019
2.41A.
330.65
04-00-004-900- 04-00-004-102-
PRIOR INST. 1402/956
STATE OF OHIO R/W PLANS ST.RT.611-6.88
C=1% 200,000.
35.95
320
370
-005
.84A.
100
100
370
270.94
-020
.79A.
11/8/91
19582
APPROVED
LORAIN CO.
MAP DEPT
DATE 10-23-91
PAGE 4-00-004-E
BY CAROLYN FRANCIS-006
VOID AFTER 19582
.63 A.