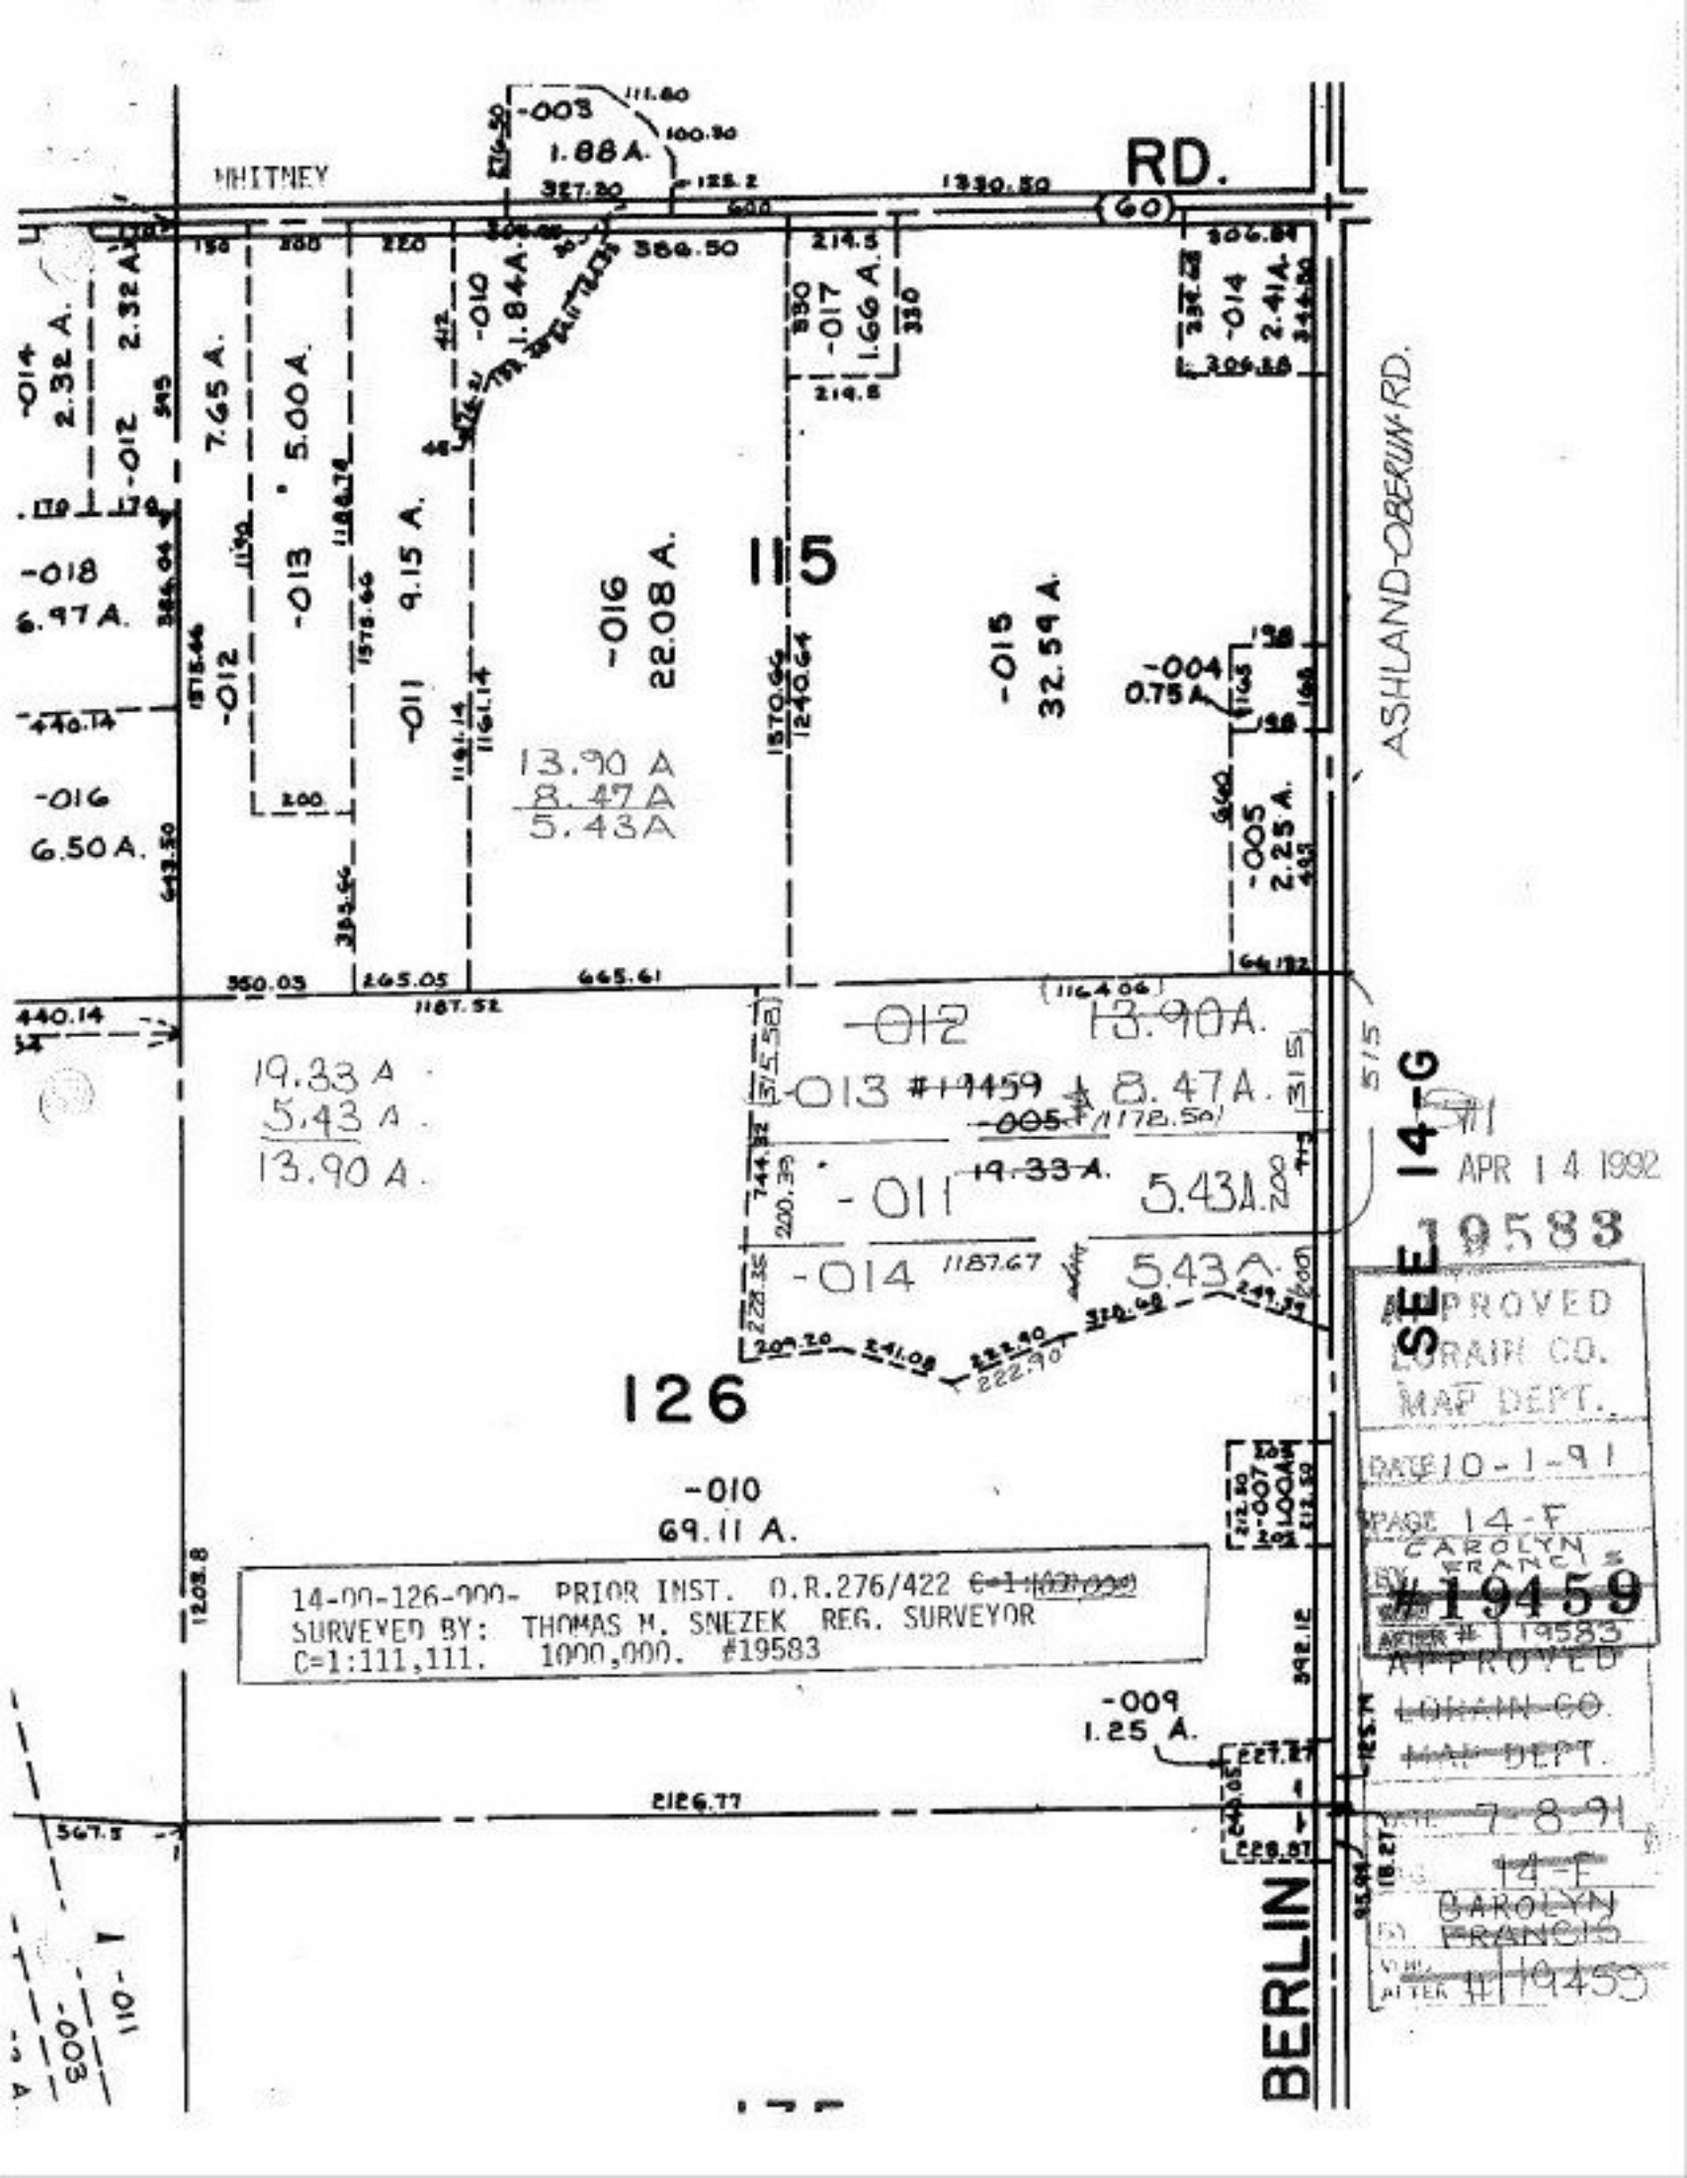
WHITNEY
RD.
60
ASHLAND-OBERLIN RD.
BERLIN
-003
1.88 A.
-014
2.32 A.
-012
7.65 A.
-013
5.00 A.
-010
1.84 A.
-011
9.15 A.
-016
22.08 A.
-017
1.66 A.
-015
32.59 A.
-004
0.75 A.
-005
2.25 A.
-018
6.97 A.
-016
6.50 A.
115
126
-009
1.25 A.
-010
69.11 A.
13.90 A
8.47 A
5.43 A
19.33 A
5.43 A
13.90 A
-012 13.90A.
-013 #19459 8.47A.
-005 (1172.50)
-011 19.33A. 5.43A.
-014 1187.67 5.43A.
14-00-126-000- PRIOR INST. O.R.276/422
SURVEYED BY: THOMAS M. SNEZEK REG. SURVEYOR
C=1:111,111. 1000,000. #19583
SEE 14-G
APR 14 1992
#19583
APPROVED
LORAIN CO.
MAP DEPT.
DATE 10-1-91
PAGE 14-F
CAROLYN FRANCIS
#19459
APPROVED
LORAIN CO.
MAP DEPT.
DATE 7-8-91
14-F
CAROLYN FRANCIS
#19459