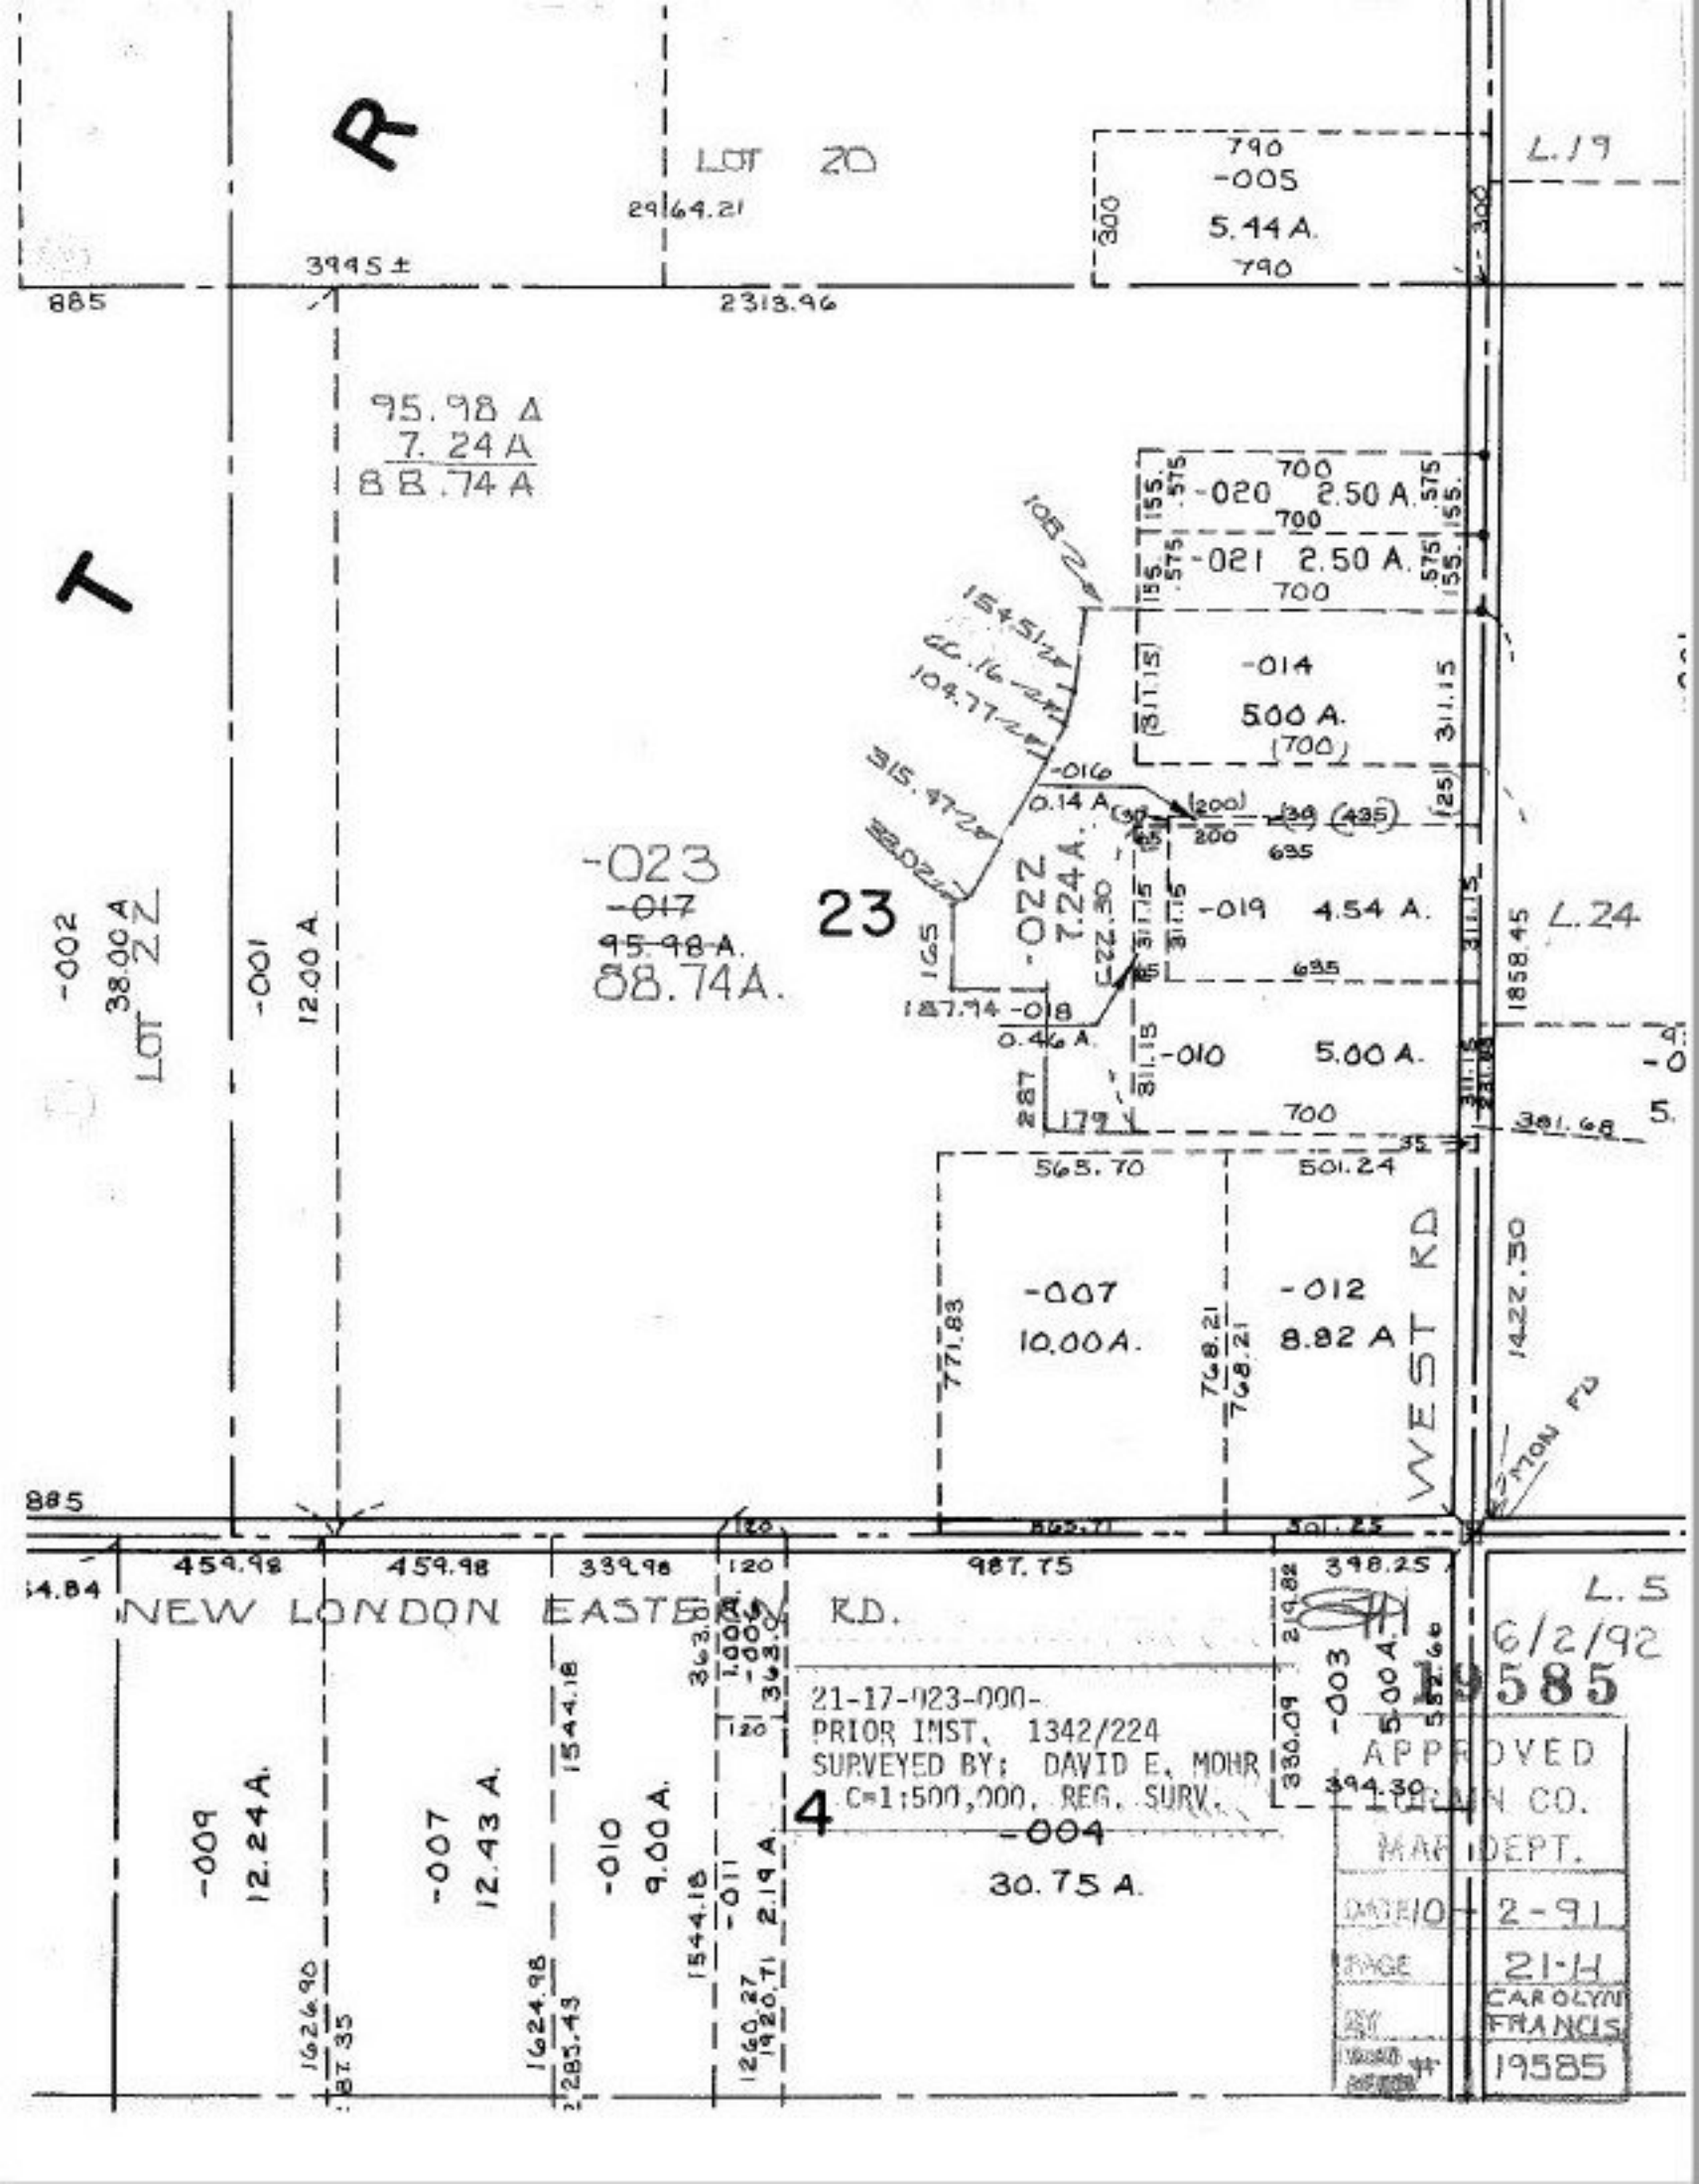
R
T
LOT 20
L.19
L.24
L.5
L.4
-005
5.44 A.
790
300
2964.21
3995±
885
2318.96
95.98 A
7.24 A
88.74 A
-020 2.50 A.
-021 2.50 A.
700
575
155.
-014
5.00 A.
(700)
311.15
-016
0.14 A.
(200)
(435)
635
-023
-017
95.98 A.
88.74A.
23
-022
7.24 A.
-019 4.54 A.
1858.45
-018
0.46 A.
-010 5.00 A.
-002
38.00 A
LOT 22
-001
12.00 A.
565.70
501.24
-007
10.00A.
-012
8.82 A
771.83
748.21
1422.30
WEST RD
885
459.98
459.98
339.98
120
987.75
398.25
NEW LONDON EASTERN RD.
-009
12.24 A.
-007
12.43 A.
-010
9.00 A.
-011
2.19 A.
-004
30.75 A.
-003
5.00 A.
21-17-023-000-
PRIOR INST. 1342/224
SURVEYED BY: DAVID E. MOHR
C=1:500,000, REG. SURV.
6/2/92
19585
APPROVED
MAP DEPT.
DATE 10-2-91
PAGE 21-H
BY CAROLYN FRANCIS
19585